



1	EN-EWC25-0	DUAL ENCLOSURE WITH 50VA POWER
1	NU-NCM350-8	NETWORK CNTRL MOD 350,8MB,ARC/ETHERNET
1	NU-NET301-0	NCU,N1 CARD F/ NCM350,ETHERNET,PREFCONF

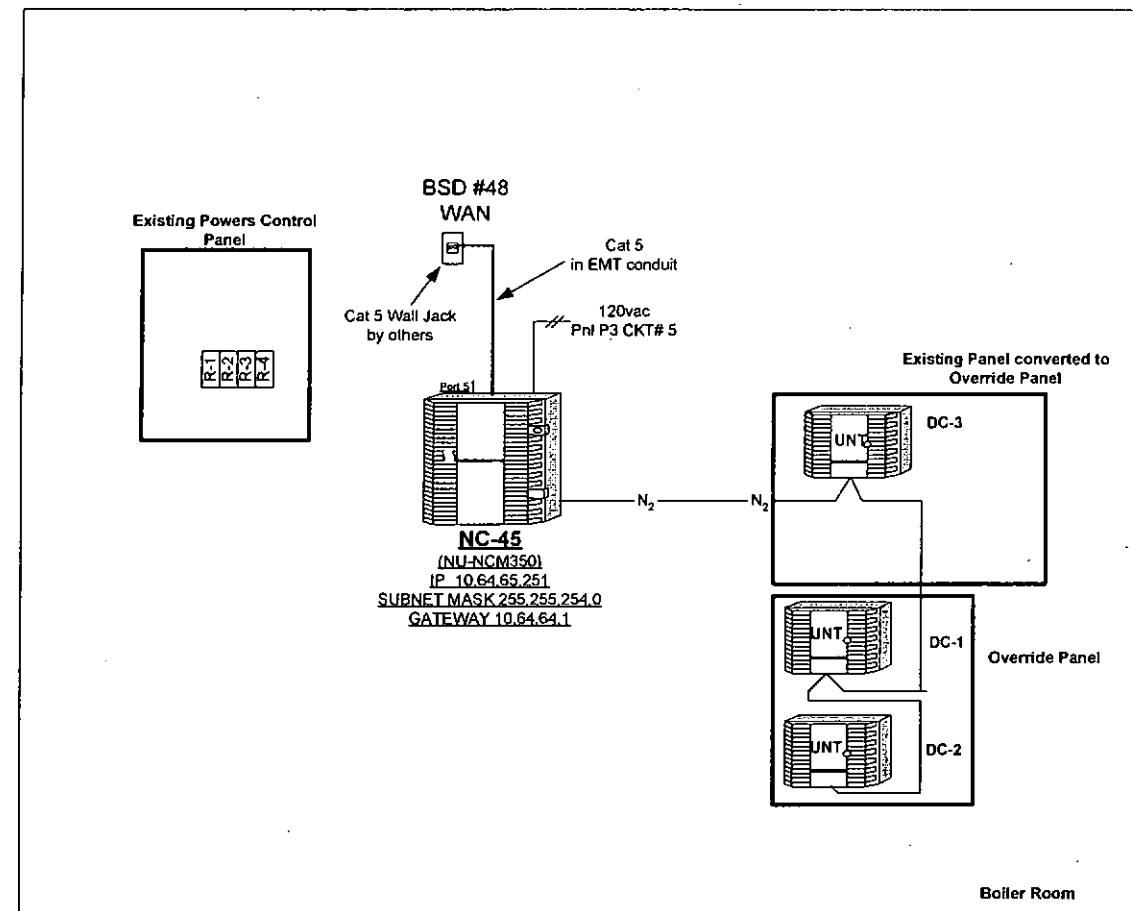


Wire Type Legend			REVISION INFORMATION	Drawing Title						
— Fibre Optic —	N1 Trunk - Fiber Optic	General Instrument R-002-ZC-6F-00	NUMBER 0	Network Riser NC-45						
— Coax —	N1 Arcnet Trunk - Coax	RG62A/U Coax, shielded, plenum	DATE 04/01/04	Hetion Elementary School						
— Coax —	N1 Ethernet Trunk - Coax	RG58A/U Coax, shielded, plenum	TIME 11:35 AM	Project Title						
— UTP —	N1 Ethernet Trunk - UTP	CAT5, unshielded, 4 pair, 24 AWG, plenum	SLW 0	Beaverton SD Retrofit Projects						
— N ₂ —	N2 Trunk -RS485	18/3 twisted, shielded, plenum, blue jacket	FILE NAME NR-21C-1.rxd							
— XT Bus —	XT Bus	18/3 twisted, shielded, plenum, blue jacket								

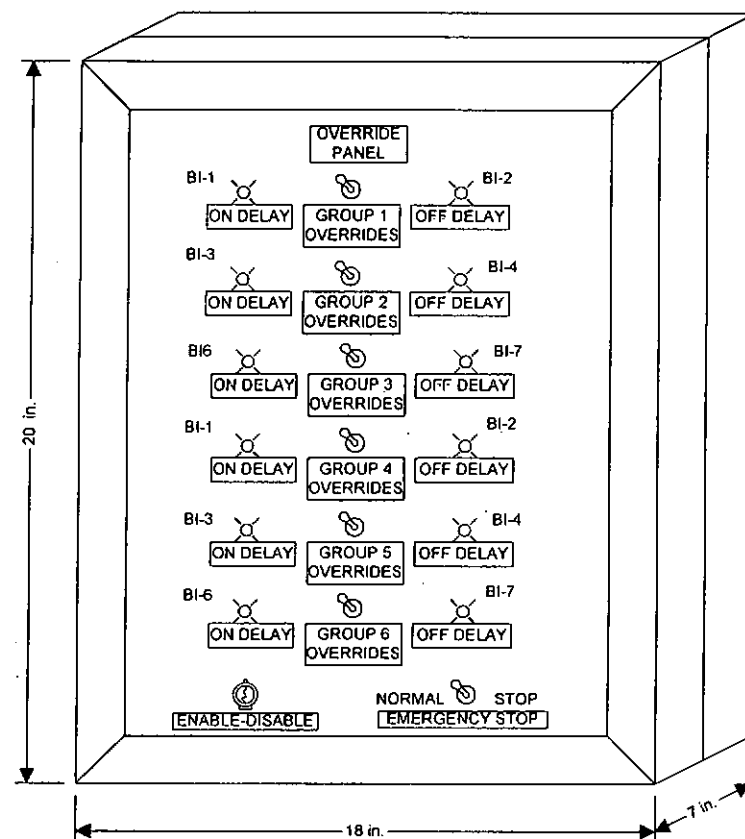

PANEL FACE DETAIL

DPDT Momentary Switch,
Spring return to center

Key Operated Switch,
2-Position

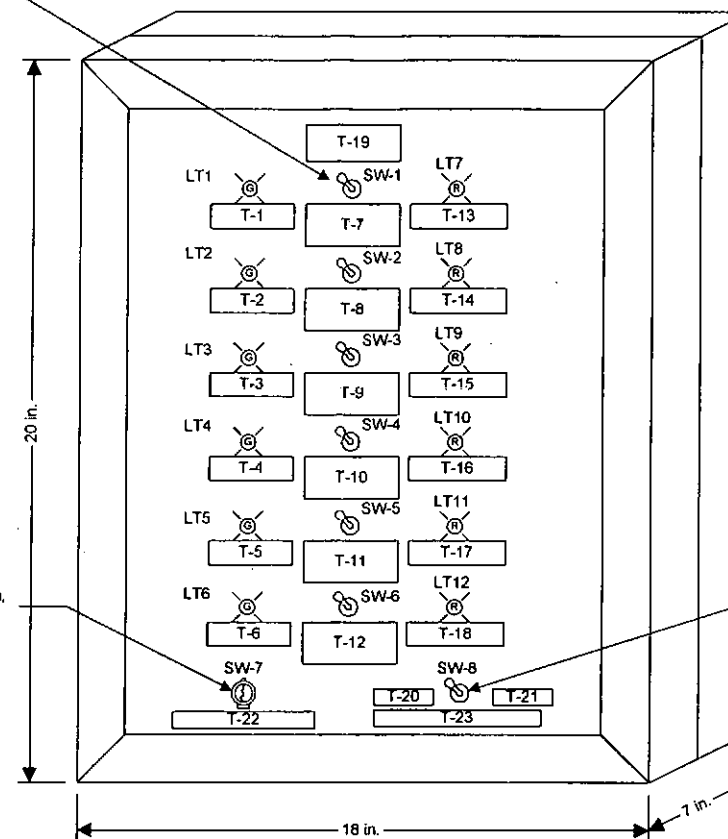

PANEL FACE DEVICE LAYOUT

BILL OF MATERIALS

Panel Devices:

Designation	Qty	Part Number	Description
T-1-23	23	TAGS	PNEOLIC TAGS, KELE

Panel Tag Schedule

Tag #	Tag Description	Tag Size	Color
T-1 thru T-6	ON DELAY	3"W x 1"H	Black Tag, White Letters
T-7	GROUP 1 OVERRIDES	3"W x 1"H	Black Tag, White Letters
T-8	GROUP 2 OVERRIDES	3"W x 1"H	Black Tag, White Letters
T-9	GROUP 3 OVERRIDES	3"W x 1"H	Black Tag, White Letters
T-10	GROUP 4 OVERRIDES	3"W x 1"H	Black Tag, White Letters
T-11	GROUP 5 OVERRIDES	3"W x 1"H	Black Tag, White Letters
T-12	GROUP 6 OVERRIDES	3"W x 1"H	Black Tag, White Letters
T-13 thru T-18	OFF DELAY	3"W x 1"H	Black Tag, White Letters
T-19	OVERRIDE PANEL	3"W x 1"H	Black Tag, White Letters
T-20	NORMAL	3"W x 1"H	Black Tag, White Letters
T-21	STOP	3"W x 1"H	Black Tag, White Letters
T-22	EMERGENCY STOP	3"W x 1"H	Red Tag, White Letters
T-23	ENABLE -DISABLE	3"W x 1"H	Black Tag, White Letters

SEQUENCE OF OPERATION

All Air Handlers, RTU's and Unit Ventilators can be assigned to a group. The group number is the same as the group as labeled on the panel. When the switch is toggled to "ON", the assigned units in that group will start. The units will keep running until an adjustable time delay is completed, after which the units revert back to the normal automatic mode. When the switch is toggled to "OFF", the assigned units in that group will stop. The units will stop running until an adjustable time delay is completed, after which the units revert back to the normal automatic mode. There is a separate adjustable time delay for each group that is used for both the ON and OFF delays. Green and red pilot lights indicate the ON or OFF status of each group.

The lights can be switched to "ON" or "OFF" and respected pilot light indicates the ON or OFF Status of the group.

When a unit is started, heating or cooling systems will start as required. VAV's, EF's, UH's and other miscellaneous items are not assignable to a group number.

The key operated **ENABLE-DISABLE** switch allows panel to function.

The **EMERGENCY STOP** switch shuts down all HVAC systems controlled by Metasys.

REVISION INFORMATION	Drawing Title				
NUMBER	Override Panel Layout				
0					
DATE	Hiteon Elementary School				
04/01/04					
TIME	Project Title				
11:36 AM	Beaverton SD Retrofit Projects				
SLW					
0					
FILE NAME					
OP-21C-1.vsd					
		ASBUILTS		3/9/04	MKH
		REFERENCE DRAWING			
		NO.			
		Sales Engineer		Project Manager	
		KRM McKay		Mark Harris	
		Application Engineer		BY	
		MWB		DATE 05/30/2003	
		Branch Information		CONTRACT NUMBER	
		4011 S.E. International Way		3084-0070	
		Suite 805		DRAWING NUMBER	
		Milwaukee		OP-21C-1	
		OR 97222			
		Phone: 503-305-2000			
		Fax: 503-305-1158			
		JOHNSON CONTROLS			
		Systems & Services Division			

The diagram illustrates the wiring for the DC-1 control unit. It shows the internal components and their connections to various inputs and outputs.

Top Connections:

- Limit switches: LT9, LT3, LT8, LT2, LT7, LT1
- 24 Vac
- Comm




Internal Components:

- DC-1** (Main Unit)
- Factory Jumper** (W55, W56)
- N2 ADDRESS DIP SWITCH** (OFF, ON)
- AI DIP SWITCHES** (Temp, 2V, 10V)
- SW1 SW2** (On, Off)

Inputs and Outputs:

- AI 1-6** (AI 1-3 are AICM, AI 4-6 are AICM)
- +15 VDC**
- +15 VDC**
- COM**
- Z Bus**
- BI SRC**
- BI 1-7** (BI 1-4 are BI SRC, BI 5-7 are BI SRC)
- SW-1A** through **SW-3B**


Note: BI 5 is INTERNAL

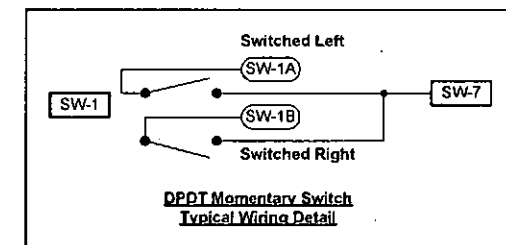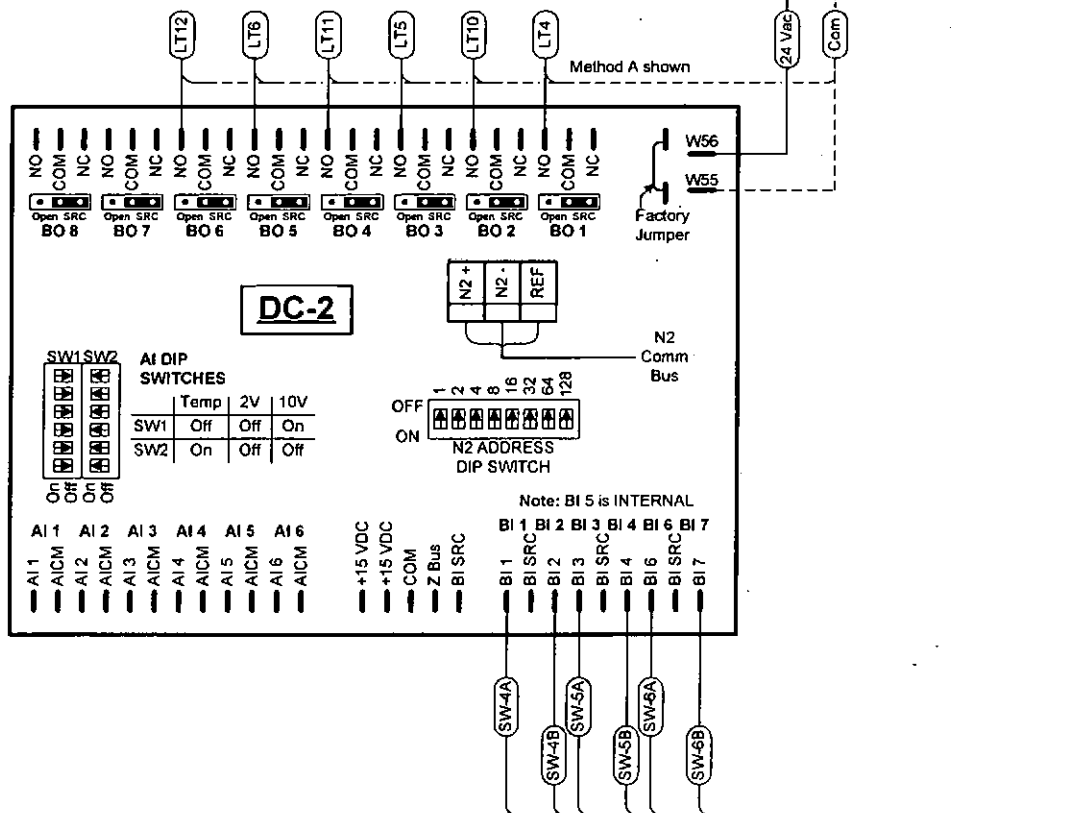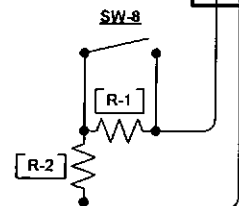


<u>Designation</u>	<u>Qty</u>	<u>Part Number</u>	<u>Description</u>
Panel Devices:			
DC-1,2	2	AS-UNT1108-0	CNTRLR,DIG,UNT,6AI,6BI,0AO,8BO
LT1-LT-12	12	24PSB5	LAMP 24VAC -- KELE
	12	L4017	LAMP SOCKET, 11/16" DIA --KELE
LT1-LT6	6	L4029	FLAT LENS GREEN -- KELE
LT7-LT12	6	L4025	FLAT LENS RED --- KELE
MS-1	1	PRK-S	PANEL RECEPTACLE & DISCONNECT SW --KELE
PANEL	1	RET2018-PB	20x18x7 NEMA 1/Subpanel,pwdr blue--KELE
R-1	1	R100	100 OHM RESISTOR, 1/4 W
R-2	1	R1000	1000 OHM RESISTOR 1/4W
SW-1-7	6	4X203	TOGL,SW,3-POS,DPDT,MOM- GRANGER
SW-7	1	HWIK-2AF10	KEY SW, 2-POS, 1-NO, -- IDEC
SW-8	1	23F341	SPST, TOGGLE SW --KELE
TX-1	1	691-U100	XFMR, 120/24V, 92VA, --KELE

The diagram shows a 2U rackmount server. It has two drive bays on the left, labeled **DC-1** and **DC-2**. On the right side, there are two expansion slots, labeled **MS-1** and **TX-1**.

REVISION INFORMATION	Drawing Title																		
NUMBER	Override Panel Wiring Details																		
0						ASBUILTS				3/9/04 MKH									
DATE																			
04/01/04	Hiteon Elementary School	REFERENCE DRAWING				NO.				REVISION-LOCATION				ECN		DATE		BY	
		Sales Engineer		Project Manager		Application Engineer		DRAWN		APPROVED									
				Kim McKay		Mark Harris													
								BY MWB DATE 05/30/2003		BY MWB DATE 05/30/2003									
TIME	Project Title													CONTRACT NUMBER					
11:36 AM	Beaverton SD Retrofit Projects													3084-0070					
SLW														DRAWING NUMBER					
0														OP-21C-2					
FILE NAME																			
OP-21C-2.rxd																			

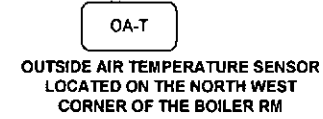


**THEY SERVE THE VENTS, BLDG 300/KITCHEN,
BLDG 100/ADMIN, BLDG 200**

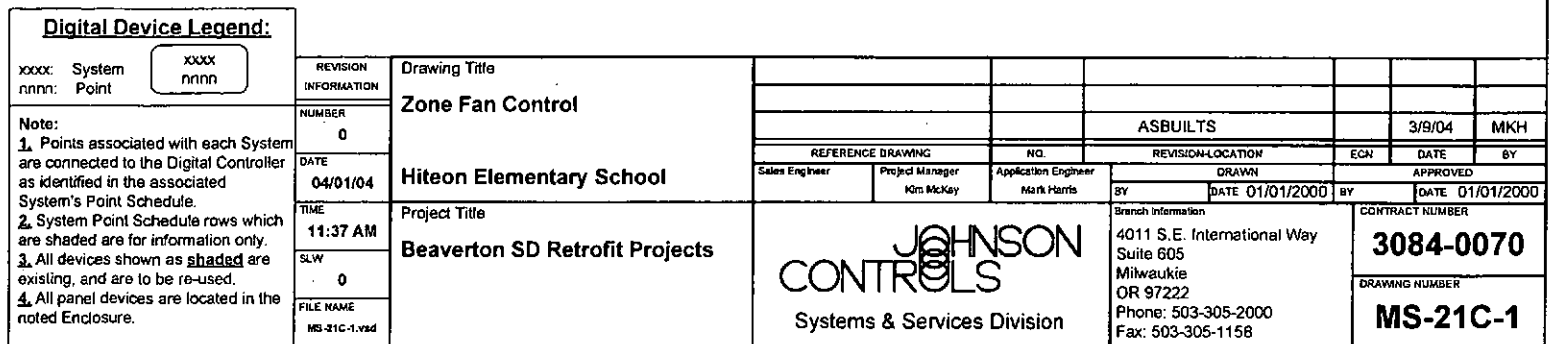




**JOHNSON
CONTROLS**
Systems & Services Division

Branch Information
4011 S.E. International Way
Suite 605
Milwaukie
OR 97222
Phone: 503-305-2000
Fax: 503-305-1158

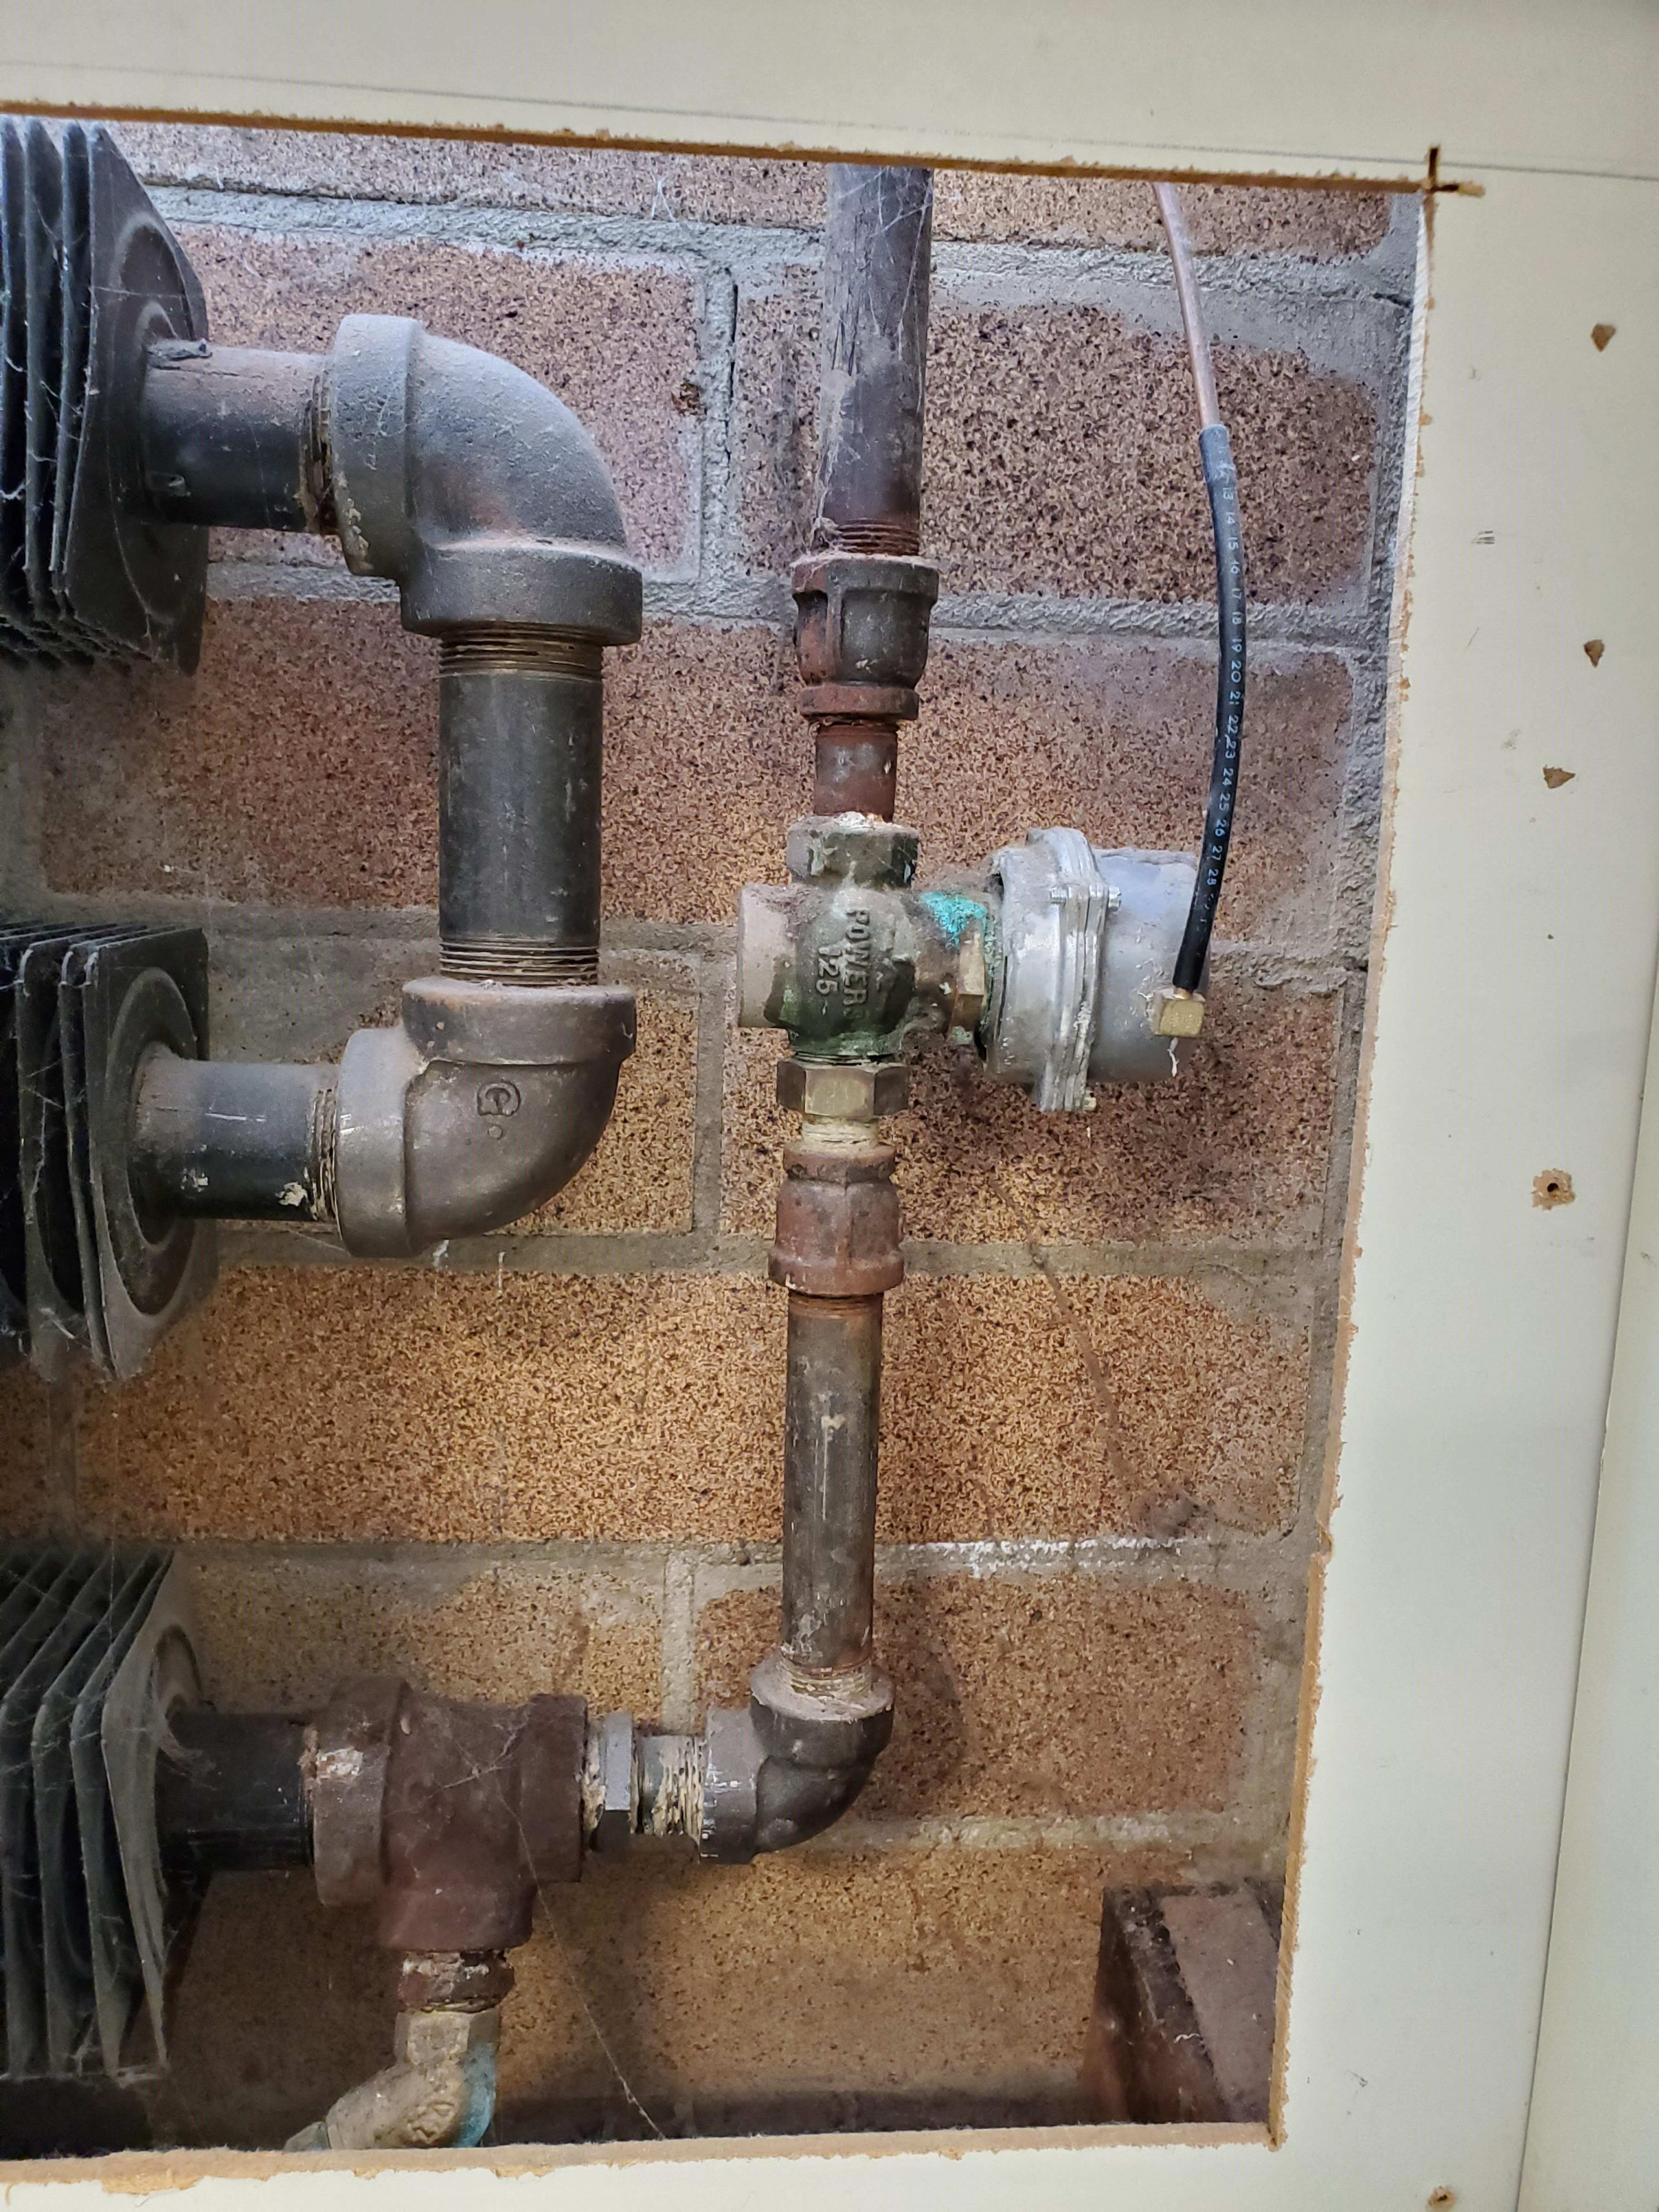

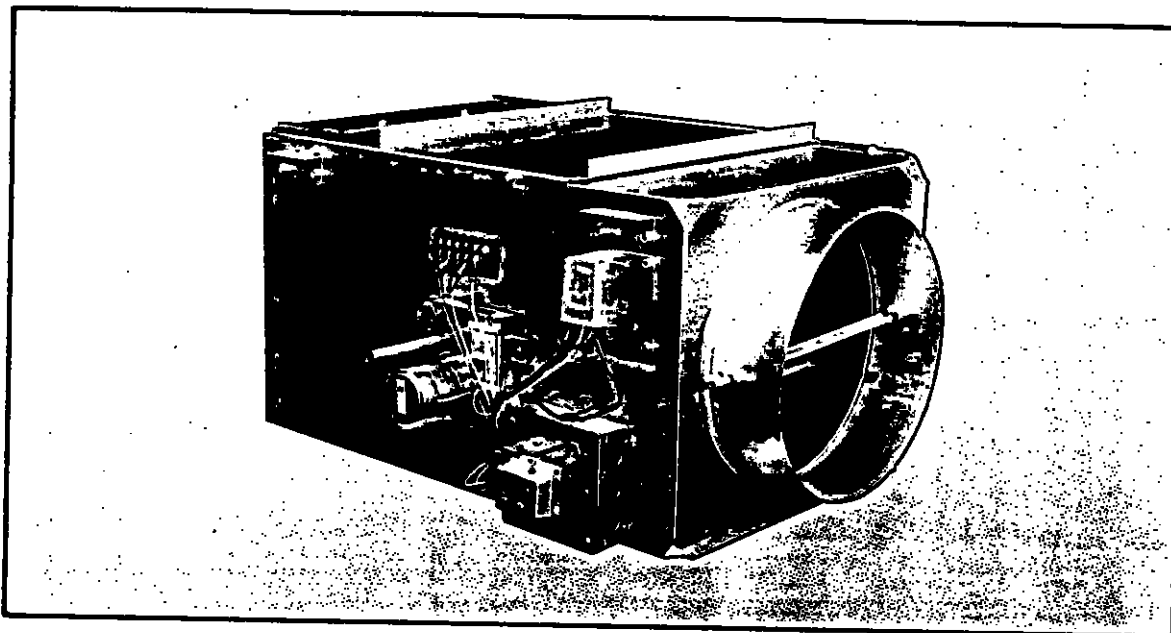

The **Carnes Model ABBB**, by-pass unit, provides pressure dependent variable air volume to individual zones while by-passing the unneeded air to the ceiling plenum for recirculation.

Although zone air volumes in small buildings may vary greatly, the cost of fan controls many times cannot be justified. Zone variable air volumes are realized with the by-pass unit while the supply fan delivers a constant CFM.

The ABBB is compatible with reverse or direct acting pneumatic thermostats or electric thermostats. Zone thermostats directly controlling the by-pass damper assures that only the air that is needed is delivered to the zone.

Downstream duct work pressure losses can be matched by adjusting an integral by-pass balancing damper.

Other Features Include:

- Air flow capacities from full shut-off to zone to 3,200 CFM.
- Pneumatic, electric or manual damper control.
- Low pressure drop.
- Low sound levels.
- Thermally and acoustically insulated casing.
- Open-end discharge provided with S and drive connection for easy installation.
- Optional multi-discharge adaptors have round outlet connections with integral balancing dampers.
- Balancing damper in by-pass is standard.
- Air flow sensor at inlet is standard.
- Optional hanger brackets.
- Optional controls enclosure for electric controls.
- Optional foil coated insulation (hospital, laboratory, etc. applications).

Available Modules:

- Basic control unit—Model ABBB.
- Multi-discharge adaptor—Model AXMA (See Section 5—Accessories).

SOUND DATA


CFM	ΔP_s	Sound Power db Octave Band						Max. Disc. NC	Radiated NC
		2	3	4	5	6	7		
SIZE 02									
80	0.07	—	31	23	—	—	—	—	—
120	0.14	—	41	35	29	—	—	—	—
160	0.23	51	49	42	36	30	—	26	—
200	0.36	56	54	47	42	36	31	33	24
SIZE 04									
160	0.05	—	—	21	—	—	—	—	—
240	0.12	—	41	34	28	21	—	—	—
320	0.21	51	48	41	36	31	26	25	24
400	0.32	56	53	47	42	37	33	32	30
SIZE 06									
240	0.04	—	32	22	—	—	—	—	—
360	0.10	—	40	32	27	—	—	—	—
480	0.16	49	47	40	34	29	—	24	21
600	0.25	54	52	46	40	36	31	31	26
SIZE 08									
320	0.03	—	—	—	—	—	—	—	—
480	0.07	—	37	29	22	—	—	—	—
640	0.13	47	45	37	31	27	—	22	21
800	0.19	54	51	44	37	33	28	29	28

SOUND DATA


CFM	ΔP_s	Sound Power db Octave Band						Max. Disc. NC	Radiated NC
		2	3	4	5	6	7		
SIZE 12									
480	0.03	—	31	21	—	—	—	—	—
720	0.06	—	38	31	29	22	—	—	—
960	0.11	48	45	38	34	29	—	22	23
1200	0.17	55	52	45	39	35	30	31	29
SIZE 16									
640	0.03	—	30	23	20	—	—	—	—
960	0.06	—	39	32	27	21	—	—	—
1280	0.12	52	47	40	35	30	—	24	22
1600	0.18	56	53	47	41	36	31	32	29
SIZE 24									
960	0.04	—	35	31	21	—	—	—	—
1440	0.10	48	45	41	33	30	28	25	20
1920	0.18	54	51	47	41	36	32	32	28
2400	0.28	60	58	54	47	44	42	39	35
SIZE 32									
1280	0.04	—	37	33	27	24	—	—	—
1920	0.09	51	46	41	36	31	27	25	21
2560	0.15	57	54	48	44	39	34	33	29
3200	0.22	61	59	53	47	44	38	38	36

- OPEN END NOTES**
1. ΔP_s Static pressure difference from inlet to discharge.
 2. Radiated NC is based on sound emanating from the casing with room absorption (10db) and ceiling plenum absorption and transmission loss (10db).
 3. Dash (—) indicates sound power db or NC level less than 20.
 4. All values of NC include 10 db room absorption.


MODEL NUMBERING SYSTEM—Model ABBB Control Unit

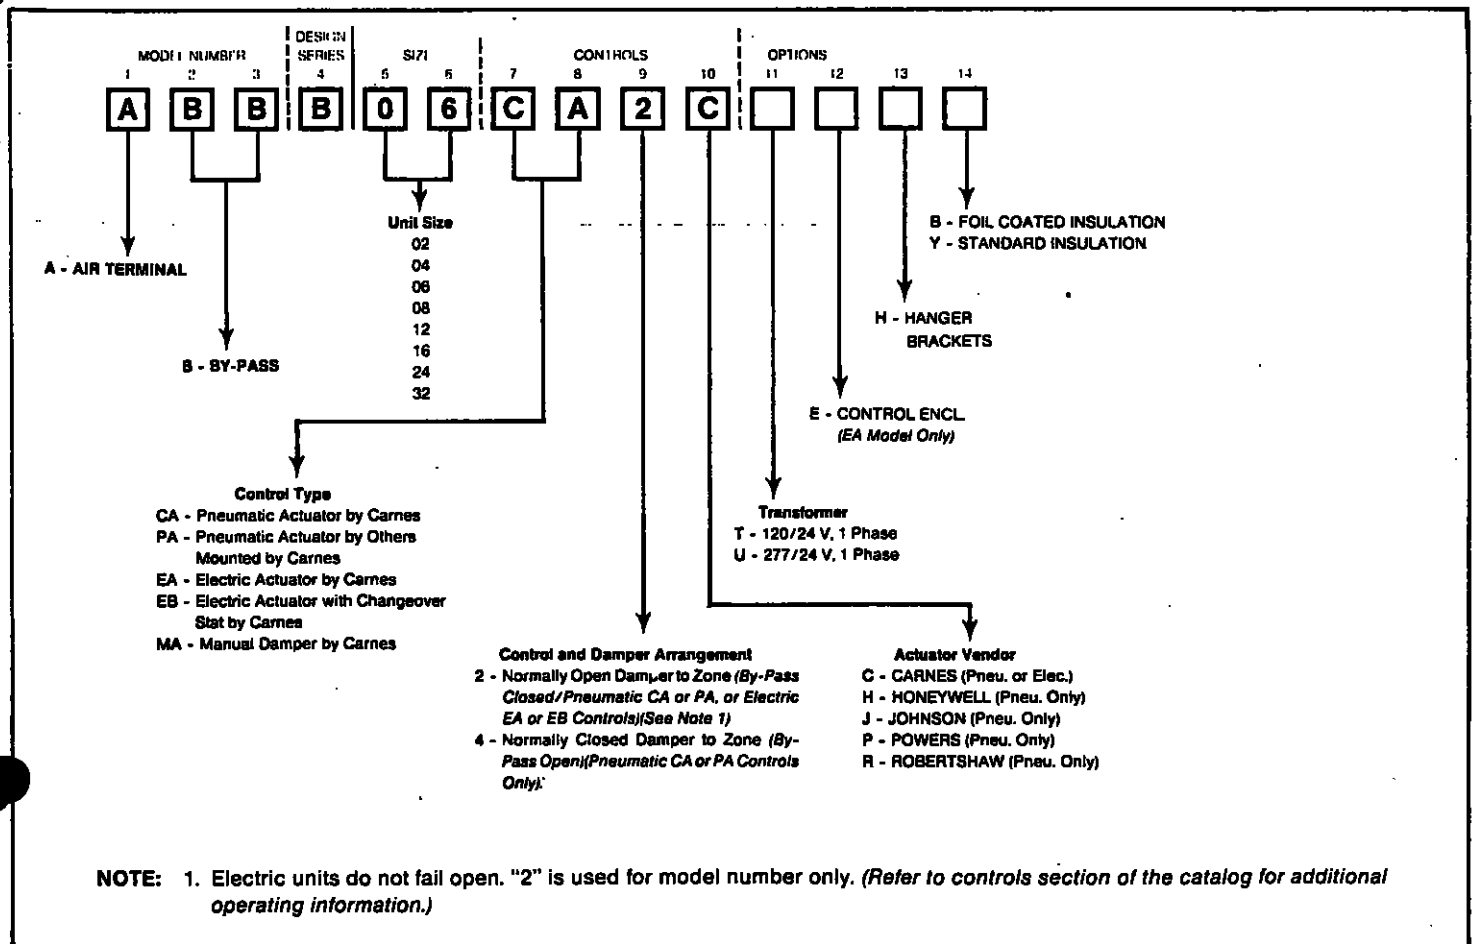

2 Dimensional Data—Model A3BB

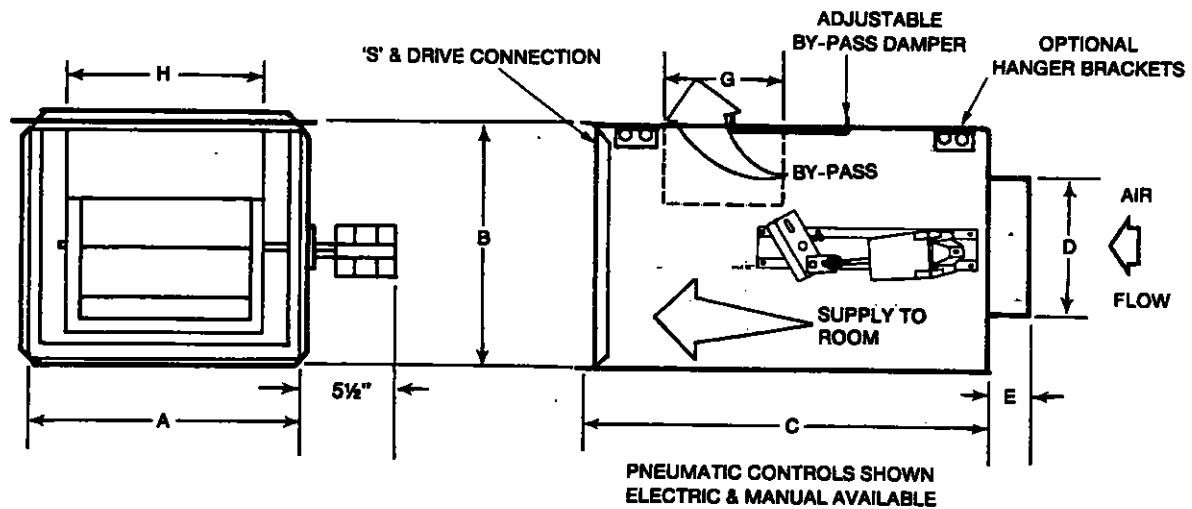

DIMENSIONS LISTED IN INCHES								
BASIC ASSEMBLY								
UNIT SIZE	DISCHARGE		C	D	E	BY-PASS OPENING		WEIGHT (lbs.) Less Controls
	A	B				G	H	
02	10	8	15 ³ / ₄	5	2 ³ / ₈	4 ³ / ₁₆	7	11
04	12	10	15 ³ / ₄	8	2 ³ / ₈	5 ⁷ / ₈	9	14
06	14	12	21 ³ / ₄	10	2 ³ / ₈	9 ³ / ₄	11	19
08	16	14	21 ³ / ₄	12	2 ³ / ₈	9 ⁵ / ₈	13	27
12	18	16	23 ³ / ₄	14	2 ⁵ / ₈	10 ³ / ₈	15	31

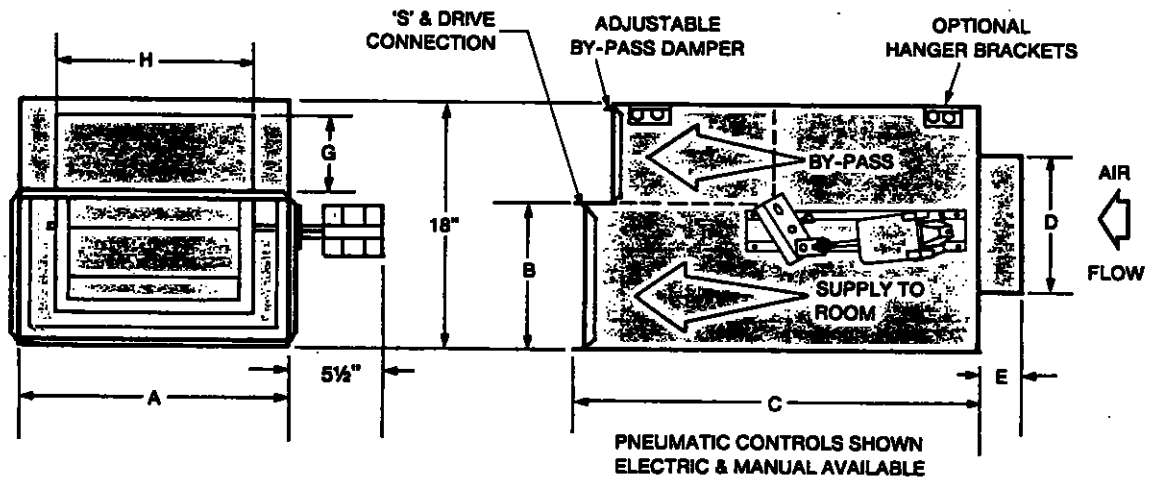

DIMENSIONS LISTED IN INCHES								
BASIC ASSEMBLY								
UNIT SIZE	DISCHARGE		C	D	E	BY-PASS OPENING		WEIGHT (lbs.) Less Controls
	A	B				G	H	
16	20	10	24 ¹ / ₈	16	2 ⁵ / ₈	6 ¹ / ₂	17	36
24	24	10	24 ¹ / ₈	16 x 18	3 ³ / ₈	6 ¹ / ₂	21	40
32	32	10	24 ¹ / ₈	16 x 24	3 ³ / ₈	6 ¹ / ₂	29	50

Table 2 — Electrical Data (3-Phase, 60-Hz)

UNIT							COMPRESSOR			FANS			
38AD	Model	Volts			MCA	Max Fuse Amps	RLA	LRA	MTA	Total	FLA (ea)		KW (Total)
		Nameplate	Supplied*								No. 1	No. 2,3	
			Min	Max									
024	520	208/230	187	253	103	175	76.0	345	53	3	4.5	4.6	3.36
	620	460	414	508	51	80	36.0	173	50		1.9	1.9	3.36
	120	575	518	632	41	60	28.6	120	40		1.6	1.6	3.36
028	530	208/230	187	253	145	225	100.0	446	70	3	6.2	6.6	4.05
	630	460	414	508	69	110	48.0	223	33		3.0	3.0	4.05
	130	575	518	632	62	100	43.4	164	61		2.5	2.5	4.05
034	520	208/230	187	253	170	275	120.0	506	83	3	6.2	6.6	4.05
	620	460	414	508	72	110	50.0	253	35		3.0	3.0	4.05
	120	575	518	632	64	100	45.0	176	63		2.4	2.4	4.05


FLA — Full Load Amps (fan motors)
LRA — Locked Rotor Amps
MCA — Minimum Circuit Amps. Complies with National Electrical Code (NEC) 430-24.
MTA — Must Trip Amps (circuit breaker)

RLA — Rated Load Amps (compressor)
*Units are suitable for use on electrical systems where voltage supplied to the unit terminals is not below or above the listed limits.

Table 3 — Maximum Allowable Field Wire Sizes

UNIT	SIZE	VOLTS (60-Hz)	WIRE SIZE	CONN.
38AD	024,028,034	208/230	6 AWG to 350 MCM	TB
		460, 575	14 AWG to 2/0	

TB — Terminal Block (with integral compression terminal).

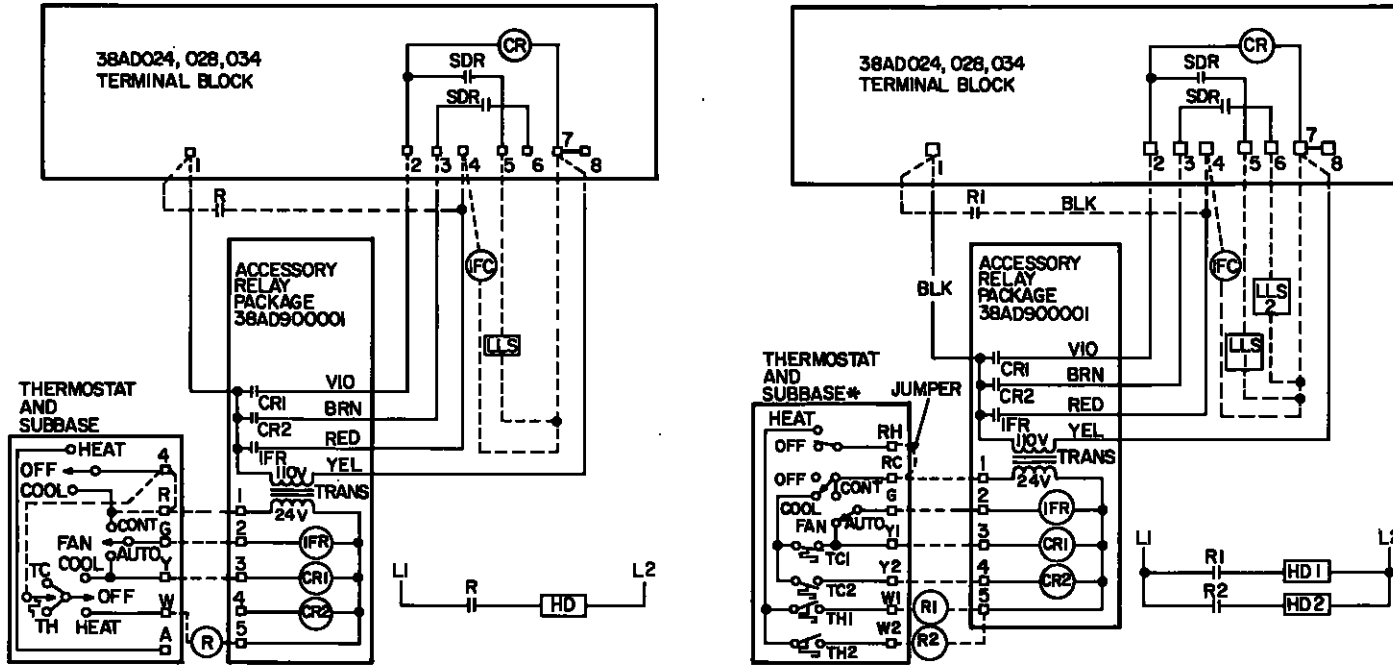

(A) ONE-STEP COOLING/ONE-STEP HEATING

(B) TWO-STEP COOLING/TWO-STEP HEATING

*Manual changeover type shown.

Fig. 7 — Control Circuit Wiring with 24-Volt Accessories

NOTE: Do not use circuit breaker to start or stop compressor, except in an emergency.

Depending on the position of the Time Guard® timer, start-up of the compressor will be delayed from 12 seconds to 8 minutes from the time the control circuit is energized.

Charge System

- Block condenser coils to maintain 125 F condensing temperature at 280 psig, then add additional charge to clear sight glass. (If long liquid lines or vertical lifts greater than 25 ft are used, a liquid line sight glass should be installed at condensing unit and used for charging purposes.)
- After sight glass has cleared, additional charge must be added per Table 4 to flood subcooler circuits in condensers.

Table 4 — Charging Data (R-22)

UNIT 38AD	REFRIG CHG (lb)	REFRIG STORAGE CAP. (lb)†
	Subcooler Coil*	
024	8	70
028	8	77
034	7	99

*For maximum system capacity without receiver.
†At 120 F condensing temperature with condenser 80% full of liquid.
NOTE: Values shown do not include charging requirements for cooling coils and piping.

Oil Charge (Table 5) — Allow unit to run for about 20 minutes. Stop unit and check compressor oil level. Add oil only if necessary to bring oil into view in sight glass. Use only Carrier-approved compressor oil. Approved oils are:

Sun Oil Company Suniso 3GS
Texaco, Inc. Capella BI
E.I. DuPont Company DuPont Synthetic Refrigeration Oil (150 SSU only)

Do not reuse drained oil or use any oil that has been exposed to atmosphere. Procedures for adding or removing oil are given in Carrier Standard Service Techniques Manual, Chapter 1, Refrigerants.

If oil is added, run unit for additional 10 minutes. Stop unit and check oil level. If level is again low, add oil only after determining that piping system is designed for proper oil return and that the system is not leaking oil.

Table 5 — Physical Data

UNIT 38AD	024	028	034
OPER WT (lb)	1750	1900	2300
REFRIGERANT Oper Charge (lb)*	R-22 28.0 30.5 35.5		
COMPRESSOR	Recip Hermetic — 1750 Rpm		
Number	1	1	1
Model 06E	4250	5265	5275
Cylinders	4	6	6
Oil (pt)†	14	19	19
Crankcase Heater (watts)	125		
Protection	See Note		
Capacity Control	Suction Pressure Unloader(s)		
No. 1	Unloader Settings (psig)		
Load	76	76	76
Unload	58	58	58
No. 2	Unloader Settings (psig)		
Load	—	78	78
Unload	—	60	60
CONDENSER FANS	Axial Flow, Direct Drive		
Number...Rpm	3...1140		
Diameter (in.)	26	30	30
Motor Hp (ea)	3/4	1	1
Total Airflow (cfm)	18,200	25,200	28,200
CONDENSER COIL	Plate Fins, 3 Rows		
Sections	1	1	1
Total Face Area (sq ft)	35.4	39.0	49.6
Capacity (lb)‡	70	77	99
ELECTRIC CONTROLS	Time Guard® Circuit**		
Pressurestat, Dual			
High Cutout (psig)	364	364	364
High Cut-in (psig)	264	264	264
Low Cutout (psig)	29	29	29
Low Cut-in (psig)	44	44	44
Oil Pressure Switch Cutout	5 psi above suction pressure		
Fan Cycling Controls			
No. 2 Fan: Press. (± 5 psig)	Opens 160, Closes 260		
No. 3 Fan: Temp (± 3 F)	Opens 70, Closes 80		
PRESSURE RELIEF	Fusible Plug		
DISCHARGE LINE CHECK VALVE	1	1	1

*Approximate charge for maximum system capacity. All units shipped with holding charge.
†Refer to Oil Charge for Carrier-approved compressor oil.
‡Storage capacity at 120 F condensing temperature with condenser 80% full of liquid.
**Protection against compressor short cycling.
NOTE: Circuit Breaker in main power circuit and Discharge Gas Thermostat in control circuit.

Check Operation of all safety controls. Replace all service panels. Be sure that control panel door is closed tightly.

SERVICE

Capacity Control is by either one or 2 suction pressure actuated unloaders. Each controls 2 cylinders. Unloaders are factory set (see Table 4) but may be field adjusted. Number 1 unloader is on cylinder bank on same side of compressor as terminal box.

CONTROL SET POINT

The control set point (cylinder load point) is adjustable from 0 to 85 psig. To adjust, turn control set point adjustment nut (Fig. 8) clockwise to its bottom stop. In this position, set point is 85 psig. Then, turn adjustment counterclockwise to desired control set point. Every full turn counterclockwise decreases set point by 7.5 psig.

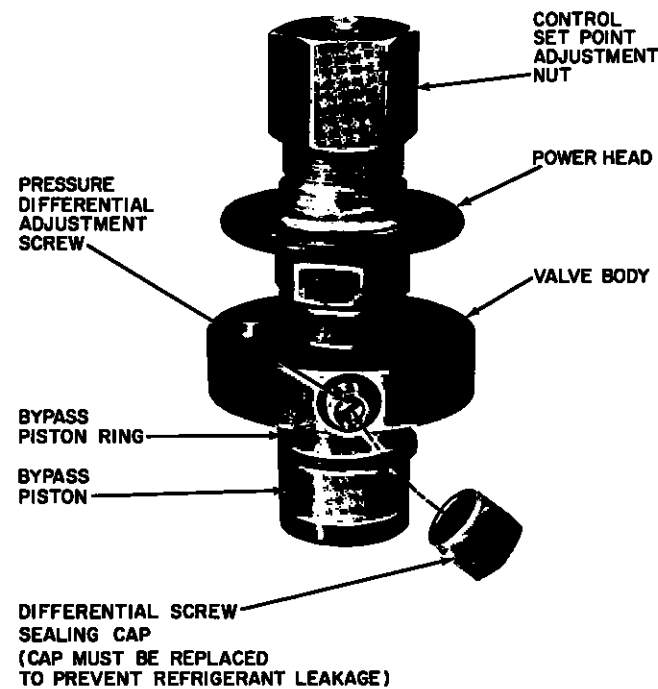


Fig. 8 — Capacity Control Valve

PRESSURE DIFFERENTIAL

The pressure differential (difference between cylinder load and unload points) is adjustable from 6 to 22 psig. To adjust, turn pressure differential adjustment screw (Fig. 8) counterclockwise to its backstop position. In this position, differential is 6 psig. Then, turn adjustment clockwise to desired pressure differential. Every full turn clockwise increases differential by 1.5 psig.

Oil Pressure Safety Switch (OPS) in the control circuit stops the compressor, and unit, if proper oil pressure differential is not established at start-up or maintained during operation. If OPS stops the unit, determine the cause and correct before restarting unit. Failure to do so will constitute abuse. *Equipment failure due to abuse may void the Warranty.*

Compressor Motor Protection

CIRCUIT BREAKER

A manual reset calibrated-trip magnetic circuit breaker protects the compressor against overcurrent. Do not bypass connections to increase size of breaker for any reason. If trouble occurs, determine cause and correct before resetting the breaker. Circuit breaker Must Trip Amps (MTA) are listed in Table 2, Electrical Data.

DISCHARGE GAS THERMOSTAT

A sensor in the discharge gas of the compressor reacts to excessively high discharge gas temperature and shuts off the compressor. The high temperature of the discharge gas is a direct indication of an over-temperature condition in compressor motor.

CRANKCASE HEATER

The compressor has an electric heater located in the bottom cover, held in place by a clip and bracket. Heater must be tight to prevent backing out (heater will burn out if exposed to air). The heater is wired into the compressor control circuit thru a relay to energize only when the compressor shuts off. This keeps the oil at a temperature that will prevent excessive absorption of refrigerant during shutdown periods.

Crankcase heater should be energized at all times when unit is not running except during prolonged shutdown or during servicing. In these cases, the heater should be energized for 24 hours before unit is restarted.

TIME GUARD® DEVICE

Time Guard function prevents compressor from short cycling.

Fan Motor Protection — Fan motors are inherently protected, grouped on a single circuit breaker.

Fan Adjustment — When replacing a fan, adjust fan until top surface of hub plate is below the top of the orifice ring as indicated in Fig. 9. Then, tighten both setscrews, located over the keyway of the fan hub of the motor shaft. Seal recessed area of fan hub bore with Permagum to prevent rusting.

Head Pressure Control reduces condensing capacity under low ambient temperature conditions. For intermediate season operation, fan cycling is employed. Fan no. 2 is cycled by pressure control, with the pressure sensor located in the liquid line. Fan no. 3 is cycled by an air temperature thermostat (see Table 5). For operation under colder ambient conditions, refer to 32LT service publication for use of Motormaster® control to supplement fan cycling.

Winter Start Control — Contacts D-D1 in the 4-function timer bypass the low-pressure switch (LPS) for 2-1/2 minutes at unit start-up to prevent nuisance LPS trips at low ambient temperature.

DEFROST THERMOSTAT (optional, field supplied)

If an oil return connection at the bottom of this suction header is supplied with an evaporator, this connection must be teed in ahead of first mixing elbow. When the compressor is below the evaporator, the riser at the evaporator does not have to extend as high as the top level. After a 15 diameter riser has been provided, the suction line may elbow down immediately.

SAFETY RELIEF

A fusible plug is located on unit liquid line before the liquid valve.

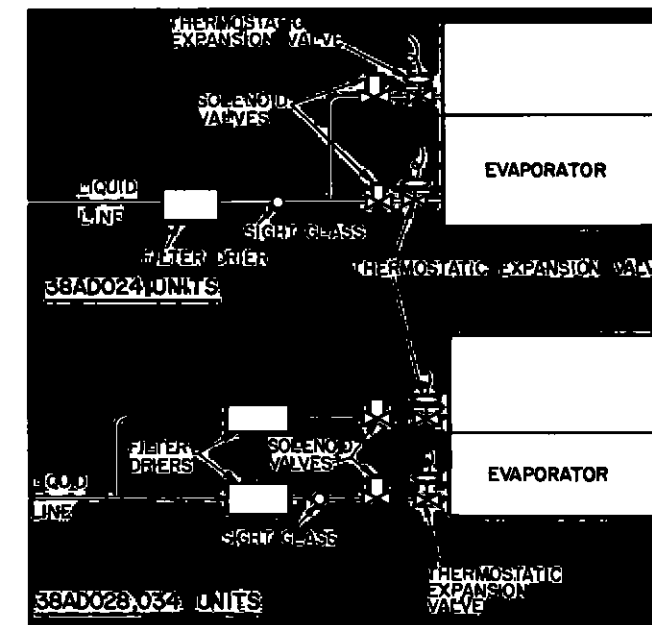


Fig. 6 — Recommended Filter Drier(s) and Sight Glass Locations

Step 4 — Make Electrical Connections

POWER SUPPLY

Electrical characteristics of available power supply must agree with unit nameplate rating. Supply voltage must be within tolerances shown in Table 2. Phase unbalance must not exceed 2%. *Operation of unit on improper supply voltage or with excessive phase unbalance constitutes abuse and is not covered by Carrier Warranty.*

POWER WIRING

All power wiring must comply with applicable local and national codes. Install a field-supplied branch circuit disconnect switch of a type that can be locked "Off" or "Open." Run power wires from the disconnect switch thru the power opening (H on Fig. 2) on unit and connect to terminal block just inside the opening. Refer to Table 3 for maximum wire size at terminal block.

The power terminal block is in the control box. Remove the outer panel and remove the no. 10 screw on the door. Swing open door, remove screws on barrier panel and remove barrier panel.

Condenser fans must rotate clockwise when viewed from above. If necessary, correct direction of fan rotation by interchanging any 2 power input wires at disconnect switch.

Affix crankcase heater decal to unit disconnect switch.

CONTROL CIRCUIT WIRING

Internal control voltage on 38AD units is 115 volts. All control circuit wiring must comply with applicable local and national codes. Remote control wiring must enter unit control box thru control opening (G on Fig. 1) and connect to terminal block inside the control box.

LOW-VOLTAGE REMOTE CONTROL

Install field-supplied accessories as shown in Fig. 7 for either one-step cooling, one-step heating or 2-step cooling, 2-step heating. Wire liquid line solenoids as shown.

START-UP

Preliminary Checks

1. Compressor oil level must be visible at sight glass in compressor crankcase. Add oil if necessary. (See Oil Charge.)
2. Compressor must float freely on its mounting springs.
3. All internal wiring connections must be tight, and all barriers and covers must be in place.
4. Electrical power source must agree with unit nameplate rating.
5. All service valves must be open.
6. Crankcase heater must be firmly locked in place.

Leak Test the entire refrigerant system by the Pressure Method described in the Carrier Standard Service Techniques Manual, Chapter 1, Section 1-6. Use R-22 at approximately 25 psig backed up with an inert gas to a total pressure not to exceed 245 psig. **Evacuate and Dehydrate** the entire refrigerant system by either of the methods described in the Carrier Standard Service Techniques Manual, Chapter 1, Section 1-7.

Preliminary Charge — Refer to Carrier Standard Service Techniques Manual, Chapter 1, Section 1-8, for charging methods and procedures mentioned below.

Charge system with approximately 25 lb of R-22 by the Liquid Charging Method and Charging by Weight Procedure.

Start the Unit — The field disconnect is closed, the fan circuit breaker is closed and the space thermostat is set above ambient temperature so that there is no demand for cooling. Only the crankcase heater is energized. After the heater has been on for 24 hours, the unit can be started.

Close the compressor circuit breaker and then reset the space thermostat *below* ambient temperature, so that a call for cooling is ensured.

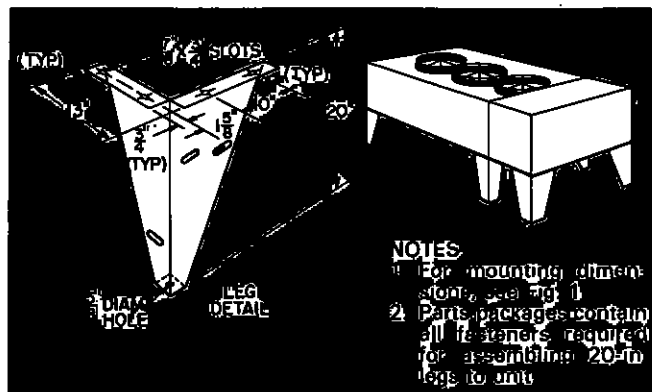


Fig. 3 — Mounting Leg for 38AD Units

SINGLE PUMPOUT CONTROL

All units are factory wired to operate on single pumpout control. A field-supplied liquid line solenoid valve is required, sized for minimum pressure drop, to be installed immediately ahead of each expansion valve. If unit is to be used with a chiller, wiring modifications may be necessary.

FILTER DRIER AND MOISTURE INDICATOR

Every unit should have a filter drier and a sight glass (moisture indicator) field installed. Select the filter drier for maximum unit capacity and minimum pressure drop. Figure 6 shows recommended locations of filter drier(s) and sight glass. Complete the refrigerant piping from the evaporator to the condenser before opening the liquid and suction lines at the condensing unit.

RECEIVER

No receiver is provided with the unit; it is recommended that one *not* be used.

PIPING PROCEDURE

Do not remove plastic dust bags from suction and liquid line stubs in compressor compartment until piping connections are ready to be made. Pass nitrogen or other inert gas thru piping while brazing, to prevent formation of copper oxide.

Install field-supplied thermostatic expansion valve in liquid line ahead of each evaporator section. For 2-step cooling, the solenoids used must be wired to be opened by control from a 2-step thermostat.

For example: 2 solenoids may be used with 3 TXVs — one of the solenoids serving a liquid line feeding 2 of the TXVs. When 3 solenoids are used with 3 TXVs, 2 of the solenoids must be tied in parallel with the thermostat to serve the one liquid line feeding the 2 TXVs. The third solenoid operates independently for the other step of cooling.

SUCTION PIPING AT EVAPORATOR AND TXV BULB LOCATION (ref. Fig. 5)

The purpose of these recommendations is to achieve good mixing of the refrigerant leaving the evaporator suction header for proper sensing by the TXV bulb.

1. A minimum of two 90° elbows must be installed upstream of the expansion valve bulb location.

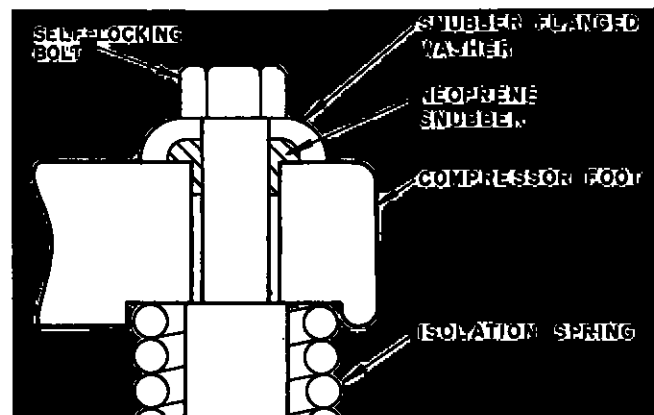


Fig. 4 — Compressor Mounting

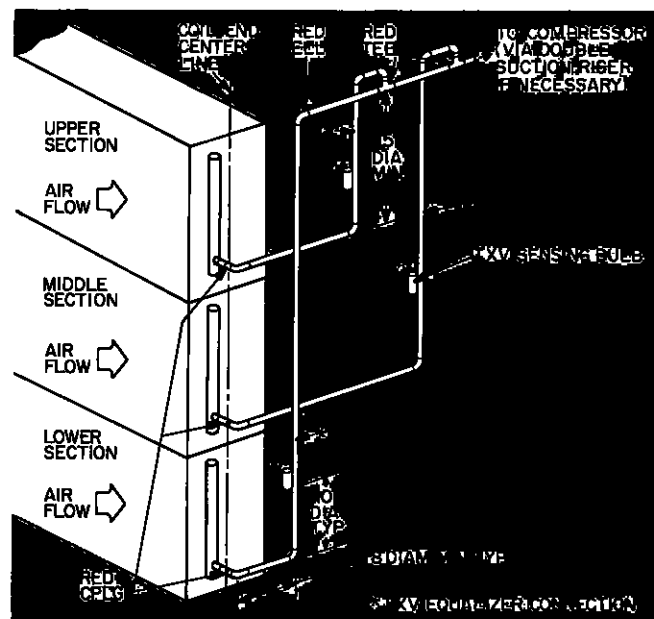


Fig. 5 — Suction Line Piping to Unit with 3 Section Coil Split

2. The TXV sensing bulb should be located on a vertical riser where possible. If a horizontal location is necessary, secure the bulb at approximately the 4 o'clock position.
3. Size the suction line from the evaporator thru the riser for high velocity. Enter the suction pipe sizing charts in the Carrier System Design Manual at design tons and equivalent length (for 2 F loss). If reading falls between 2 sizes on chart, choose the smaller pipe size.

Suction piping for the high velocity section should be selected for about 0.5 F friction loss. If a 2 F loss is allowed for the entire suction line, 1.5 F is left for the balance of the suction line and it should be sized on that basis. Check that the high-velocity sizing is adequate for oil return up the riser.

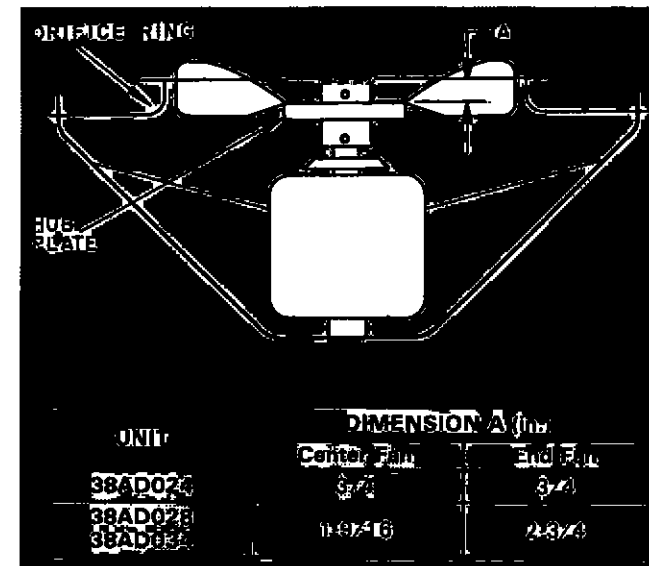


Fig. 9 — Fan Adjustment

NOTE: A defrost thermostat should be used on systems operating with outdoor temperatures below 45 F.

Position switch so that moisture cannot enter switch insulator. Install control with approximately 2 in. of top of thermostat capillary passing thru lower part of evaporator coil and with remainder of capillary inserted between fins on entering air side of coil. Connect thermostat electrical contacts into indoor cooling thermostat circuit or in series with compressor holding coil.

Thermostat is set to cut out at 25 F and cut in at 55 F. Contact rating is 16 amps and 230 volts. As evaporator coil frosts, coil fin temperature drops to thermostat cutout setting, and stops compressor. Evaporator fans keep running to defrost coil with room air. As indoor coil defrosts, fin temperature will rise to thermostat cut-in setting. Compressor starts when cooling is required.

Lubrication

FAN MOTORS

Fan motors have permanently lubricated bearings. No provisions for lubrication are made.

COMPRESSOR

The compressor has its own oil supply. Loss of oil due to a leak in the system should be the only reason for adding oil after the system has been in operation.

Coil Cleaning — Clean coils with a vacuum cleaner, fresh water, compressed air or a bristle brush (not wire). Set up coil cleaning as part of a planned maintenance schedule when units are installed in corrosive environments. Wash all accumulations of dirt from coil in these applications. Keep condenser coil drain holes free of dirt and debris to ensure adequate coil drainage.

SEQUENCE OF OPERATION

The first stage of the cooling thermostat (TC1) closes, calling for cooling, and the indoor fan contactor is immediately energized, starting the indoor fan. The control relay (CR) is energized and the no. 1 outdoor fan contactor (OFC1) is energized, starting the no. 1 outdoor fan immediately. Fan no. 2 will start when the pressure sensor closes on rise at approximately 260 psig (opens at 160 psig). Fan no. 3 will start when the air temperature switch (ATS) closes on rise at approximately 80 F (opens at 70 F).

Refer to Fig. 10, Timer Chart: The timer motor (TM) is energized thru the low-pressure switch (LPS) or thru the D-D1 timer contacts, which bypass LPS for 2-1/2 minutes at start-up to avoid nuisance trips on cold starts. Approximately 12 seconds after timer starts, normally open B-B1 contacts close for 1 second. Compressor contactor (C) is energized and the compressor starts. At the same time the solenoid drop relay (SDR) closes; no. 1 liquid line solenoid valve (LLS1) opens and the timer relay (TR) is energized; the normally open TR contacts close to maintain the circuit thru the compressor contactor to keep the compressor running when the B-B1 timer contacts open. Timer contacts E-E1 remain closed for approximately 35 seconds after compressor starts, bypassing the oil pressure switch (OPS). If sufficient oil pressure to close OPS does not come up before the E-E1 contacts open, the compressor stops, the timer cycles off and the control circuit locks out.

On across-the-line (XL) start, the compressor start sequence is completed when the compressor contactor (C) is energized thru the B-B1 timer contacts. On part-winding (PW) start, the B-B1 contacts close for one second, to energize the first-stage contactor (C1); after one second, the timer contacts switch back to B-B2 position and the second-stage compressor contactor (C2) is energized to complete the start sequence.

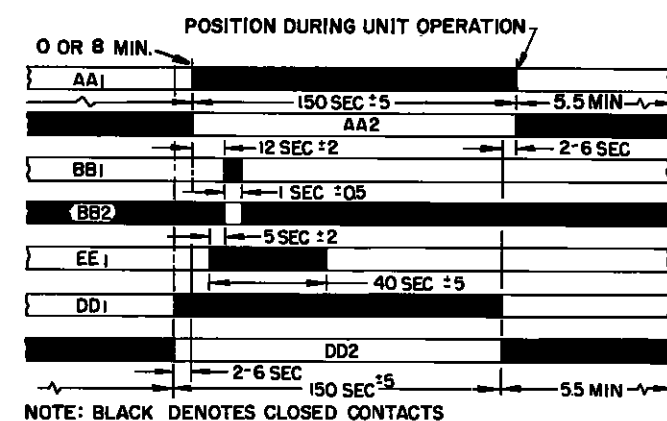


Fig. 10 — Timer Chart



The D-D1 timer contacts, which bypass the low-pressure switch for 2-1/2 minutes at start-up, open approximately 4 seconds before the "A" contacts switch to the run position. If the LPS has not closed by this time, the compressor stops and the control circuit locks out. If, any time after 2-1/2 minutes from starting, the low-pressure switch opens, the compressor stops and the timer continues to run for 5-1/2 minutes and automatically switches to the start sequence, bypassing the LPS. After 2-1/2 minutes, if the LPS has not closed, the compressor stops, and the control circuit locks out. In both of the above cases, the LPS must be closed before the compressor can start.

Whenever the compressor is off because the thermostat is satisfied or because of safety device action, the crankcase heater remains energized. The timer provides a delay of approximately 5-1/2 minutes before the compressor can restart to ensure against short cycling.

If LPS or HPS open or RB is pressed during unit operation, the compressor will stop and the timer motor will start. The compressor, however, cannot restart until the timer completes its cycle (approximately 5-1/2 minutes) and all the switches on the safety devices have closed.

If the compressor stops because of open oil pressure switch (OPS) or open discharge gas thermostat (DGT), the reset button (RB) must be pressed to restart the timer motor. Compressor restart is thru Time Guard® control.

When the second stage of the thermostat (TC2) calls for cooling, LLS2 is energized and the valve opens. This increases the suction pressure and causes the compressor to operate at full capacity, if required.

Number One
Air Conditioning
Maker

Carrier

Division of
Carrier Corporation
Carrier Parkway • Syracuse, N.Y. 13221

Installation, Start-Up and Service Instructions

38AD

024,028,034

Air-Cooled Condensing Units

INSTALLATION

Step 1 — Rig and Locate the Unit RIGGING

Lift units at points 3, 4, 7, 8 (Fig. 1). Use eyebolts and washers supplied in parts package. *Do not sling unskidded unit.* Skidded unit may be slung provided sling does not contact sides of unit. While unit is on skid, it can be rolled or dragged.

PLACING UNIT

Place unit so that airflow is unrestricted above. Provide clearance around the unit as shown in Fig. 2. Remove 6 holddown bolts, releasing the skid. The legs are attached to the base skid.

Block up or suspend the unit. With the bolts supplied, secure the legs (see Fig. 3) to unit (1, 2, 3, 4, 5 and 6 in Fig. 1).


The unit may be mounted on a full pad or on raised supports at each leg. The weight distribution shown in Fig. 1 will determine the type of support required. Bolt unit securely to pad or supports when positioned and leveled.

If vibration isolators are required, the weight distribution shown in Fig. 1 will aid in making the proper selection.

Step 2 — Mount Compressor COMPRESSOR MOUNTING

As shipped, the compressor is held down by special self-locking bolts and lockwashers. After unit is installed, remove the self-locking bolts one at

IMPORTANT: SPREADER BARS MUST BE USED BETWEEN POINTS 3-4 AND 7-8

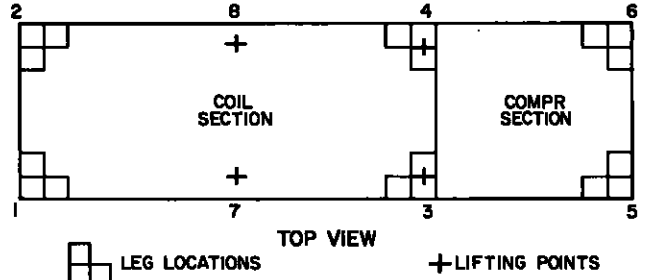

UNIT	TOTAL	WEIGHT (lb)					
		Leg Location					
		1	2	3	4	5	6
38AD024	1750	175	175	575	575	125	125
38AD028	1900	178	178	521	565	207	251
38AD034	2300	263	263	767	767	120	120

Fig. 1 — Weight Distribution

a time and reassemble with flanged washers and neoprene snubbers as shown in Fig. 4. The flanged washers and neoprene snubbers are shipped in a cloth bag tied to one of the compressor feet. Tighten all 4 bolts, then loosen each until the flanged washer can be moved sideways with finger pressure.

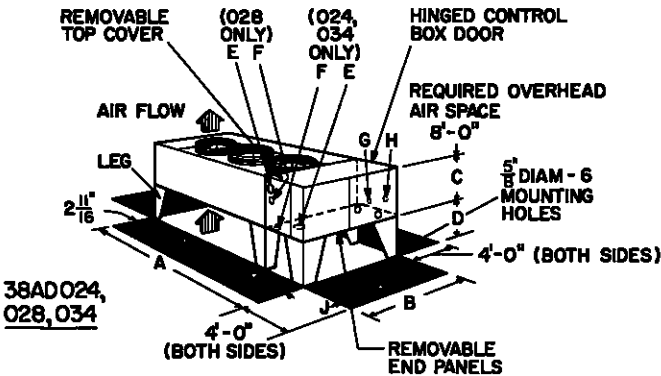


Fig. 2 — Dimensions

Table 1 — Dimensions

UNIT		38AD024	38AD028	38AD034
DIMENSIONS (ft-in.)				
Length	A	12'-10-3/4		
Width	B	3-11-1/2	4-10	
Height w/o Legs	C	2- 4-1/8	3-1-7/8	
Leg Height	D	1-8		
Mtg Holes				
Legs	J	0-2-5/8		
	K	3-6-1/4	4-4-3/4	
	L	3-7-3/8		
	M	8-10		
CONNECTIONS (in.)				
Suction (ODM)		1-5/8		
Liquid (ODM)		7/8		
Hot Gas Bypass		5/8		
OPENINGS (in.)				
Suction	E	1-3/4	2-1/2	1-3/4
Liquid	F		1-1/2	
Control	G		7/8	
Power	H		3-5/8	


Step 3—Make Refrigerant Piping Connections

Line sizes will depend on length of piping required between condensing unit and evaporator; also, liquid lift and compressor oil return are factors to consider. Refer to Part 3 of Carrier System Design Manual for line sizing information and Fig. 5 for recommended piping details.


For replacement items use Carrier Specified Parts

Manufacturer reserves the right to discontinue, or change at any time, specifications or designs without notice and without incurring obligations.

Supporting Documentation

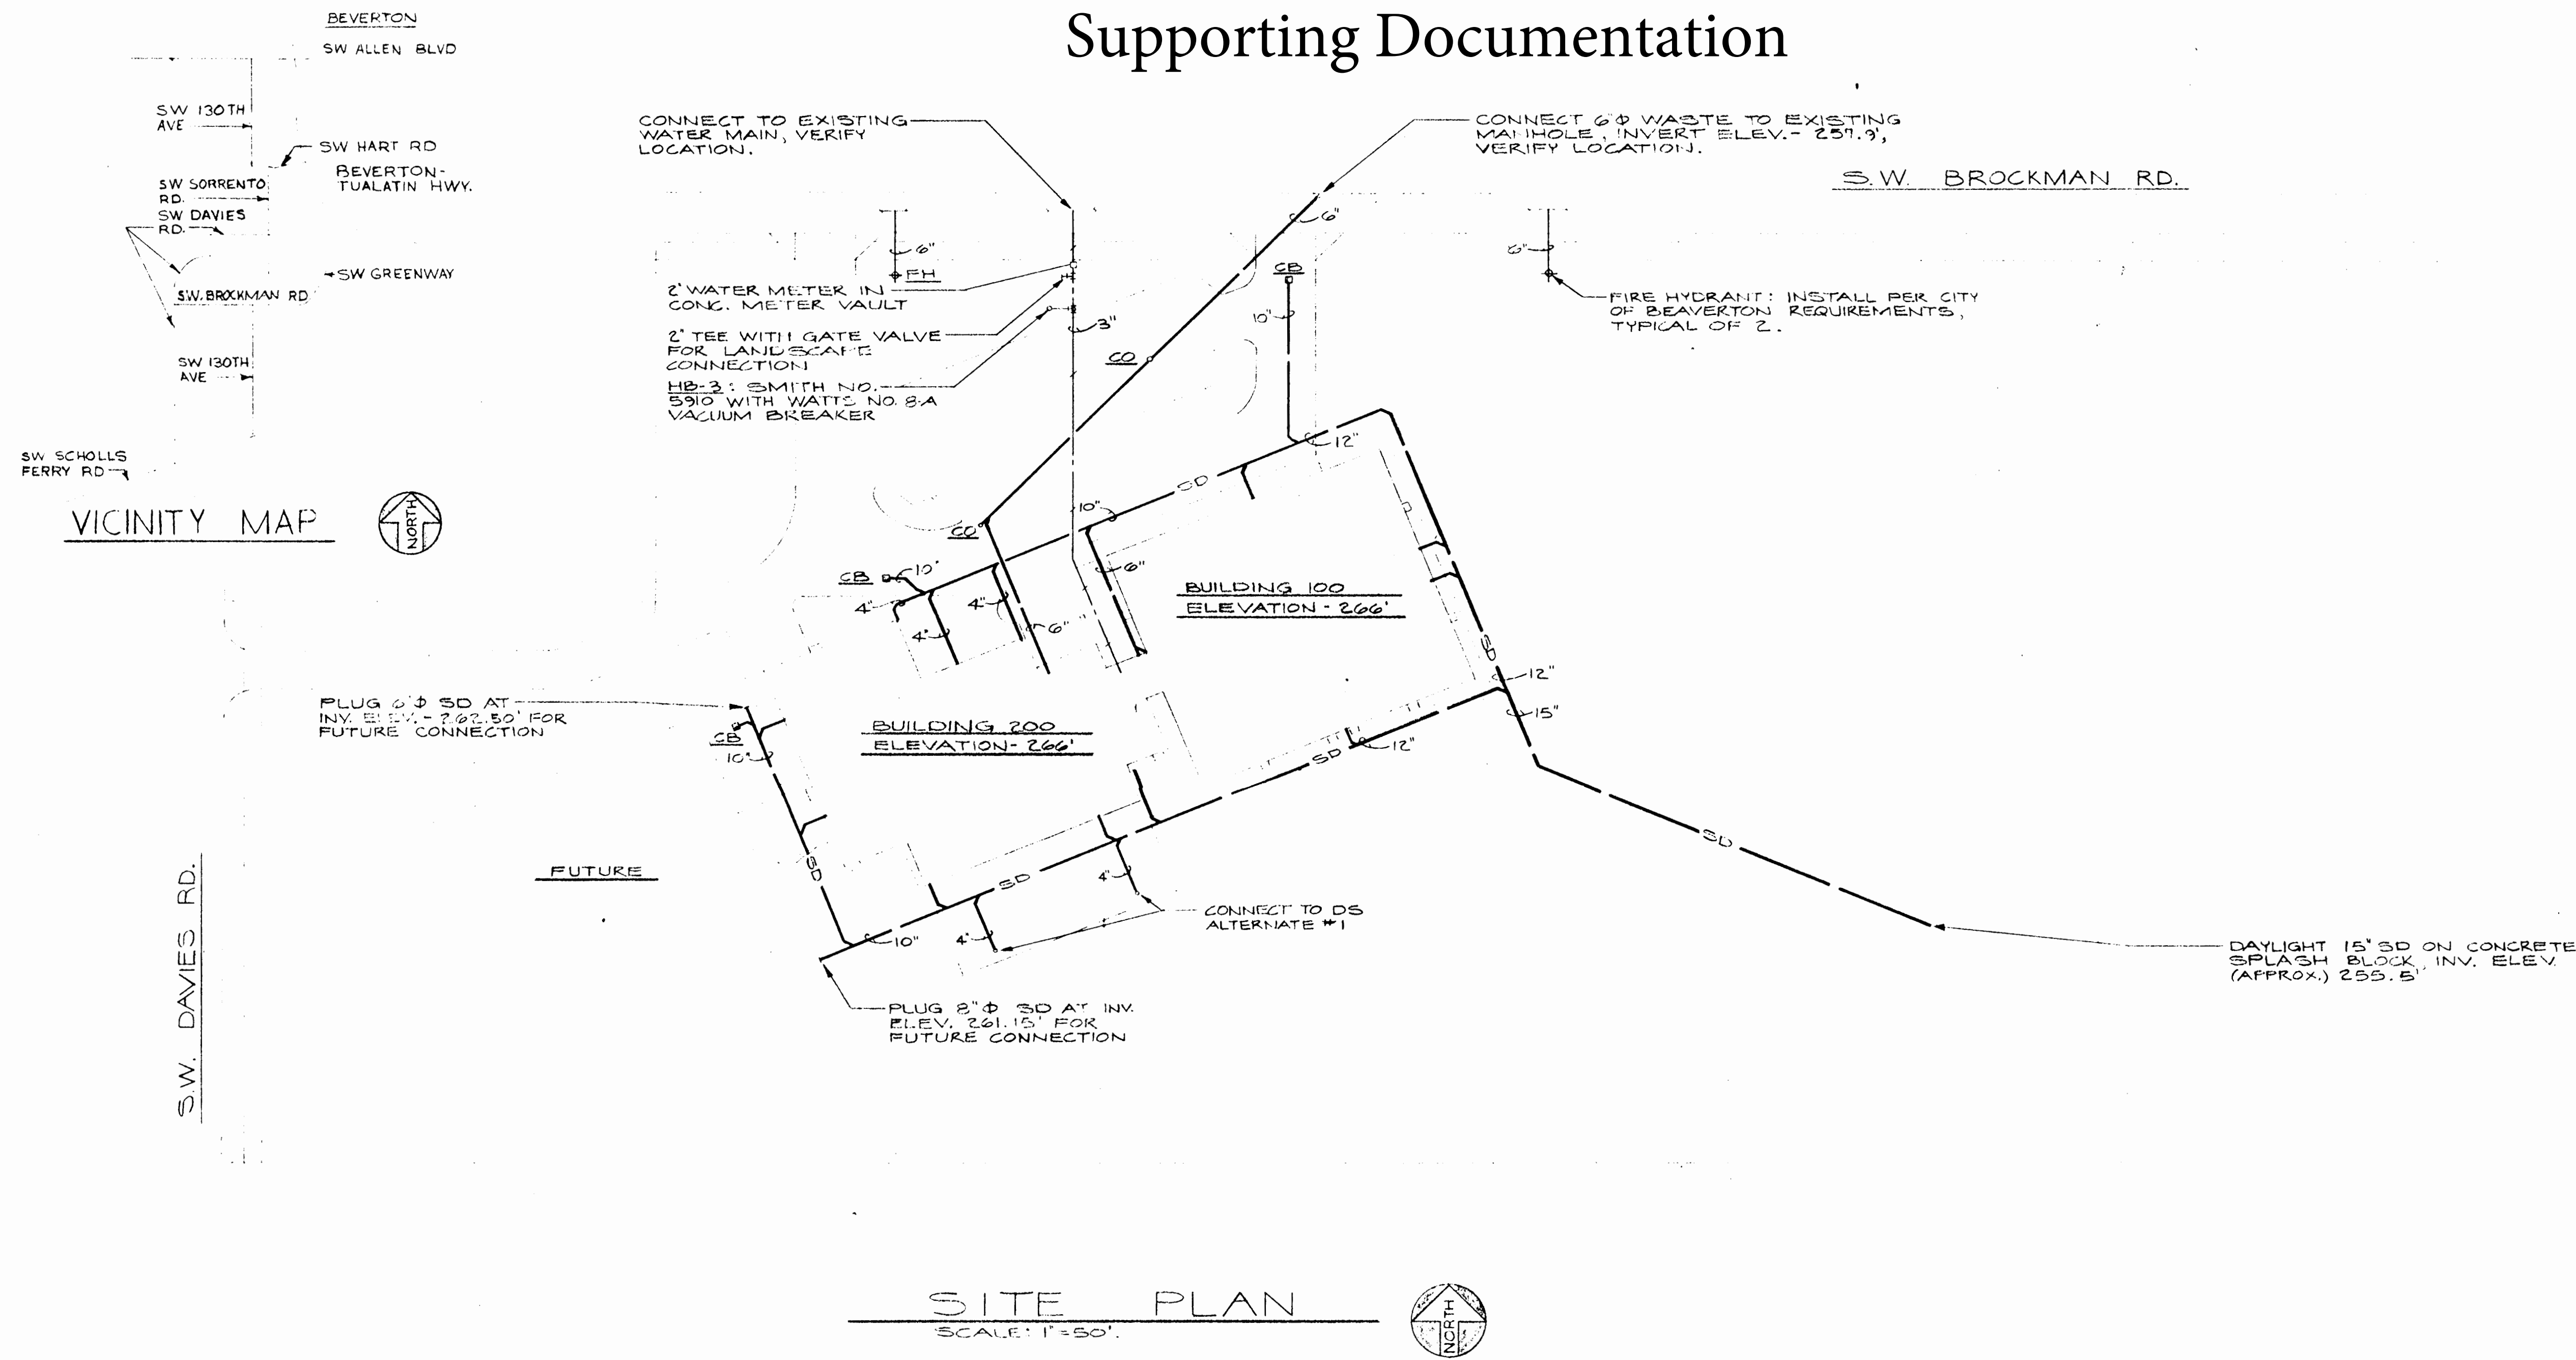


SITE PLAN	SW BROCKMAN ROAD AND SW DAVIES ROAD BEAVERTON, OREGON	
	BEAVERTON SCHOOL DISTRICT 35 BEAVERTON, OREGON	
WILLIAMS & EHMANN AIA ARCHITECTS-PLANNERS 3777 S.E. MILWAUKIE AVENUE PORTLAND, ORE. 97202 503-232-1195		
REVISIONS	DATE	FILE
DEWN 79	1-30-74	
CHKD	COMM 79-67	
SHEET M1 OF 11		

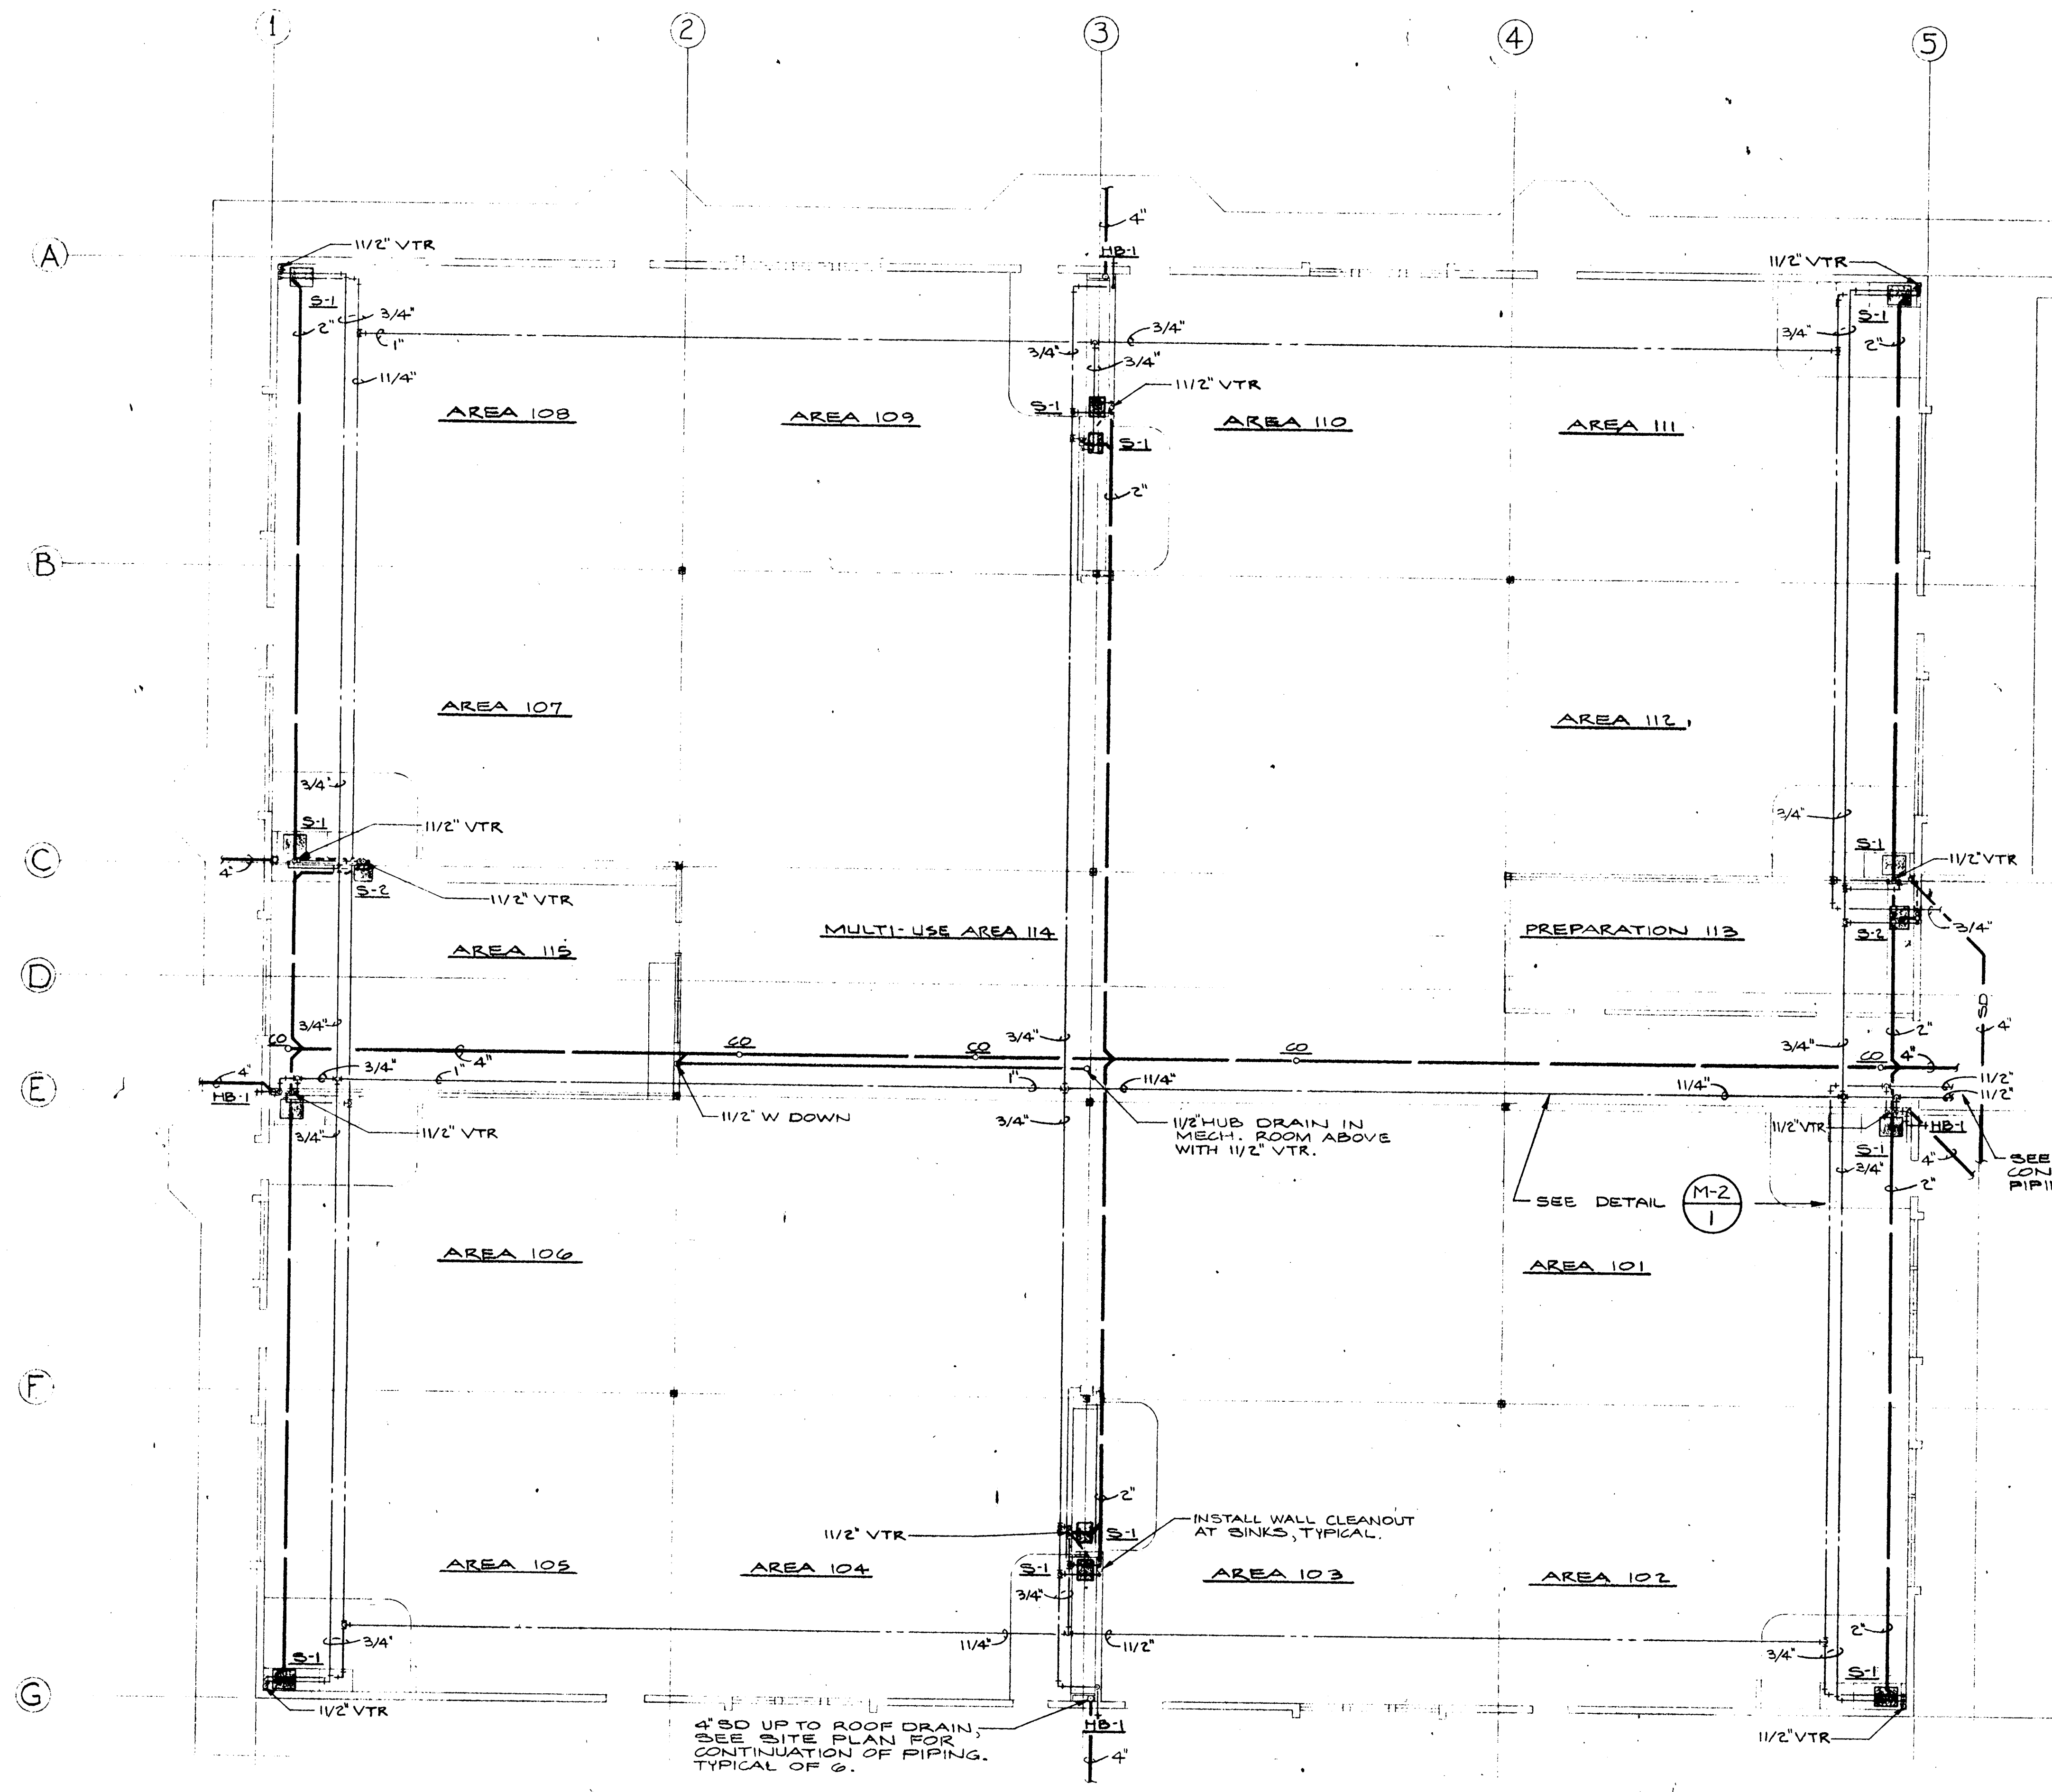

PIPING LEGEND	
---	WASTE BELOW GRADE
---	WASTE ABOVE GRADE
SD ---	STORM DRAIN BELOW GRADE
SD ---	STORM DRAIN ABOVE GRADE
---	COLD WATER BELOW GRADE
---	COLD WATER ABOVE GRADE
---	HOT WATER BELOW GRADE
---	HOT WATER ABOVE GRADE
---	HOT WATER RETURN
---	VENT
G ---	GAS
CB	CATCH BASIN
CO	CLEAN-OUT
FH	FIRE HYDRANT
VTR	VENT THRU ROOF

PLUMBING FIXTURE CONNECTION SCHEDULE						
SYMBOL	FIXTURE	W	V	CW	HW	REMARKS
WC-1/2	WATER CLOSET	4"	2"	1 1/2"	---	
WC-3	WATER CLOSET	4	2	3/4	---	
UR	URINAL	2	2	3/4	---	
L	LAVATORY	1 1/2	1 1/4	3/4	3/4"	
S	SINK	2	1 1/2	3/4	3/4	
SS	SERVICE SINK	3	2	3/4	3/4	
DF	DRINKING FOUNTAIN	1 1/4	1 1/4	3/4	---	
HB	HOSE BIBB	---	---	3/4	---	
WF	WASH FOUNTAIN	2	1 1/2	3/4	3/4	
HE	HEAT EXCHANGER	---	---	2	2	
FD	FLOOR DRAIN	---	---	---	---	PRIME

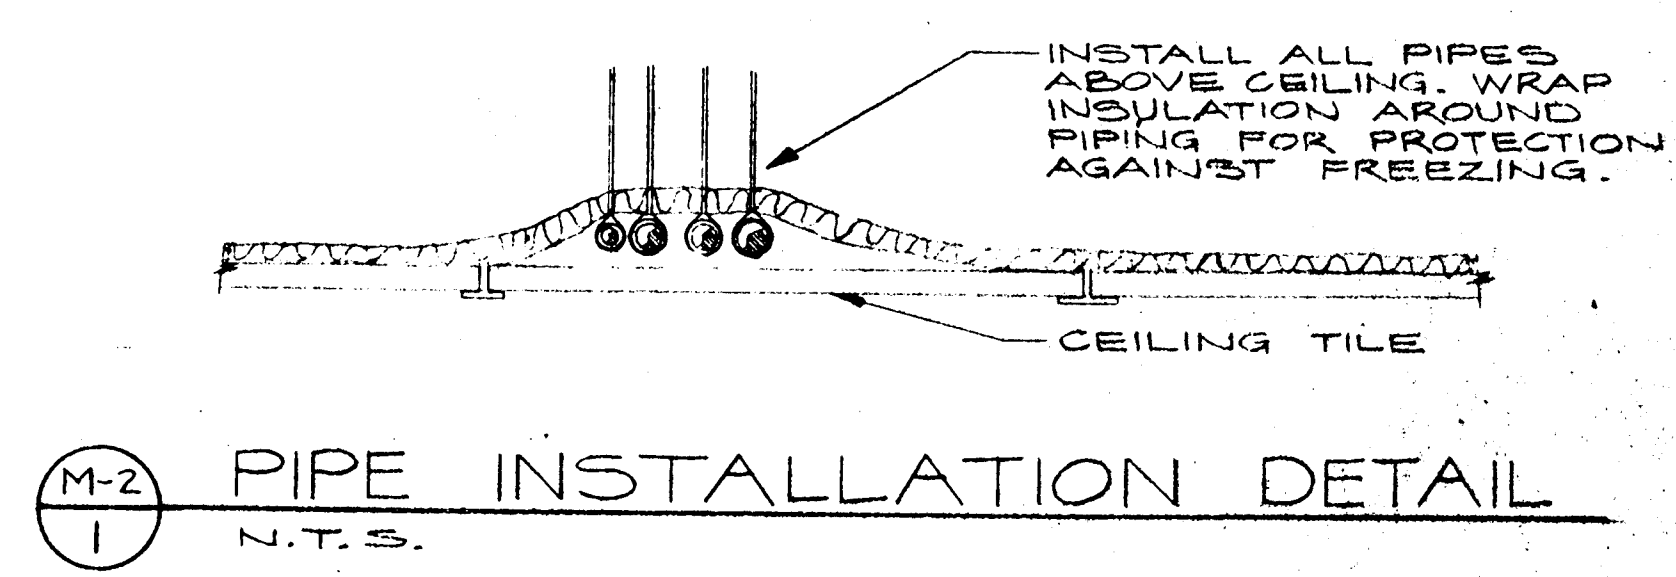

M-2
A BUILDING 100 FLOOR PLAN - PLUMBING
SCALE: 1/8" = 1'-0"

PLUMBING PLAN - BUILDING 100

SW. BROCKMAN ROAD AND SW. DAVIES ROAD
BEAVERTON, OREGON

ELEMENTARY SCHOOL - SCHOOL DISTRICT 48
BEAVERTON, WASHINGTON COUNTY, OREGON



WILLIAMS & EHMANN AIA
ARCHITECTS-PLUMBERS

3727 S.E. MILWAUKEE AVENUE
PORTLAND, ORE. 97202 503-283-3777


DATE: 5-9-74
DRAWN BY: J.B.
FILE

APPROVED: [Signature]
LARRY R. MCGINNIS
MAY 9, 1974
OREGON



SHEET
M 2

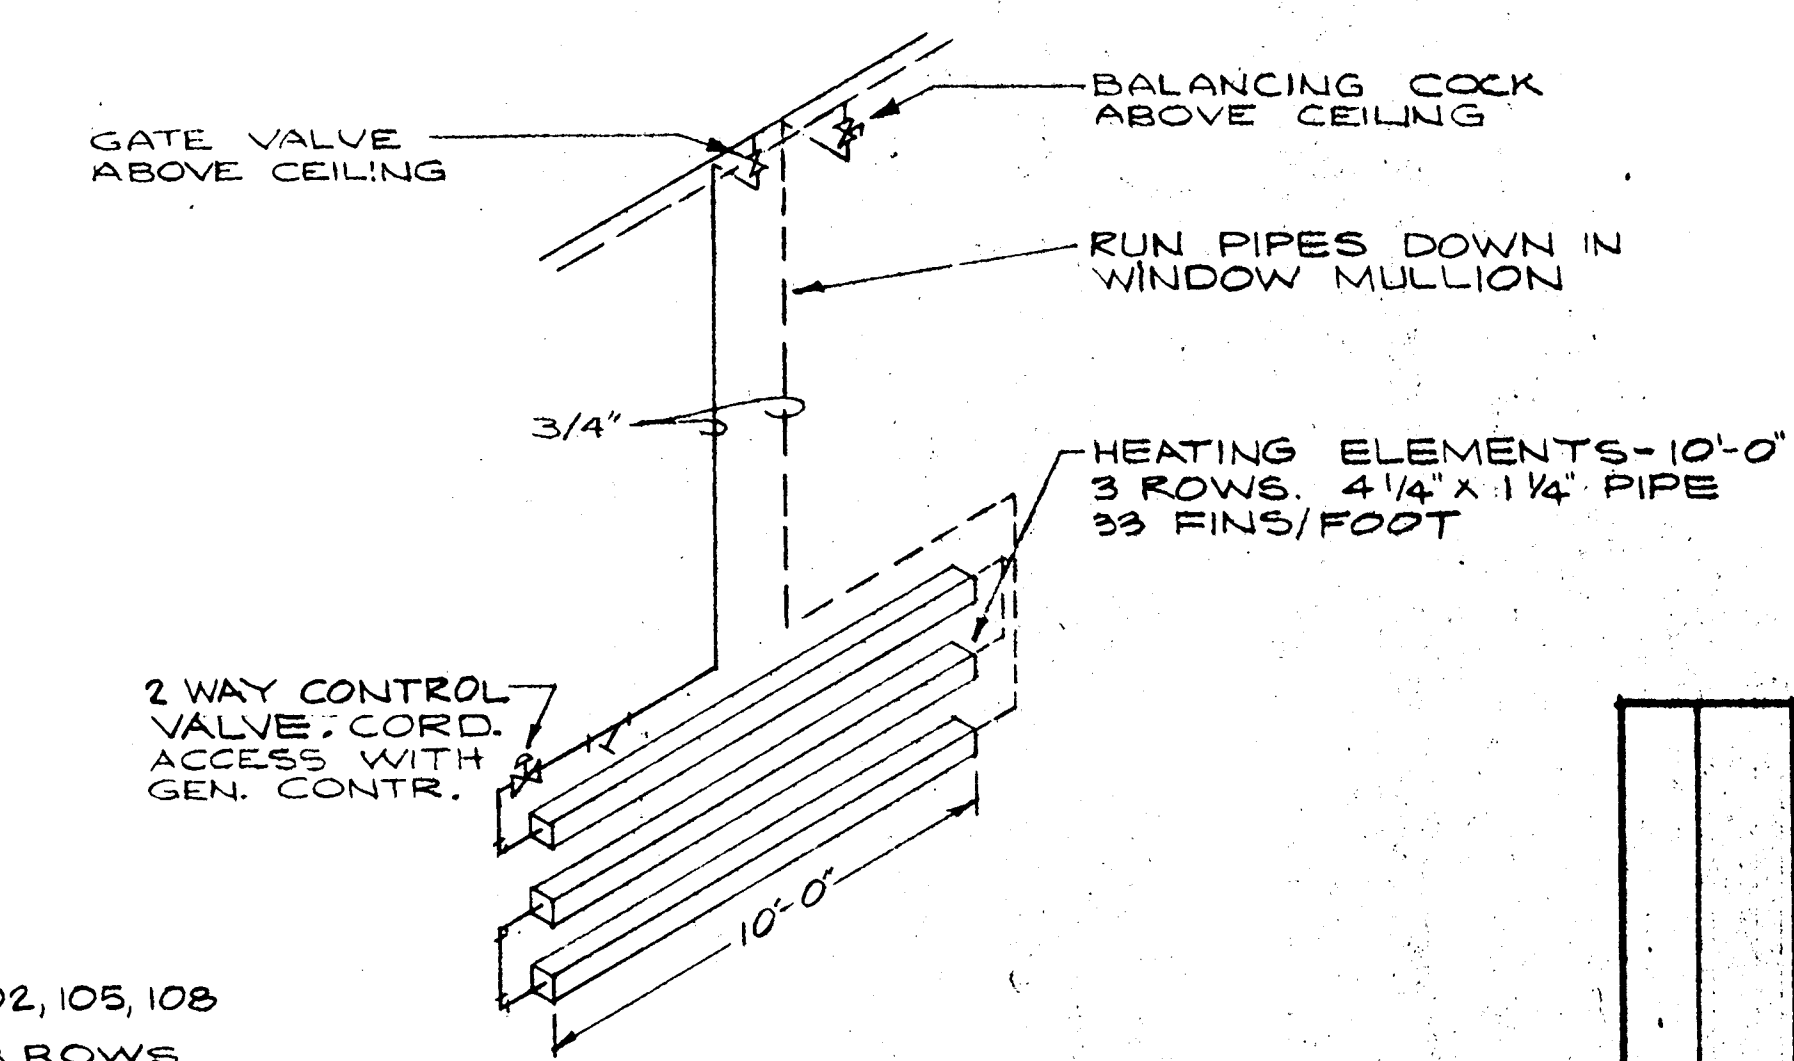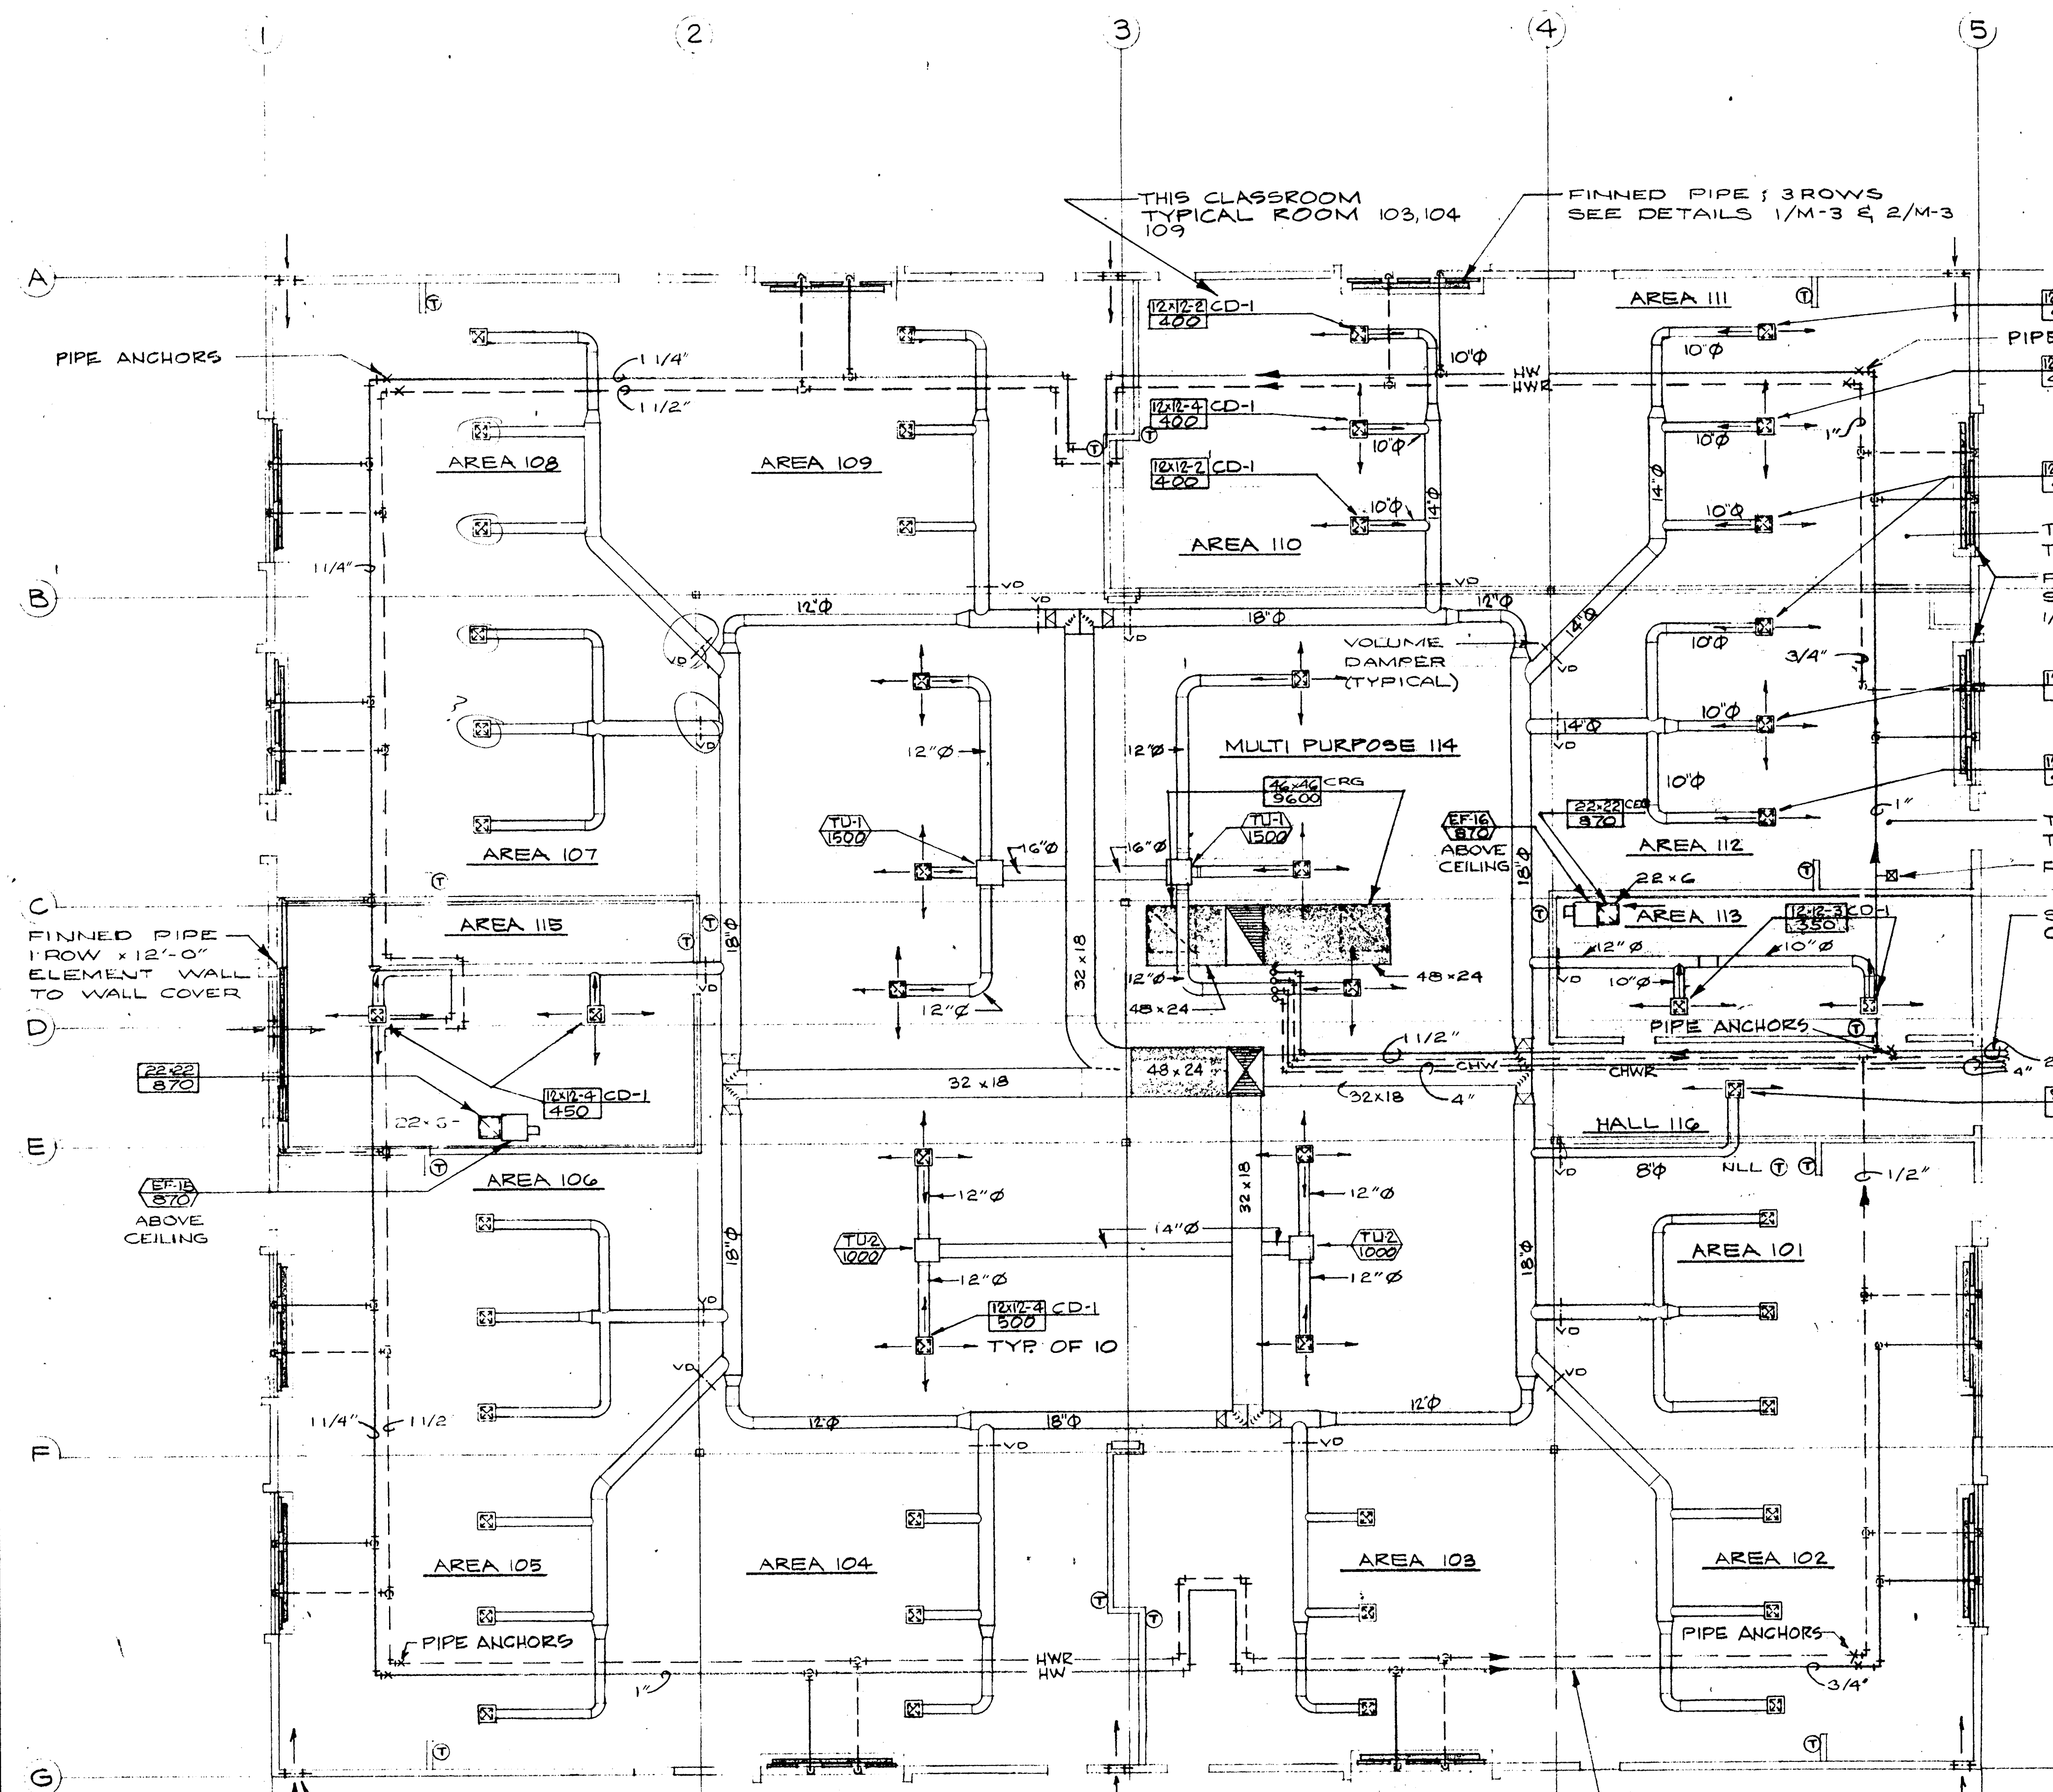

(M-3) 1 TYPICAL CLASSROOM FINED PIPE PIPING DIAGRAM
SCALE: 1/4" = 1'-0"

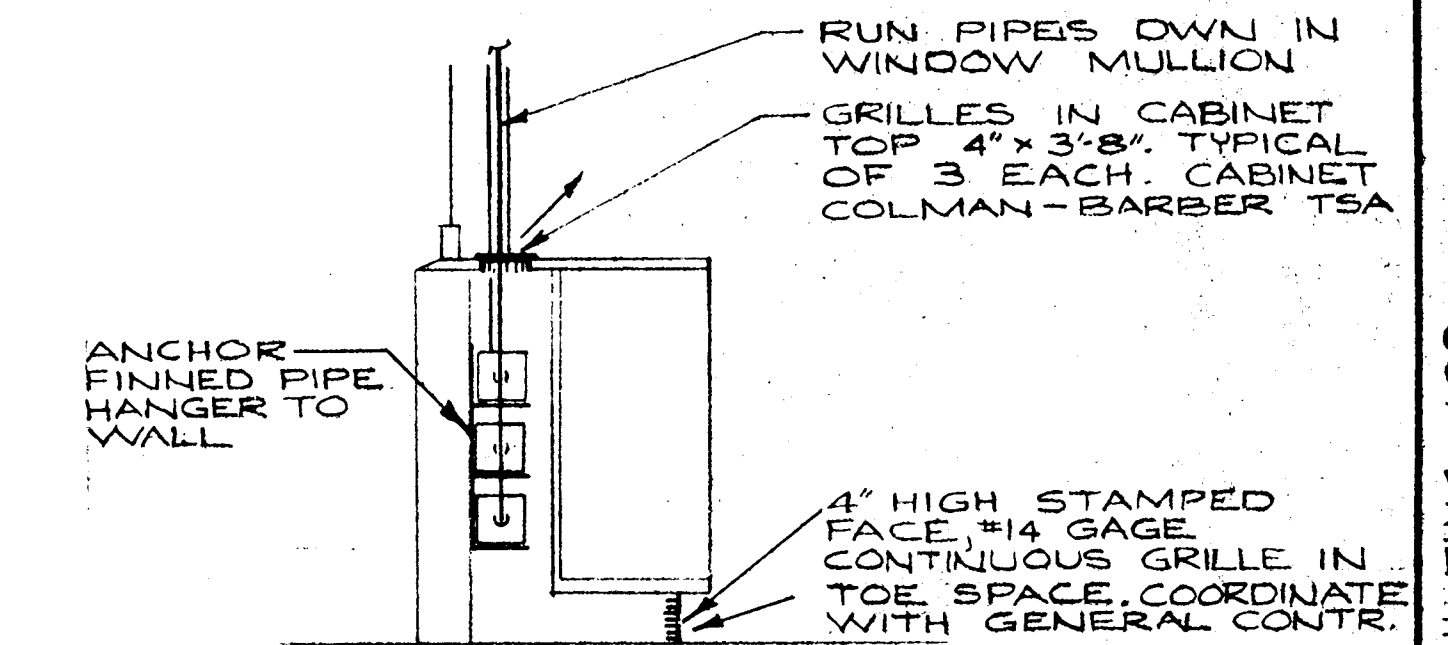

(M-3) 2 TYPICAL CLASSROOM FINED PIPE DETAIL
SCALE: 3/4" = 1'-0"

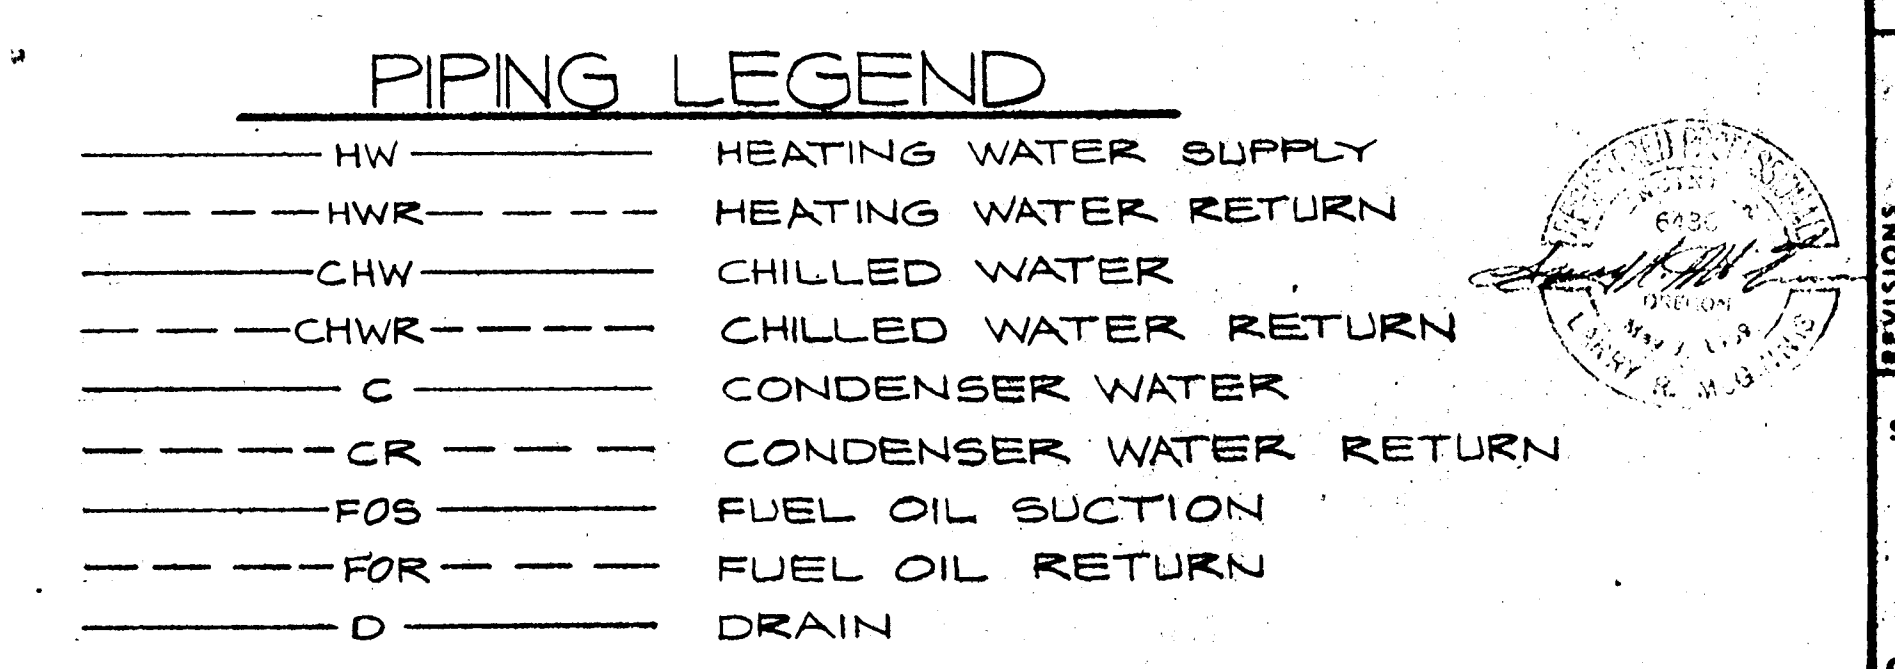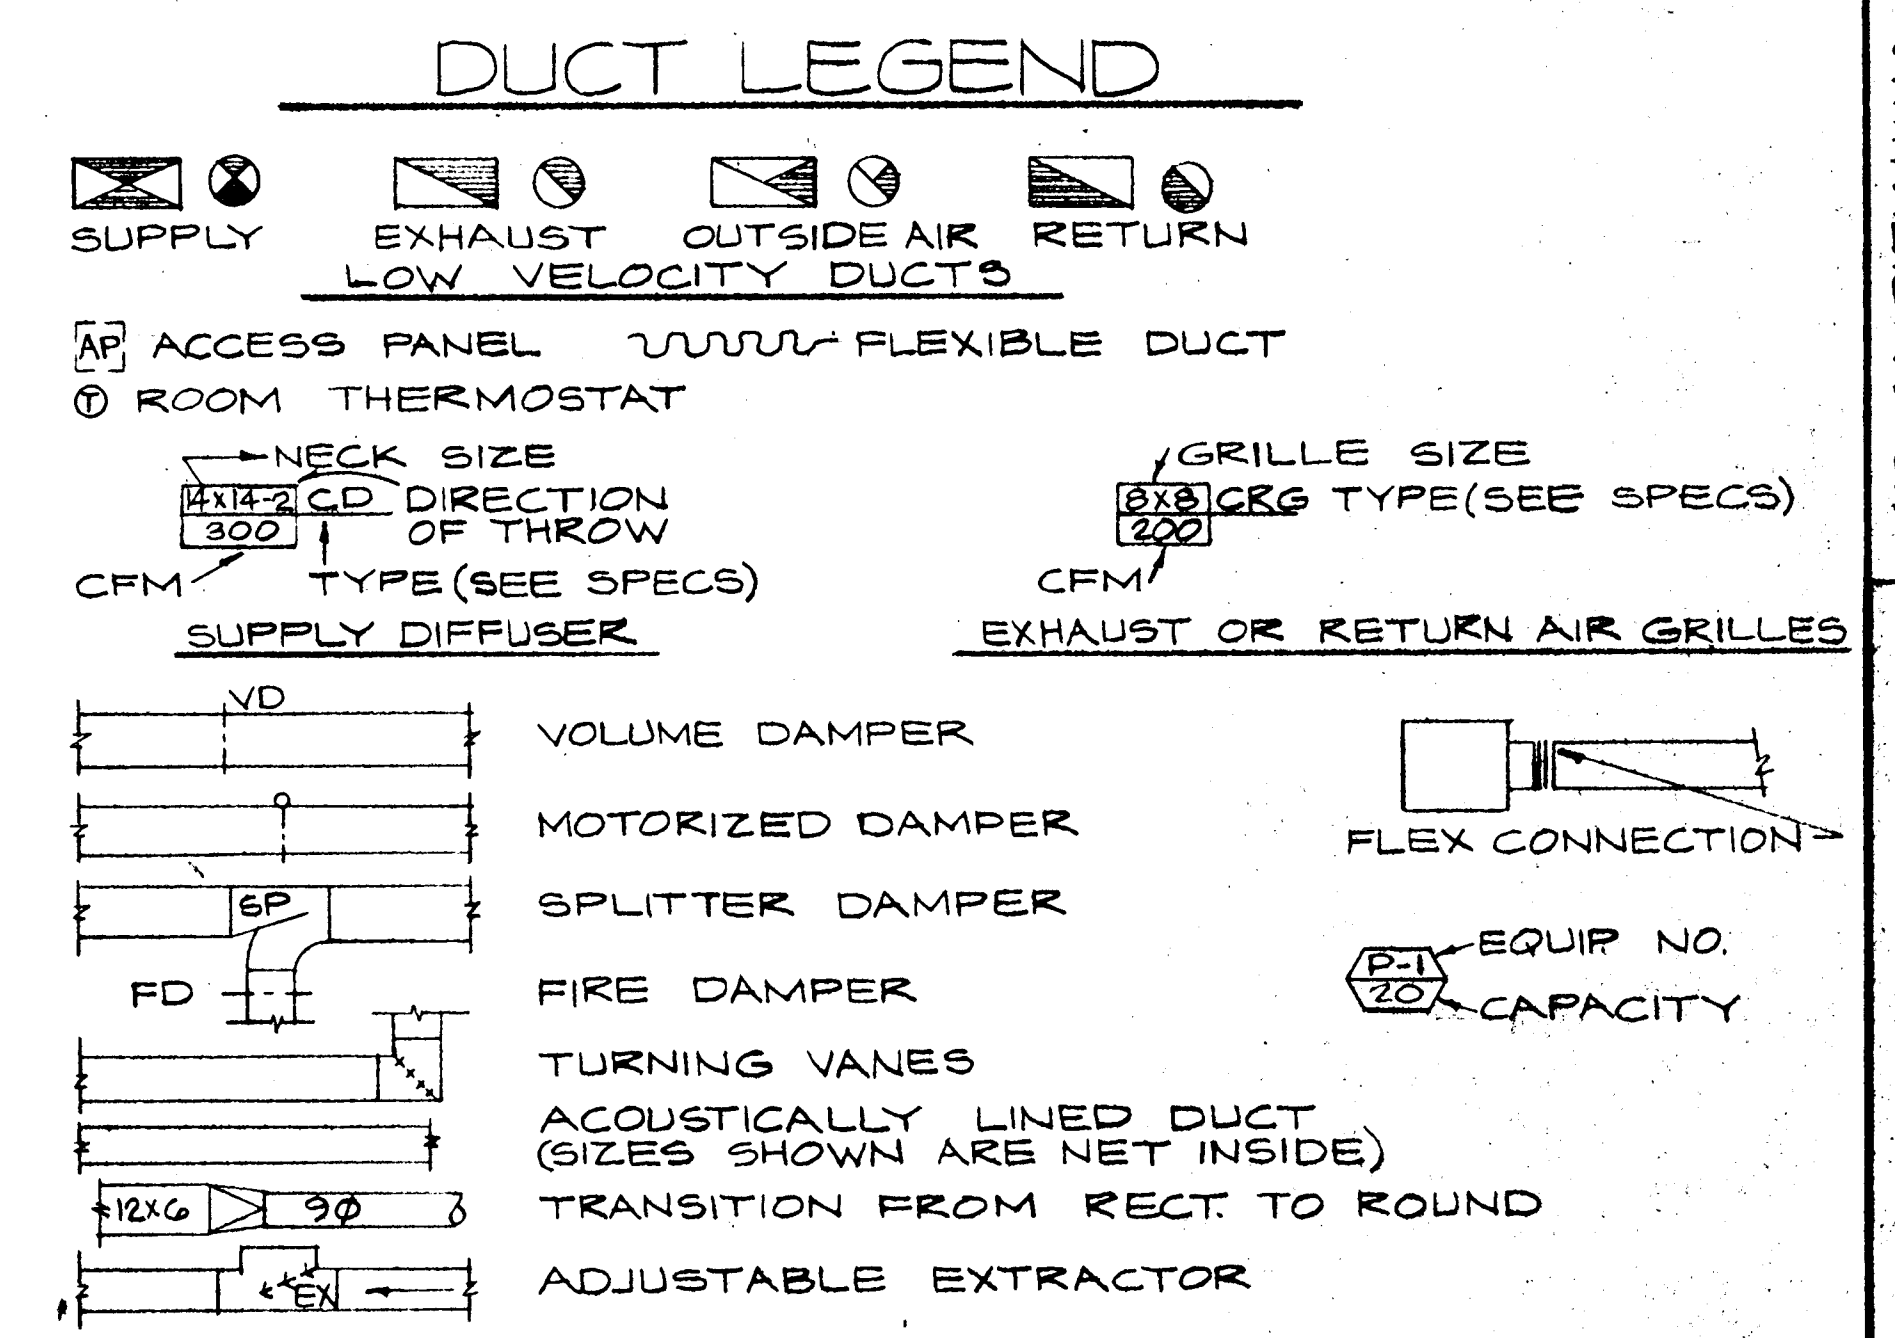

- NOTES**
- COORDINATE LOCATION OF ALL CEILING DIFFUSERS & GRILLES WITH LIGHT FIXTURES & T-BAR
 - INSTALL FIRE DAMPERS IN ALL CEILING PENETRATIONS
 - INSTALL VOLUME DAMPERS IN ALL BRANCH DUCTS

(M-3) BUILDING 100 FLOOR PLAN - AIR CONDITIONING
SCALE: 1/8" = 1'-0"

AIR CONDITIONING PLAN - BUILDING 100
SW. BROCKMAN ROAD AND SW. DAVIES ROAD
BEAVERTON, OREGON

WILLIAMS & EHMANN AIA
ARCHITECTS-PLANNERS
3777 S.E. MILWAUKEE AVENUE
PORTLAND, ORE. 97202 503-232-1195

ELEMENTARY SCHOOL - SCHOOL DISTRICT 48
BEAVERTON, WASHINGTON COUNTY, OREGON


REVISIONS
DRAWN DP
CHECKED
DATE 1-20-74
COM 73-07
FILE

SHEET
M 3
OF 11

5

NOTES

- 1 SOILED DISH SINK & DISPOSAL FURNISHED BY OTHERS. PLUMBER SHALL PROVIDE CONNECTIONS TO INCLUDE TRAP, SUPPLIES, STOPS & WATER.
- 2 BOOSTER HEATER FURNISHED BY OTHERS. SEE DETAIL (M-2) FOR CONNECTIONS.
- 3 DISHWASHER FURNISHED BY OTHERS. PLUMBER SHALL PROVIDE CONNECTIONS TO INCLUDE TRAP, SUPPLIES, STOPS & WATER.
- 4 POT SINK FURNISHED BY OTHERS. PLUMBER SHALL PROVIDE CONNECTIONS TO INCLUDE TRAP, SUPPLIES, STOPS & WATER.

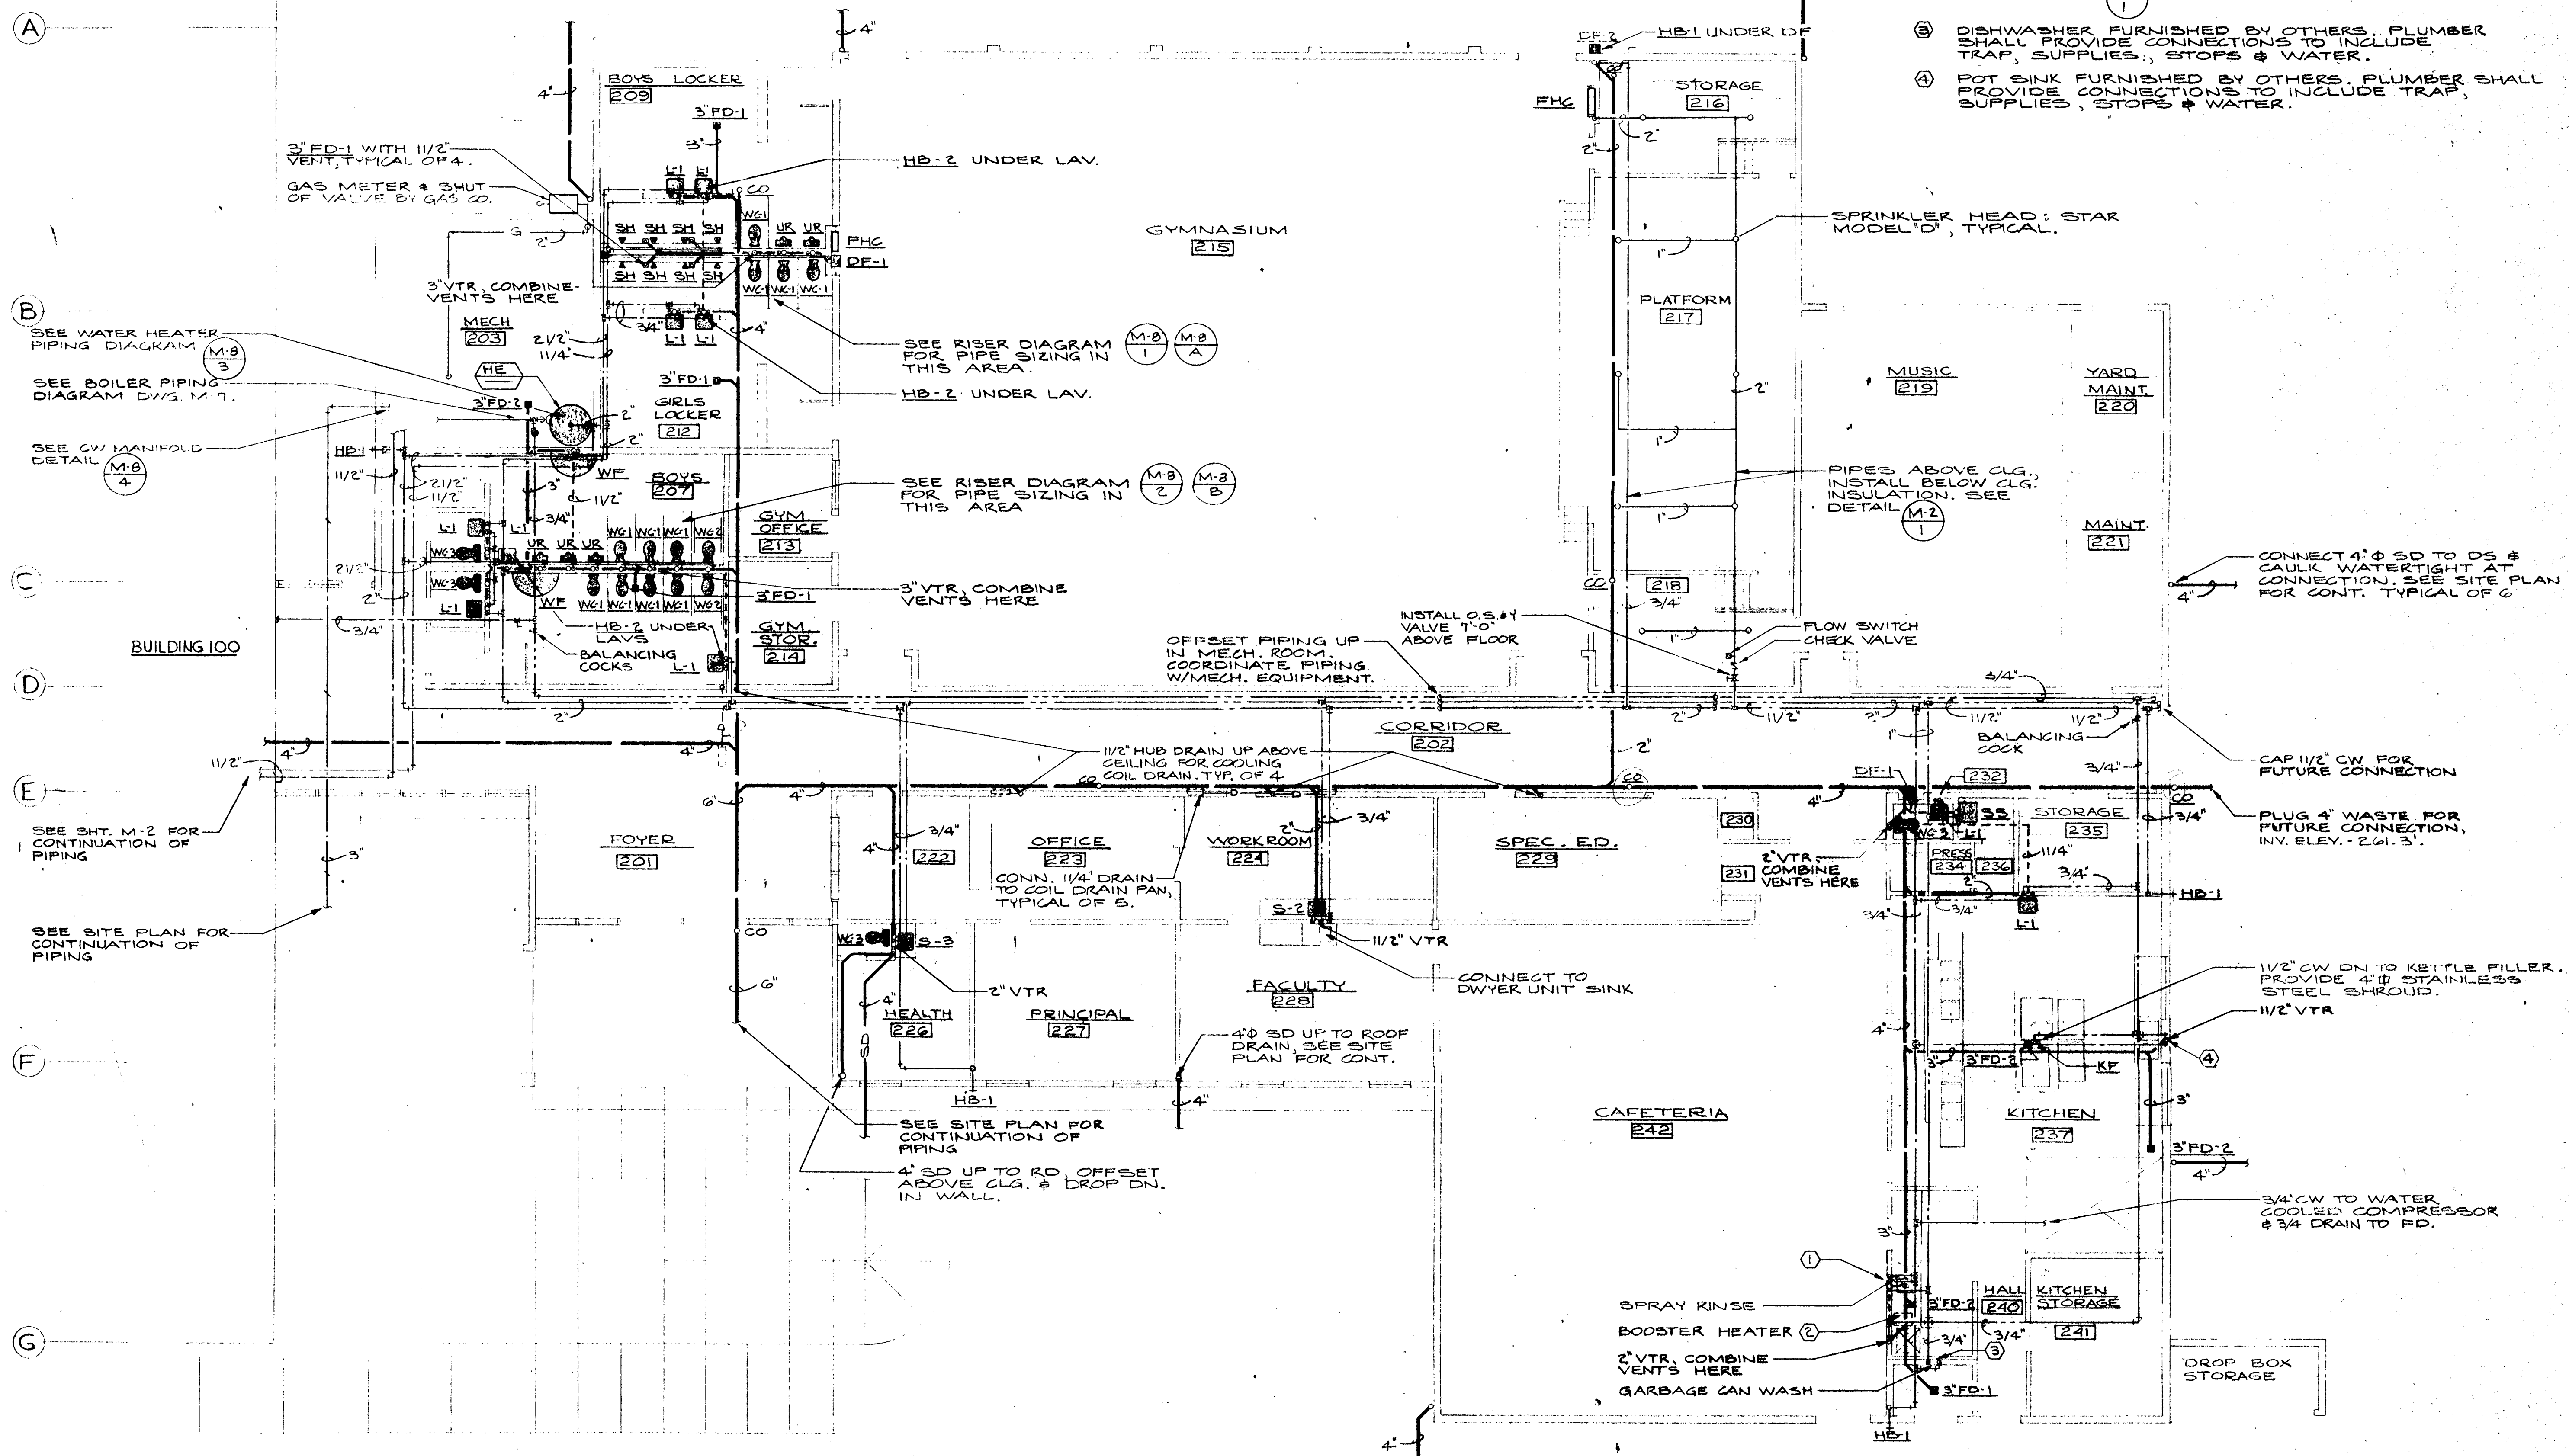

(M-4) BUILDING 200 FLOOR PLAN - PLUMBING
SCALE: 1/8" = 1'-0"

PLUMBING PLAN - BUILDING 200
SW. BECKMAN ROAD AND SW DAVIES ROAD
BEAVERTON, OREGON

WILLIAMS & EHMANN AIA
ARCHITECTS-PLANNERS
3777 S.E. MILWAUKEE AVENUE
PORTLAND, ORE 97215
503-233-1115


REGION 2
SHEET 22
DATE 1-2-74
DRAWN BY J.M.
CHECKED BY J.M.
FILE

MA



NOTES THIS SHEET

- ① COMBINE EXH. DUCTS TO 16" Ø. RUN UP EF ON ROOF
- ② COORDINATE CEILING DIFFUSER LAYOUT W/ LIGHTS & T-BAR GRID
- ③ RAISE SA DUCT TO RUN ABOVE RA DUCT
- ④ INSTALL FIRE DAMPERS IN ALL GRILLES + DIFFUSERS PENETRATING CEILINGS.
- ⑤ INSTALL GRAVITY ROOF VENTILATOR 24" X 24" NECK SIZE. PLACE SKY-CAP WITH BIRD SCREEN.
- ⑥ INSTALL VOLUME DAMPERS IN ALL BRANCH DUCTS.
- ⑦ INSTALL 24" X 24" ACCESS PANEL TO EQUIP. ABOVE CEIL. COORDINATE WITH CEIL. FINISH PATTERN + LIGHT FIXTURES AND FOR CLEAR ACCESS.
- ⑧ INSTALL GALVANIZED STEEL DRAIN PANS UNDER COILS WITH 1/4" DRAIN CONNECTIONS
- ⑨ PROVIDE 2-SPEED SWITCH FOR EXHAUST FANS FOR ELECTRICAL CONTRACTOR TO INSTALL

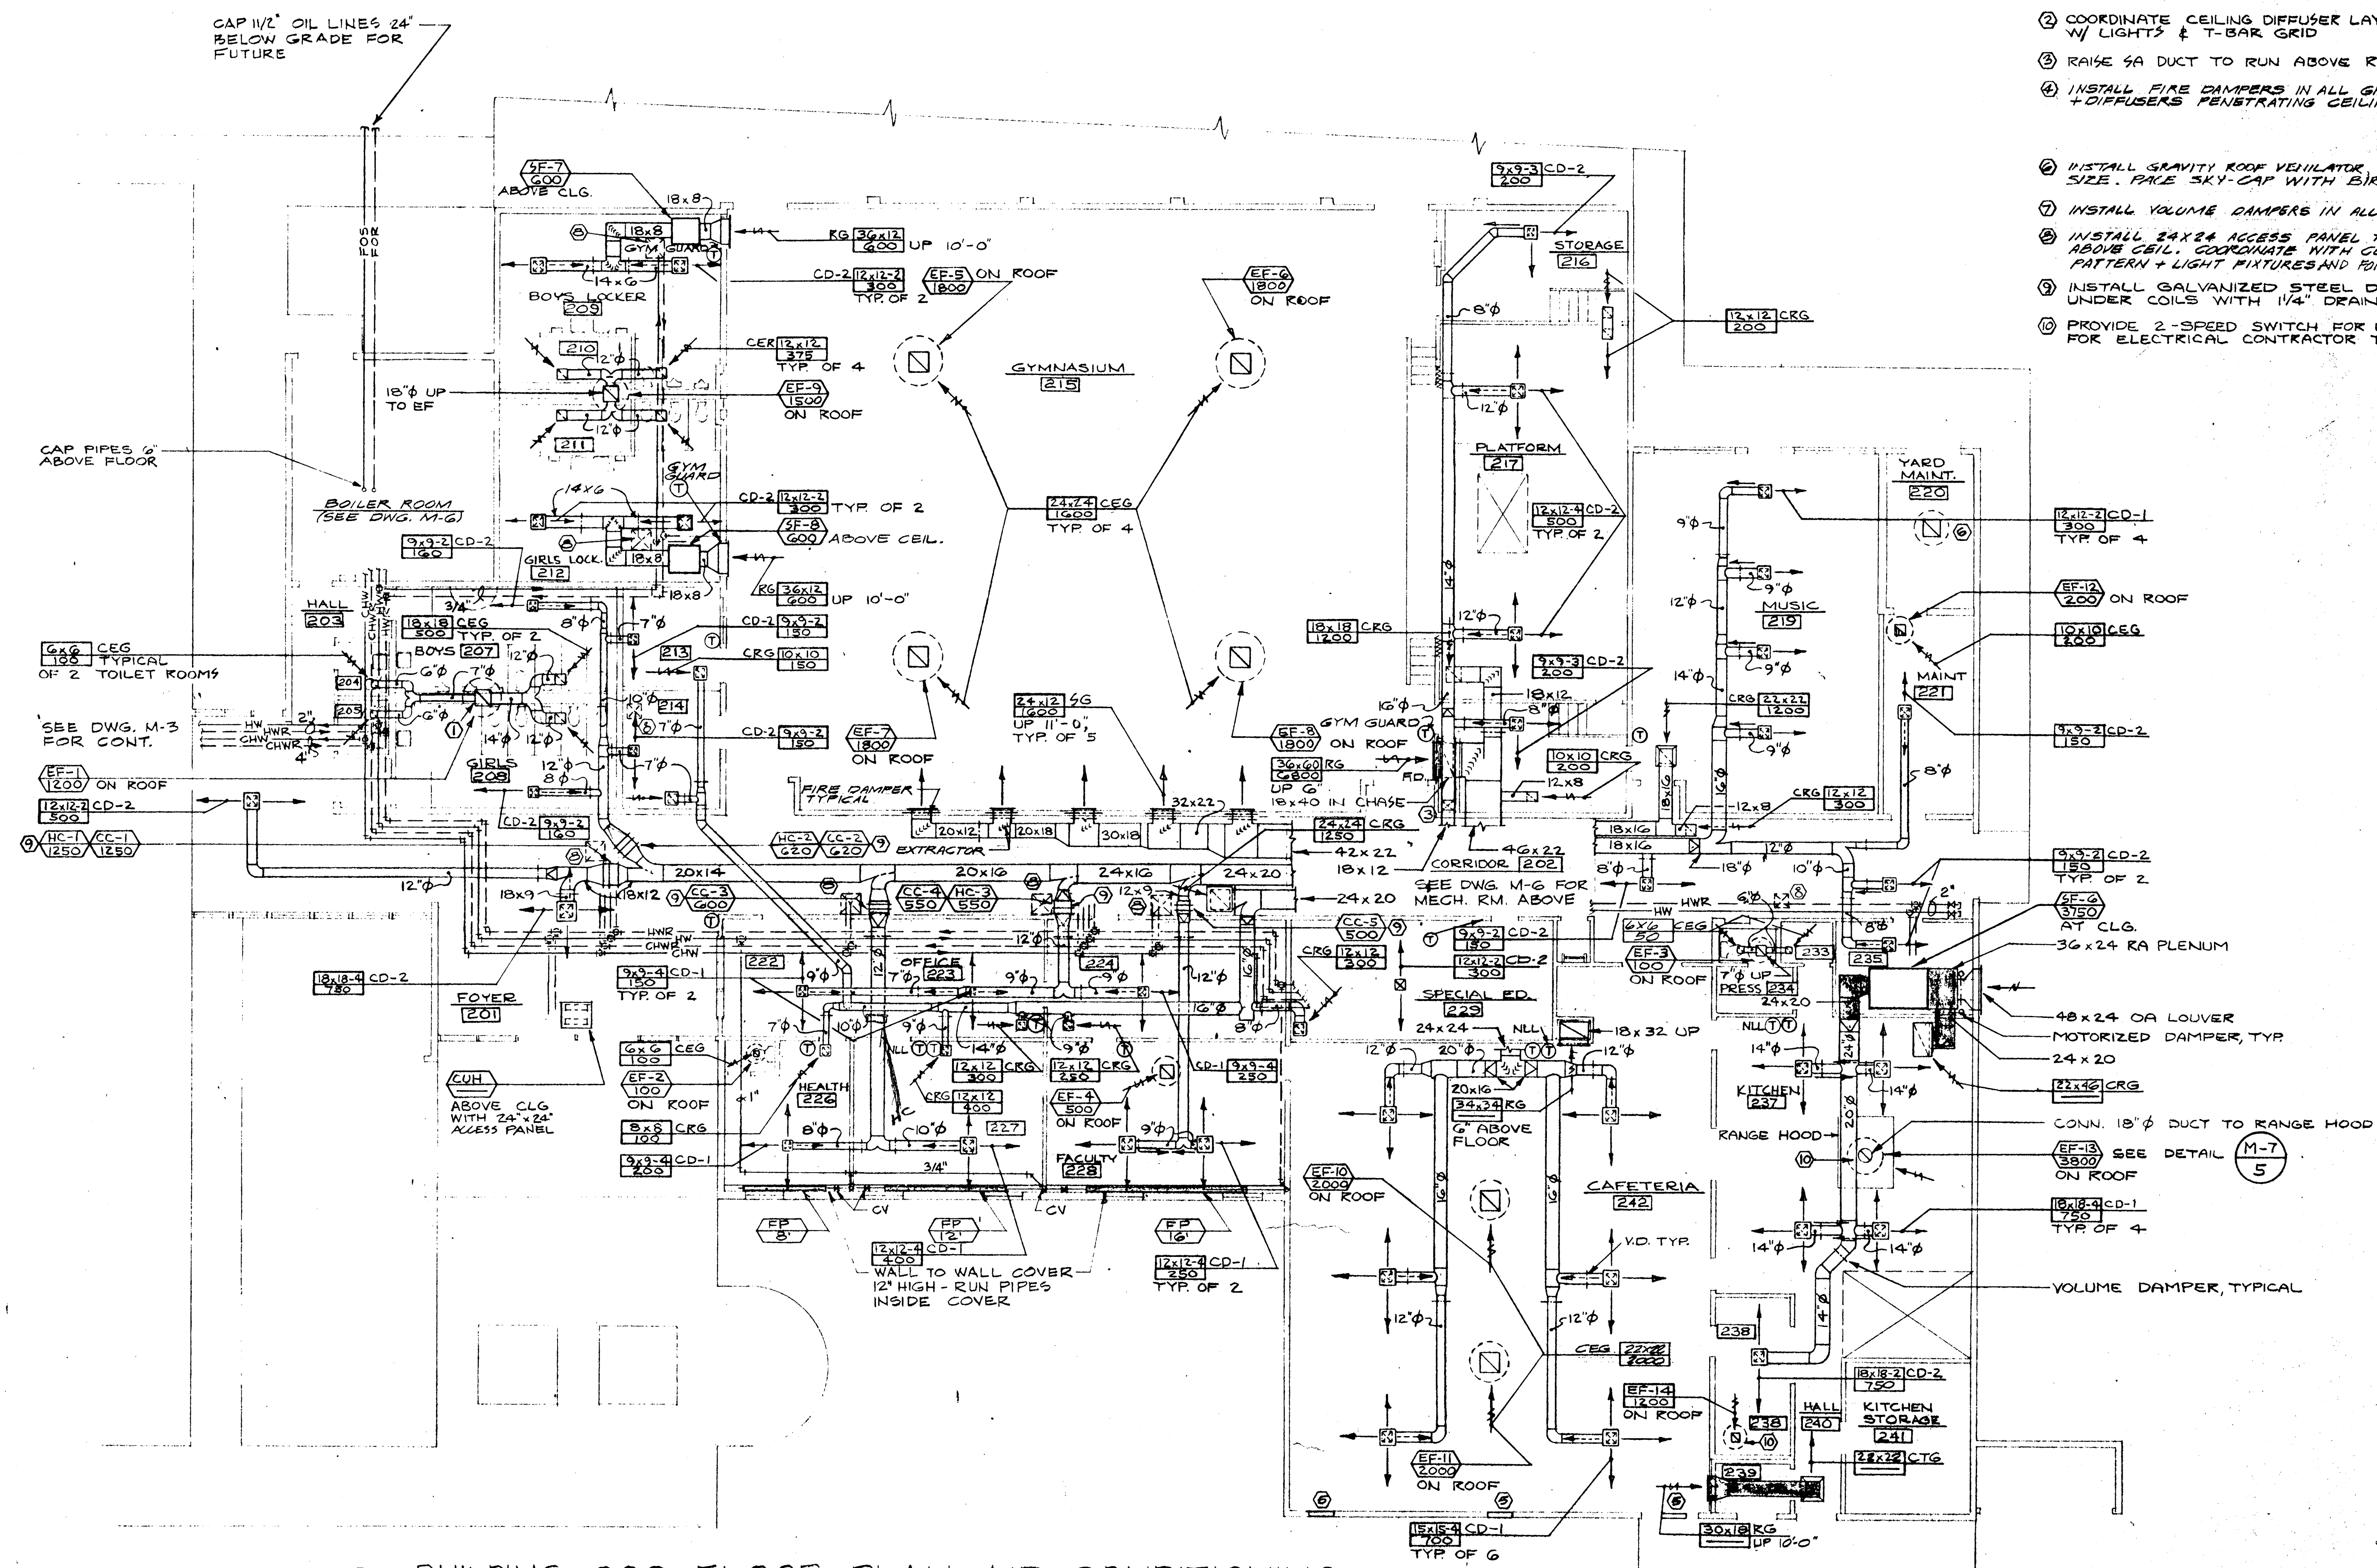


BUILDING 200 FLOOR PLAN-AIR CONDITIONING
 SCALE 1/8" = 1'-0"






AIR CONDITIONING PLAN - BUILDING 200
 SW. BROCKMAN ROAD AND SW. DAVIES ROAD
 BEAVERTON, OREGON
ELEMENTARY SCHOOL - SCHOOL DISTRICT 48
 WASHINGTON COUNTY, OREGON


WILLIAMS & EHMANN AIA
 ARCHITECTS-PLANNERS
 3777 S.E. MILWAUKEE AVENUE
 PORTLAND, ORE 97202 502-232-1195

REVISIONS	DATE	BY	FILE
DRAWN DP	1-30-74		
CHECK			
DATE			
CONN	78-67		
FILE			


SHEET **M 5**
 OF 11

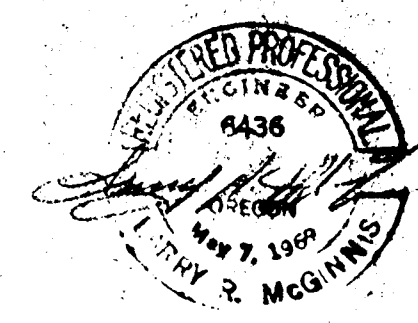

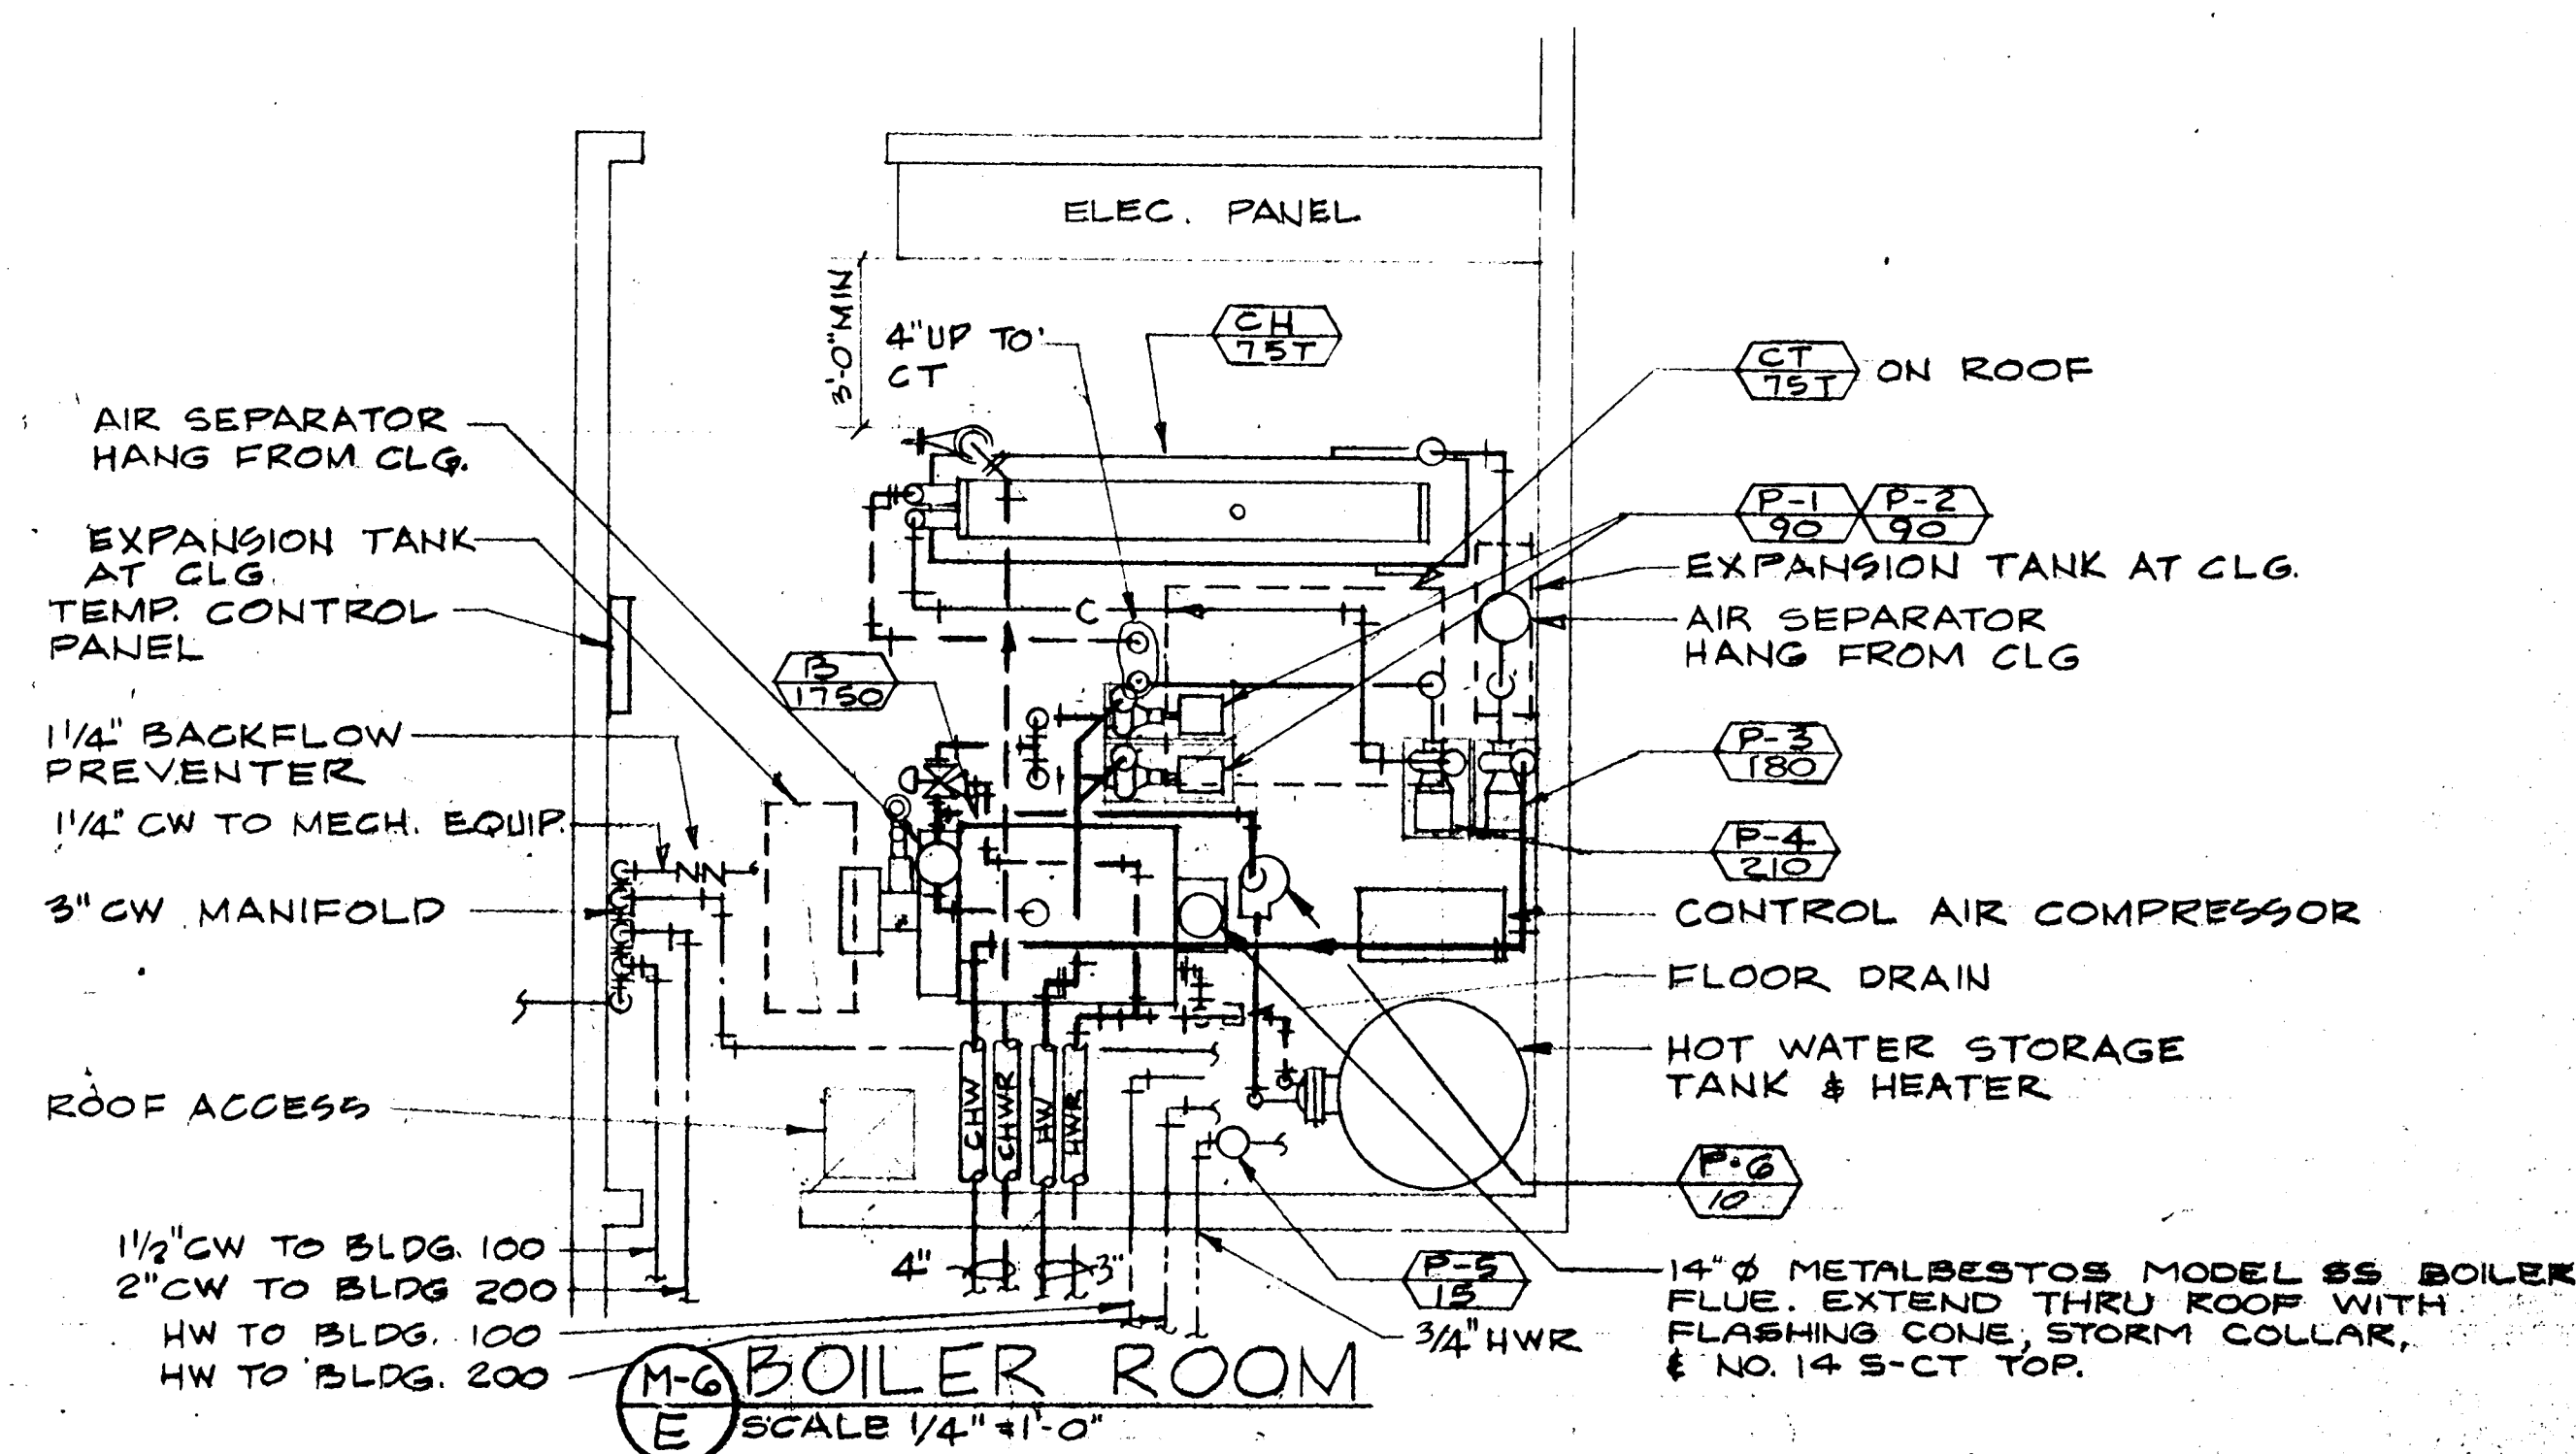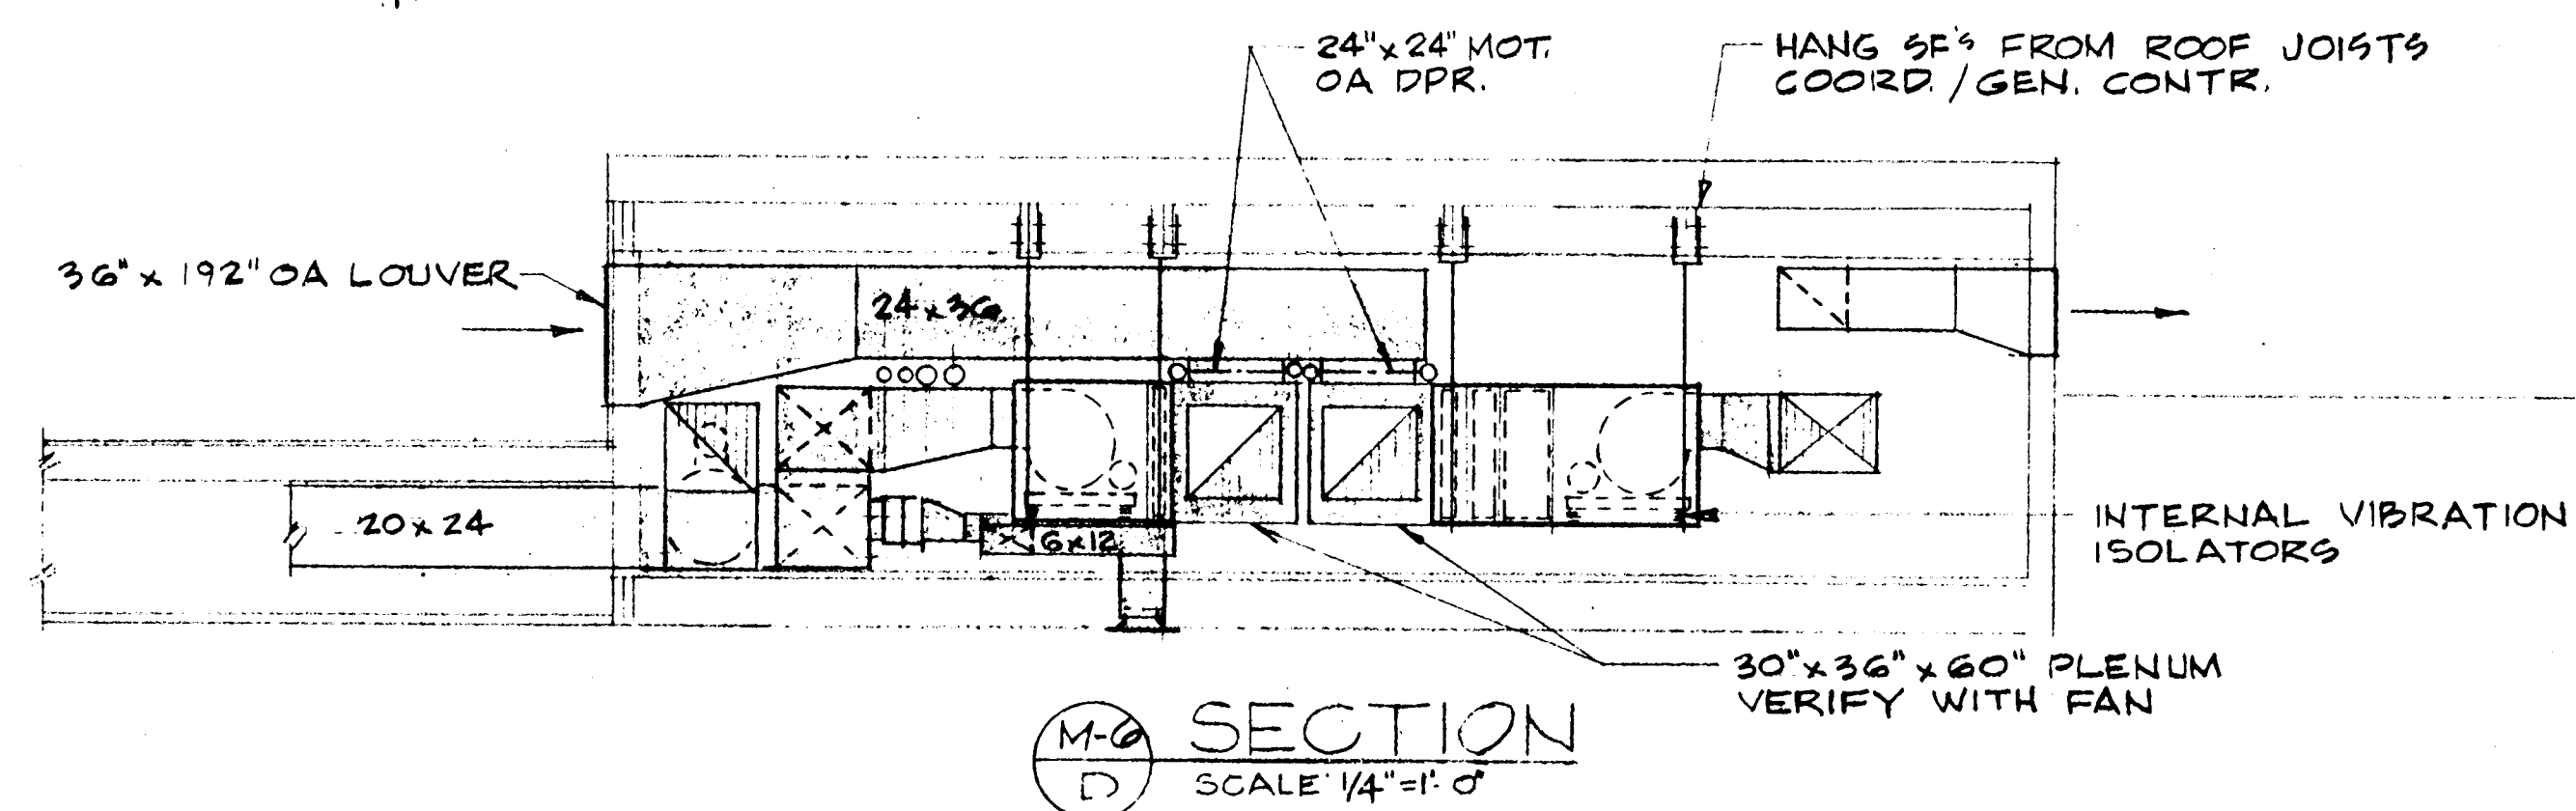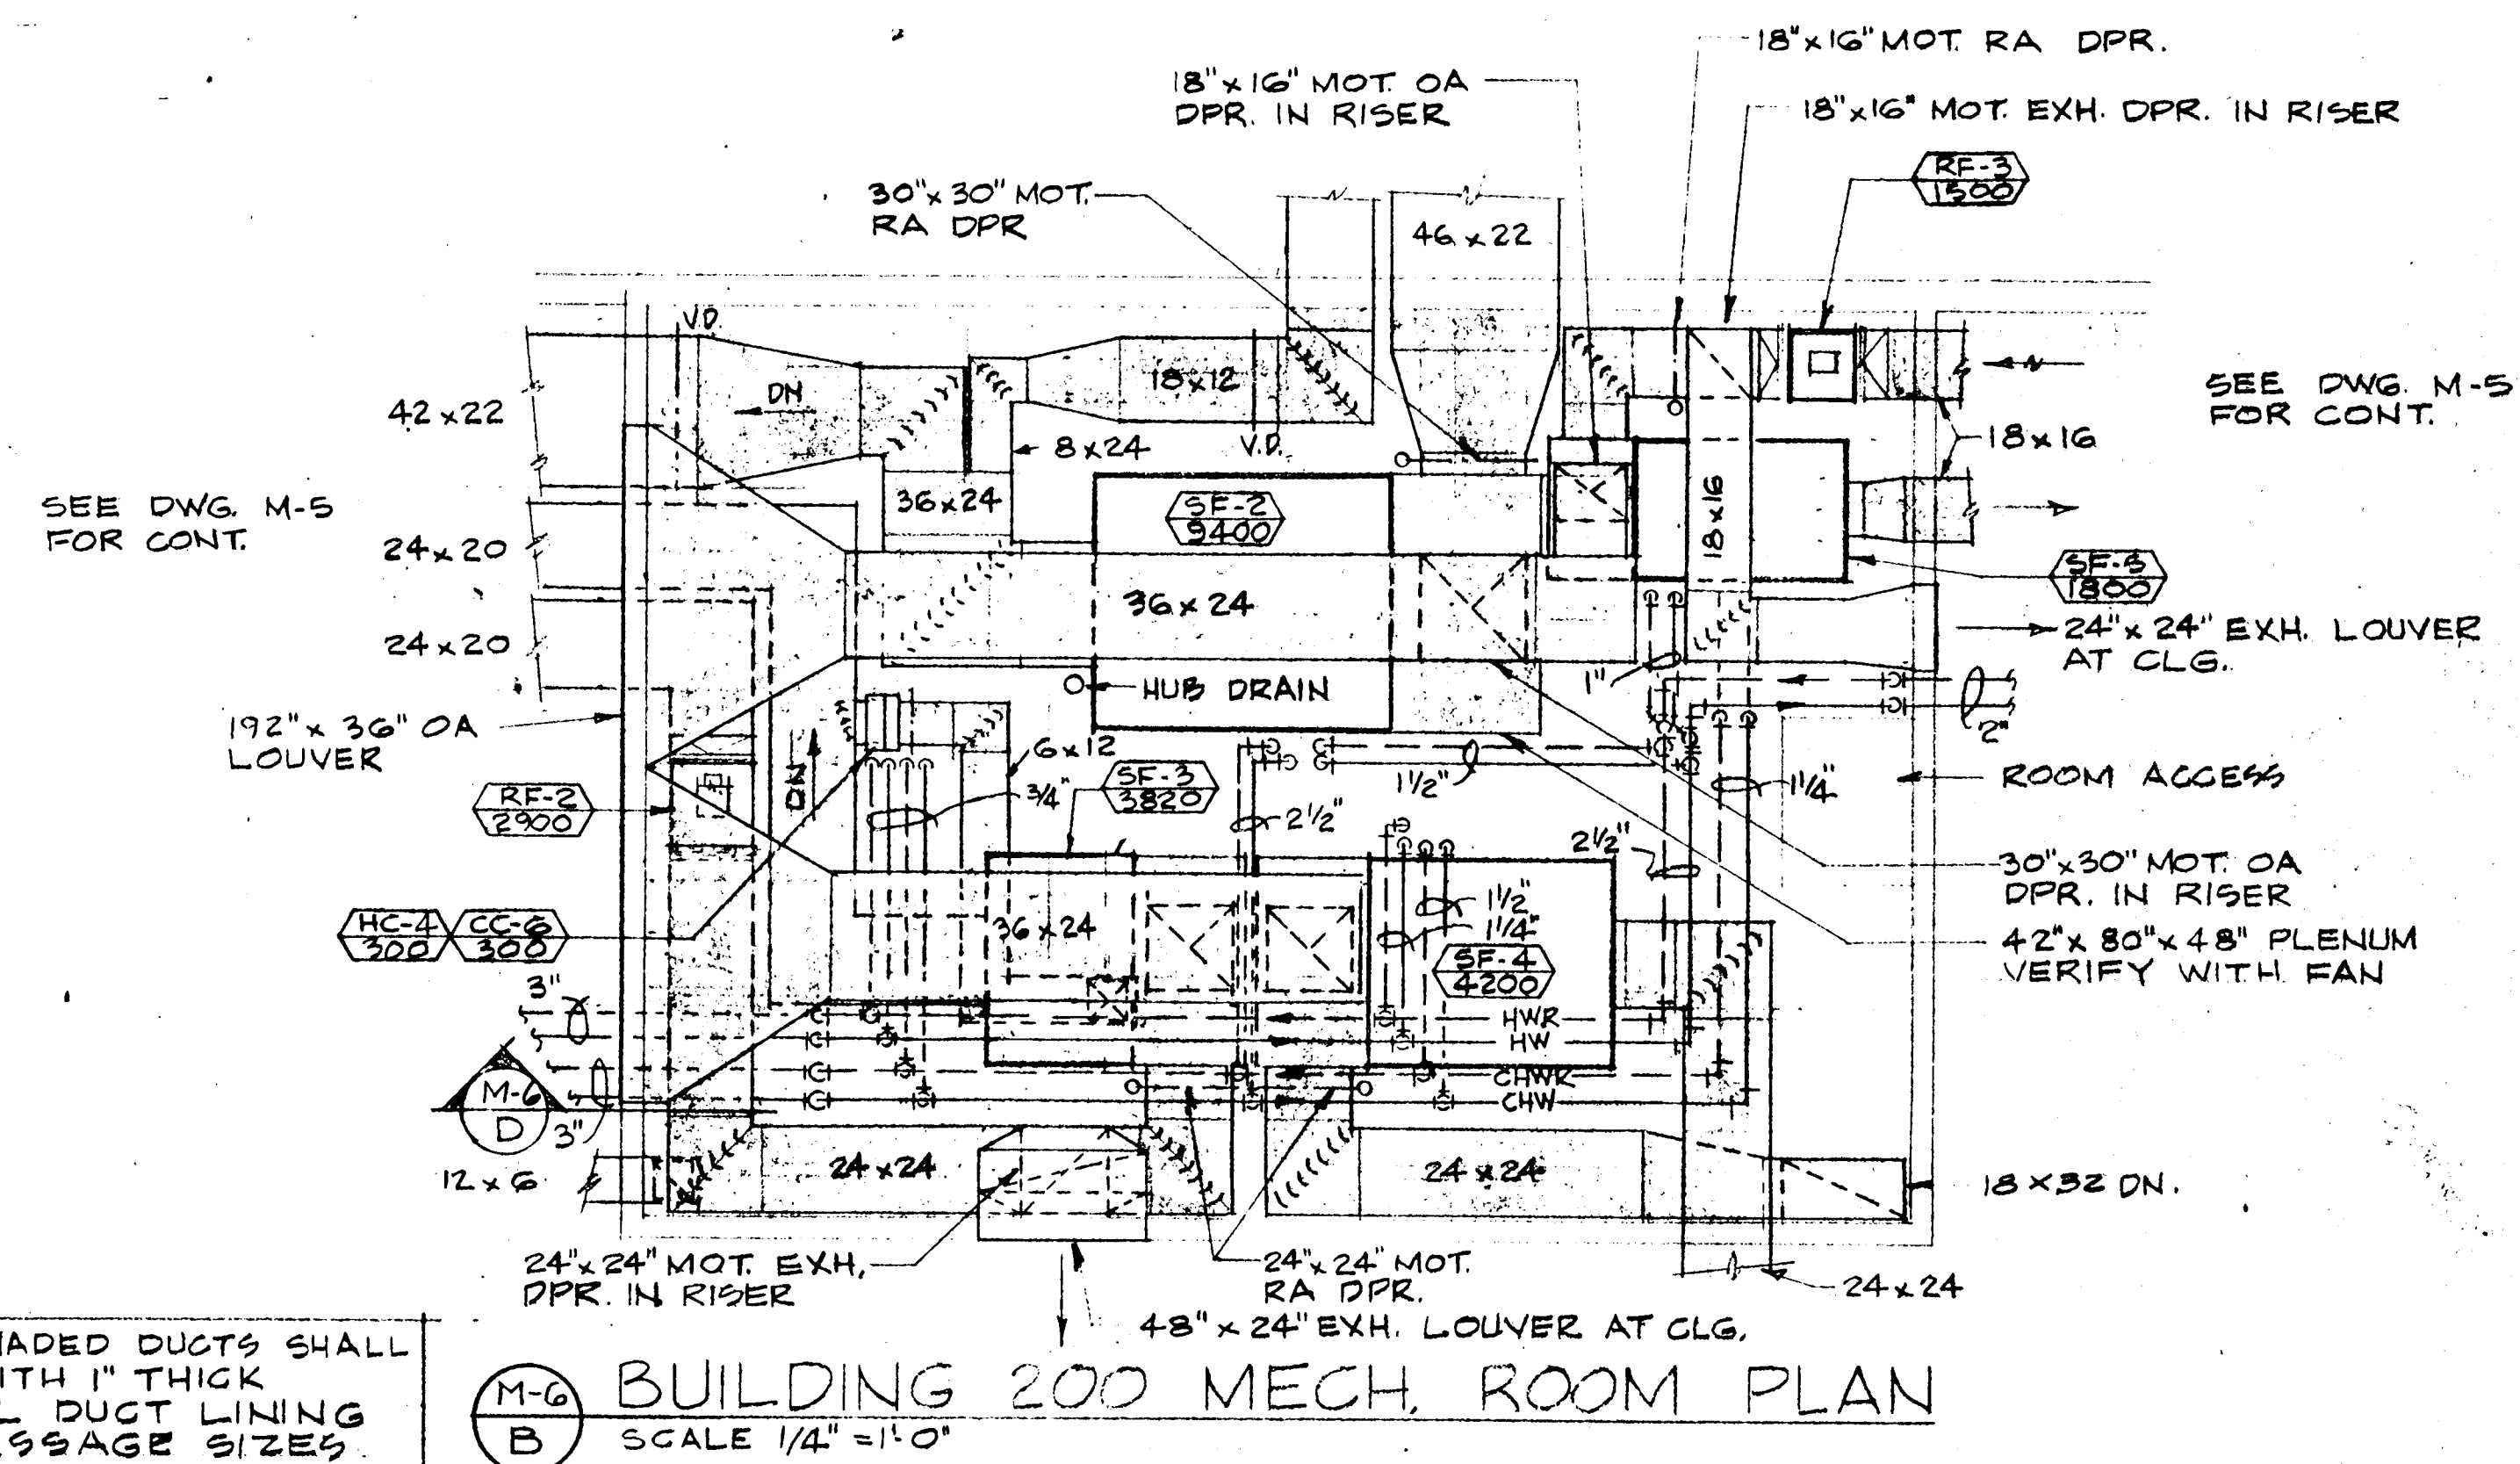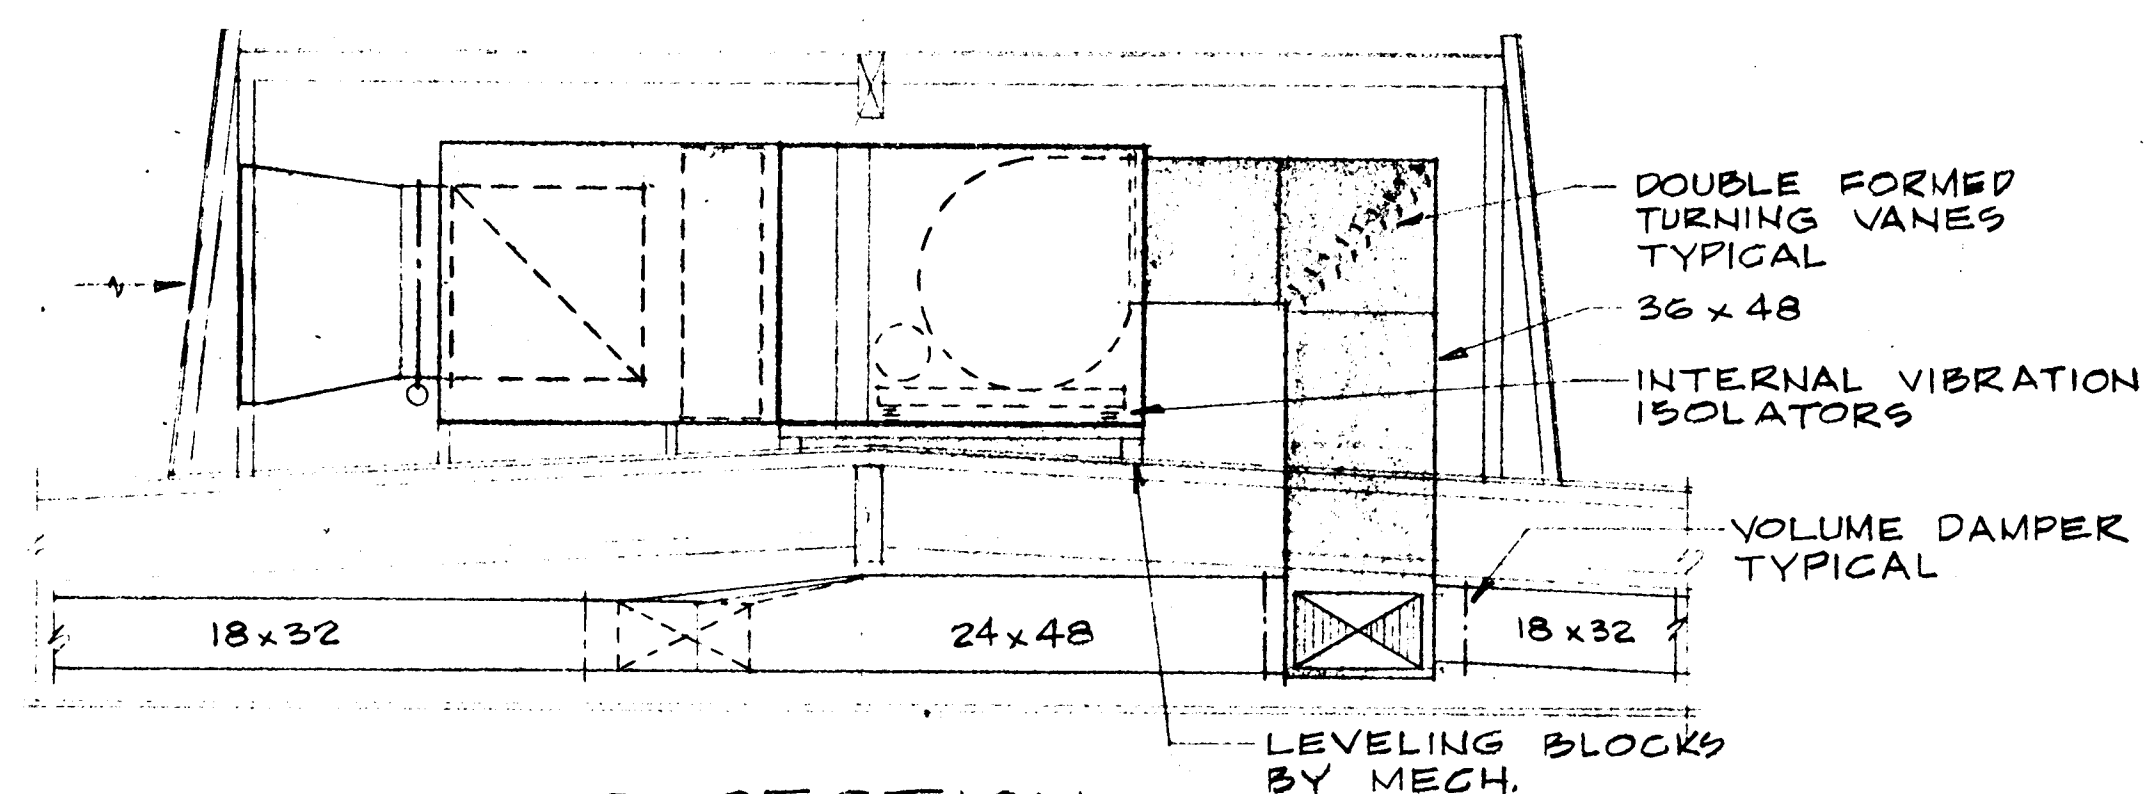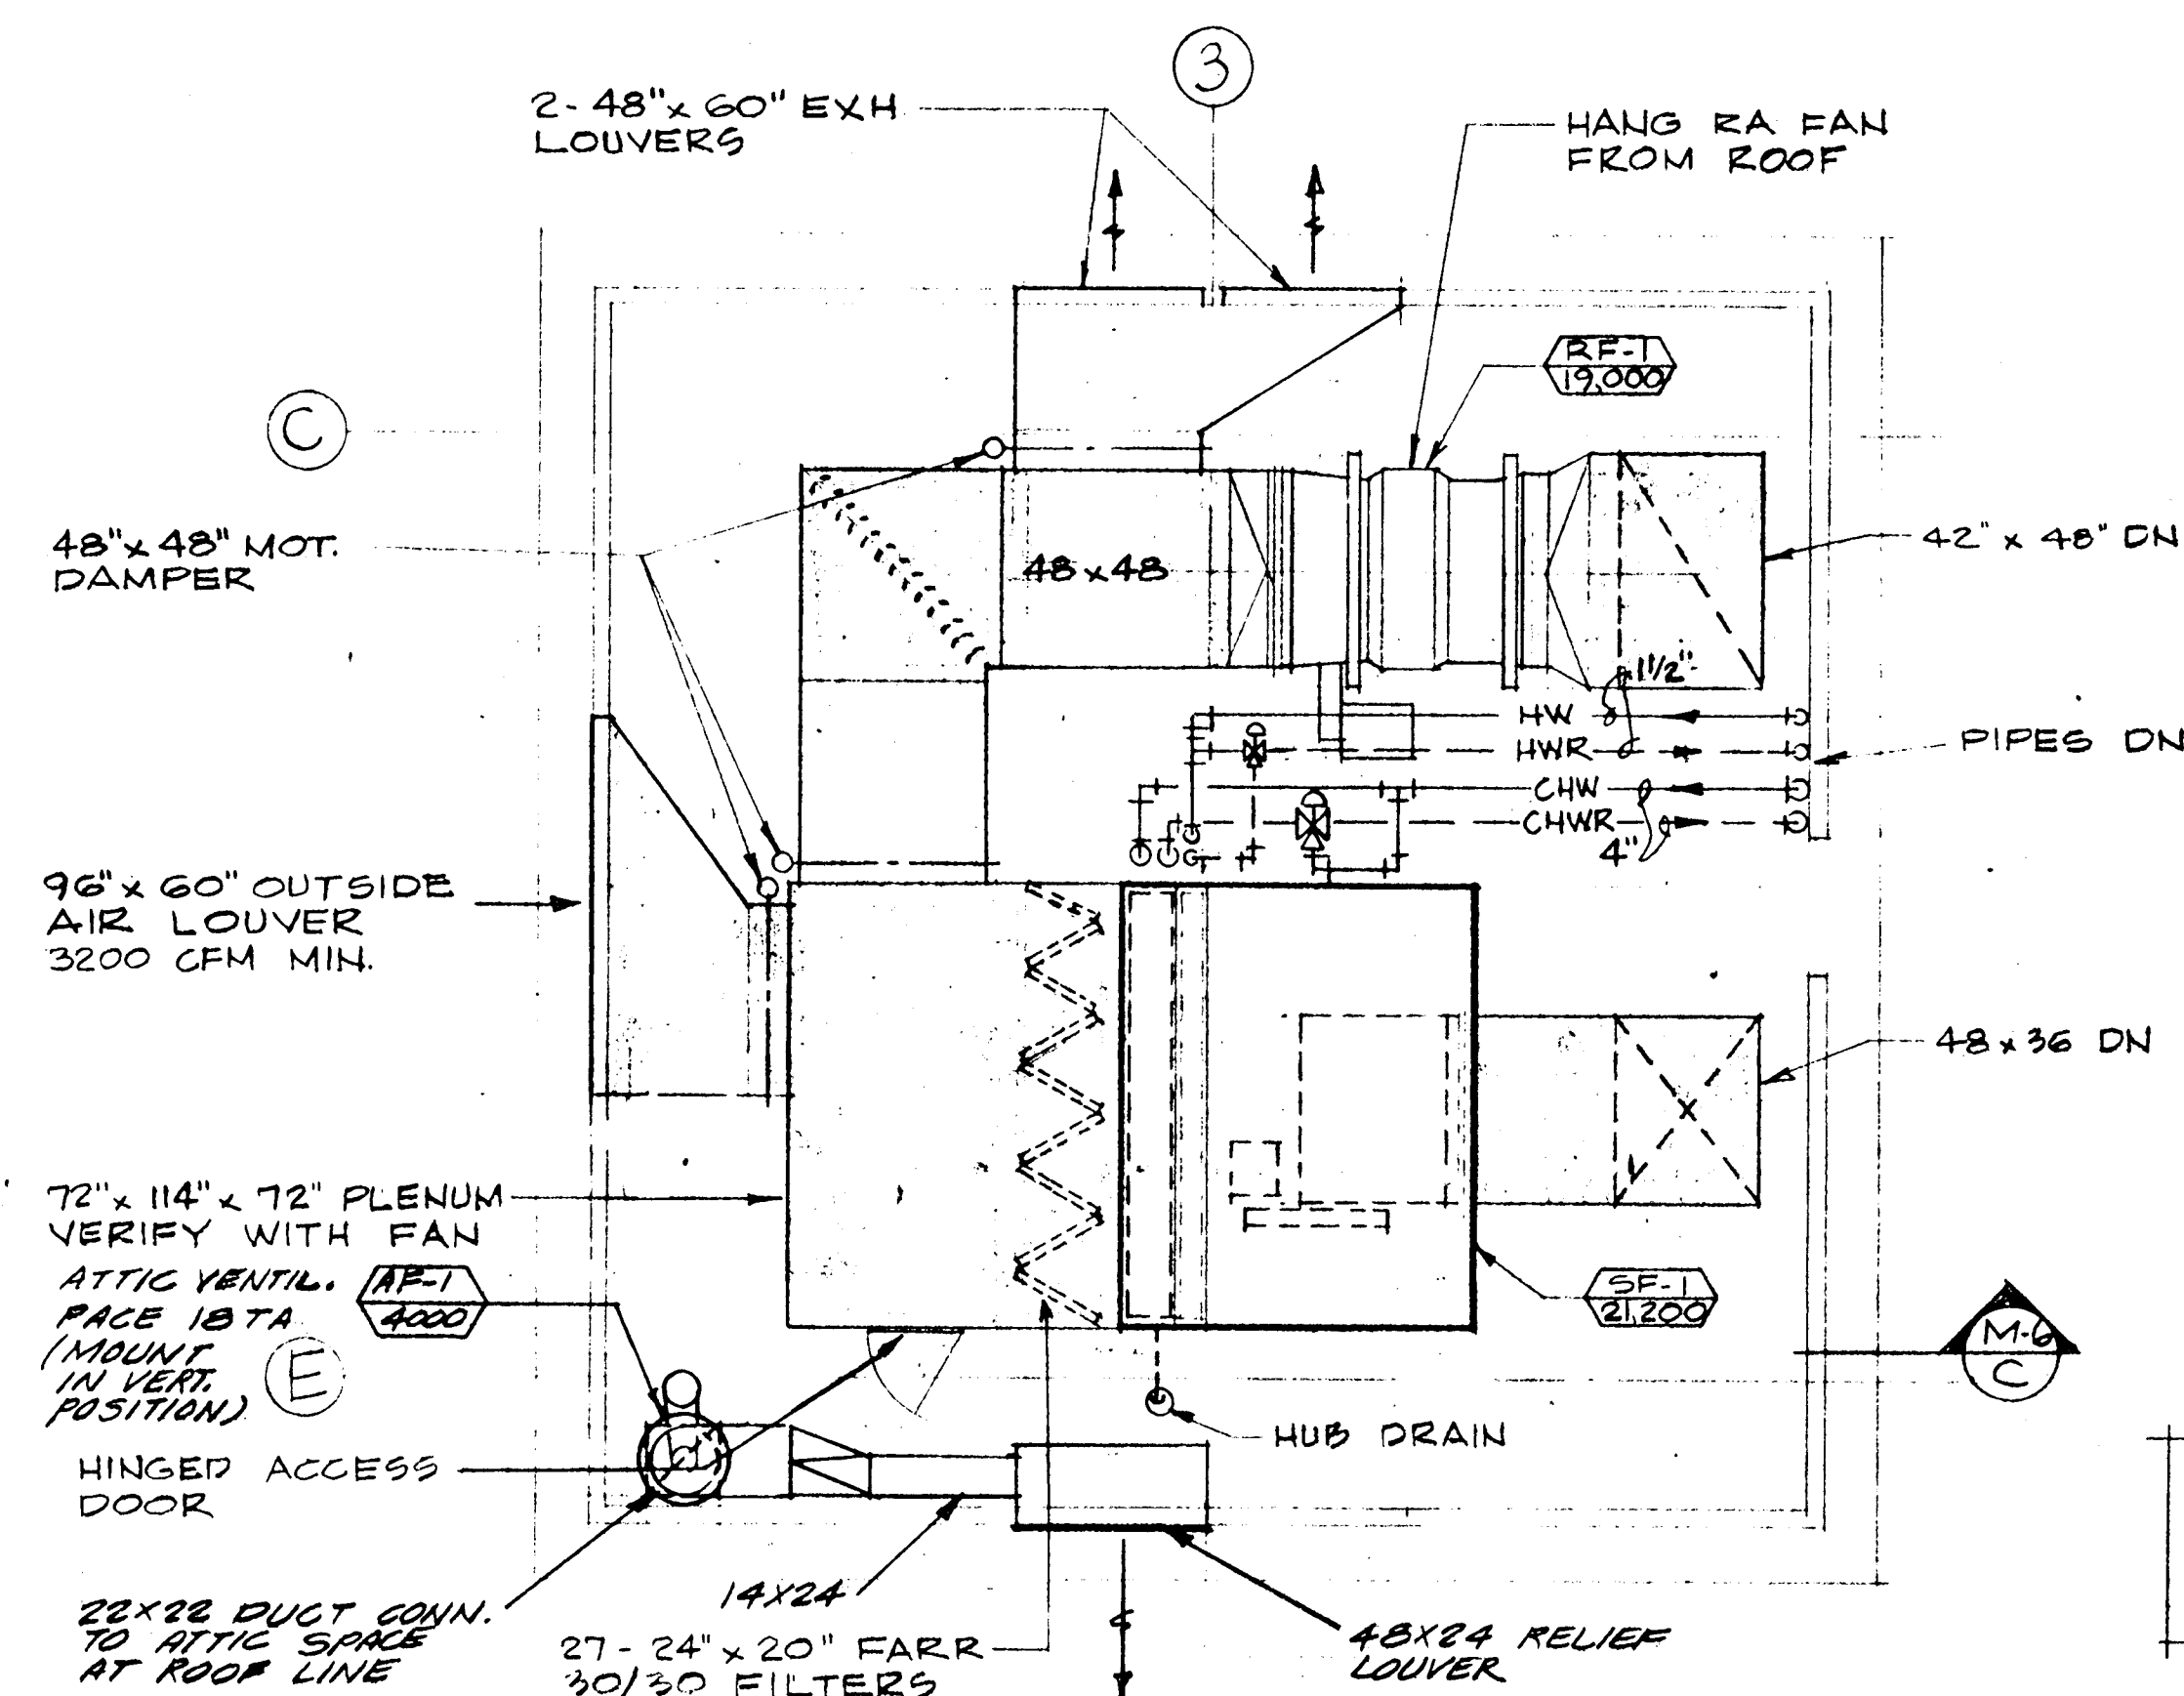


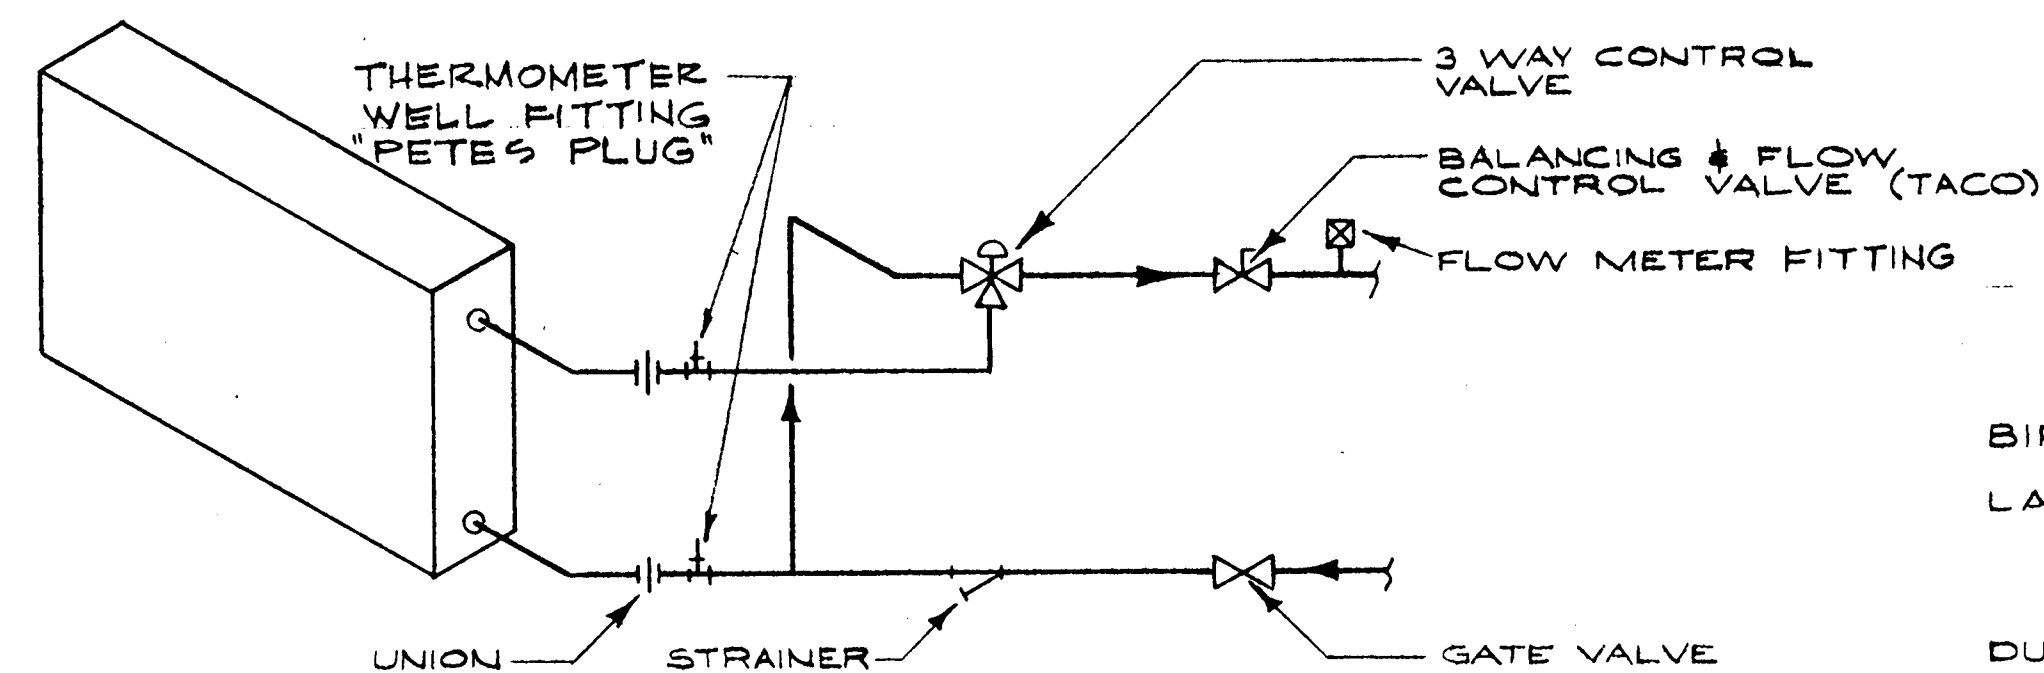


M-7
1 HEATING COIL DIAGRAM

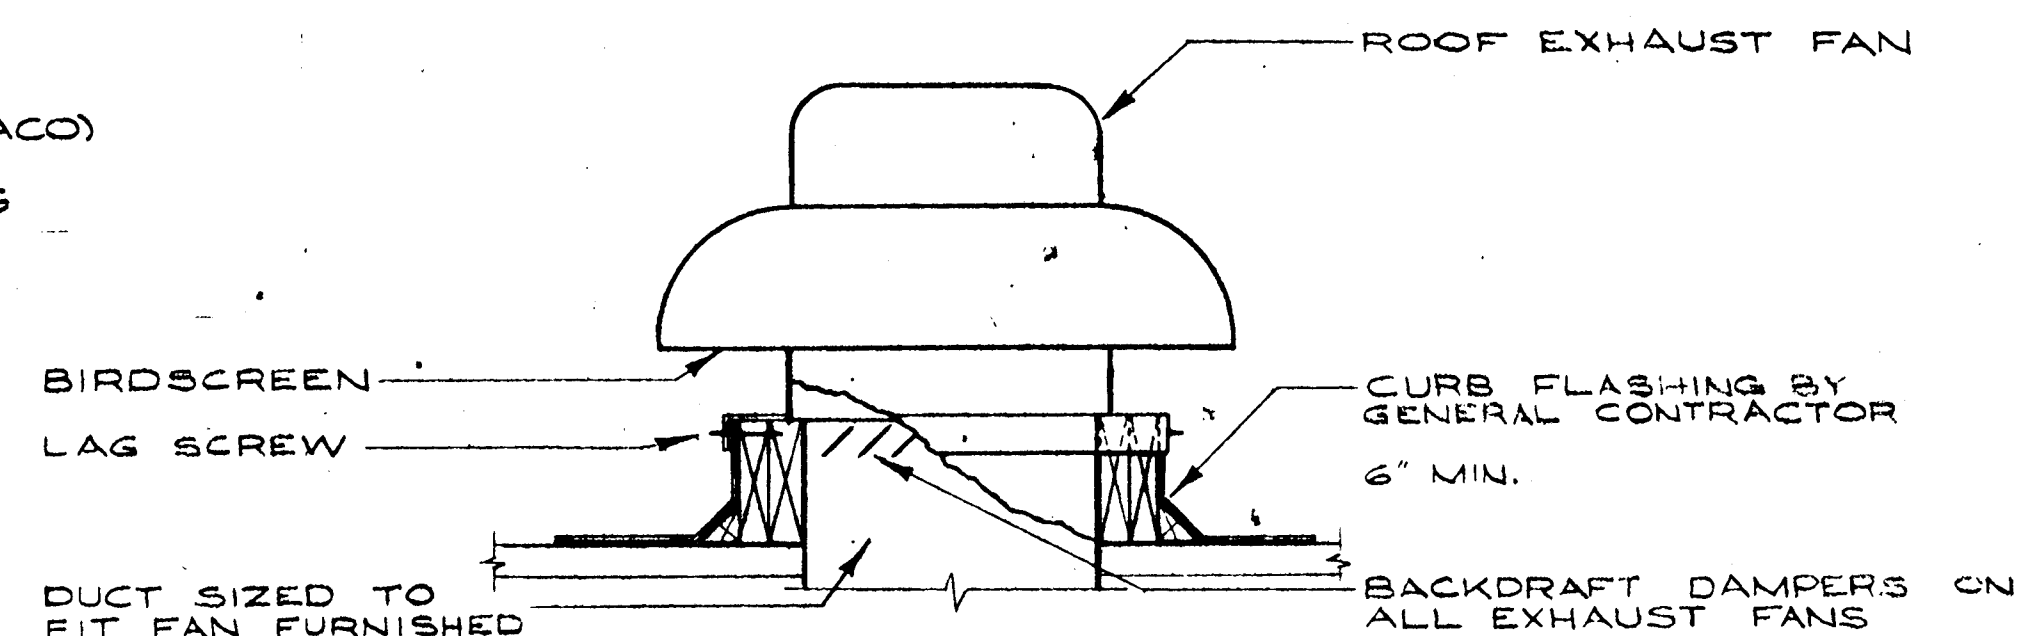


M-7
3 ROOF EXHAUST FAN DETAIL
N.T.S.

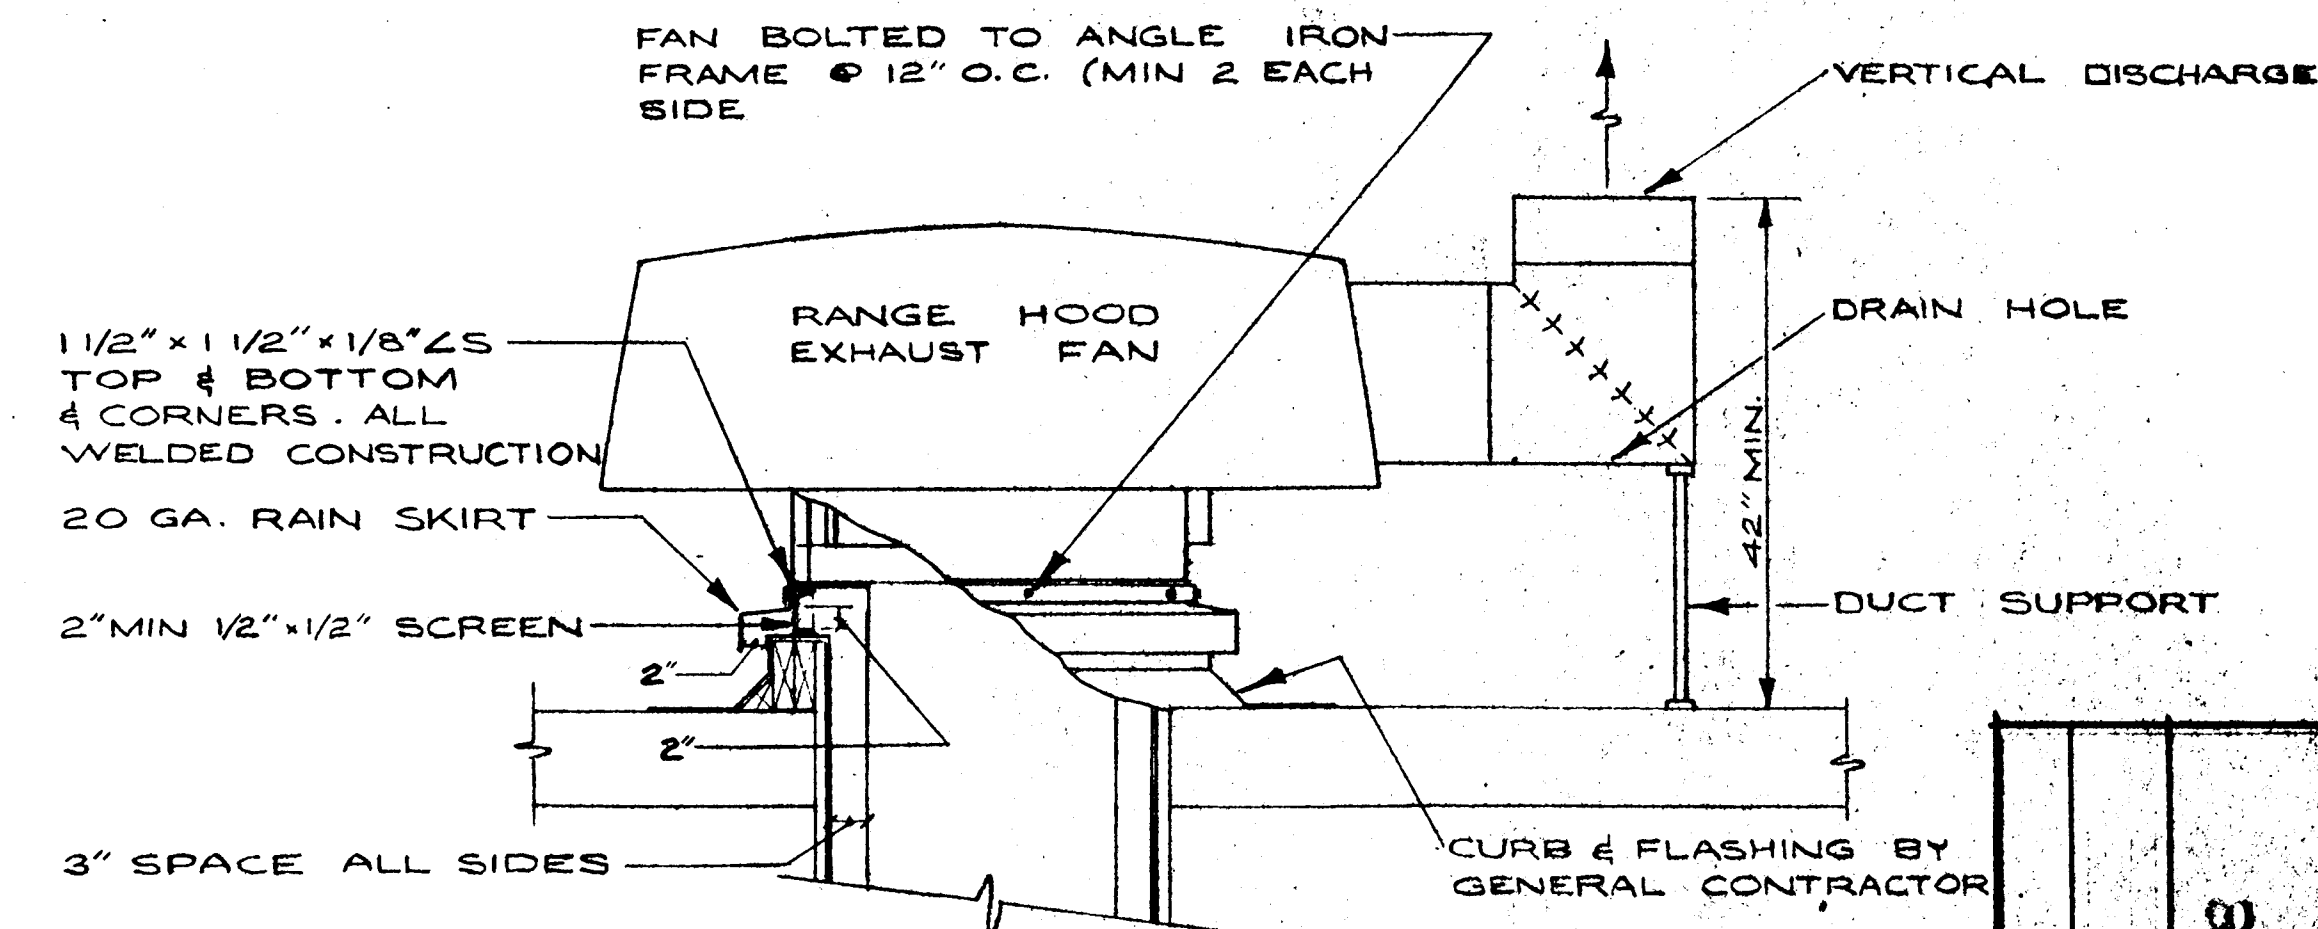


M-7
5 RANGE HOOD EXHAUST FAN DETAIL
SCALE: 3/4" = 1'-0"

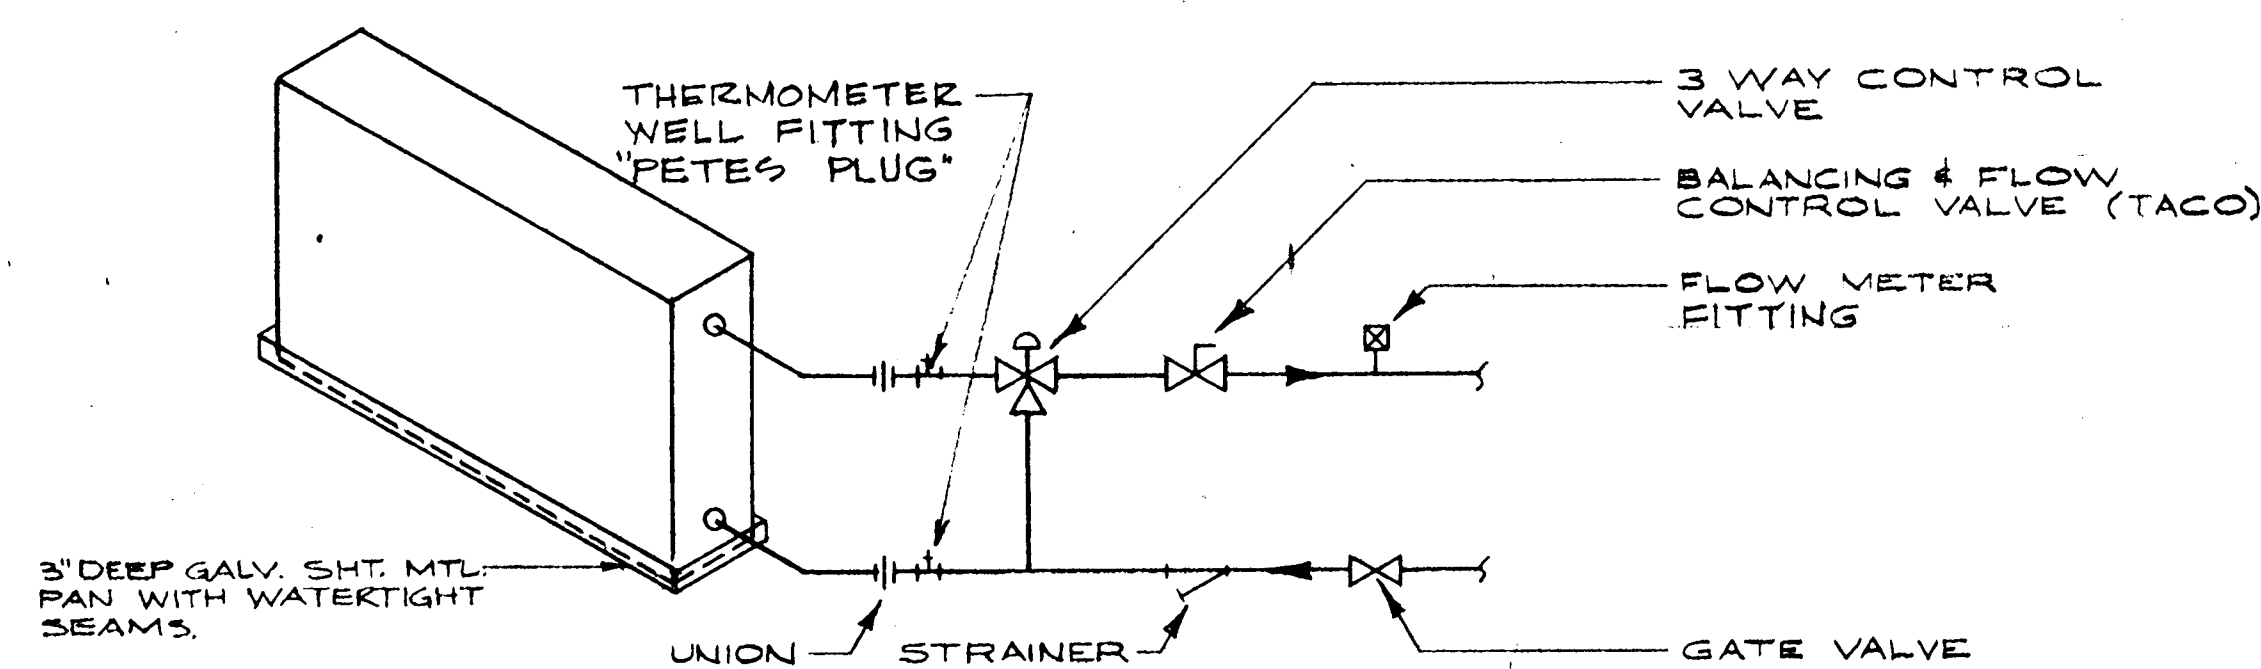


M-7
2 CHILLED WATER COIL DIAGRAM

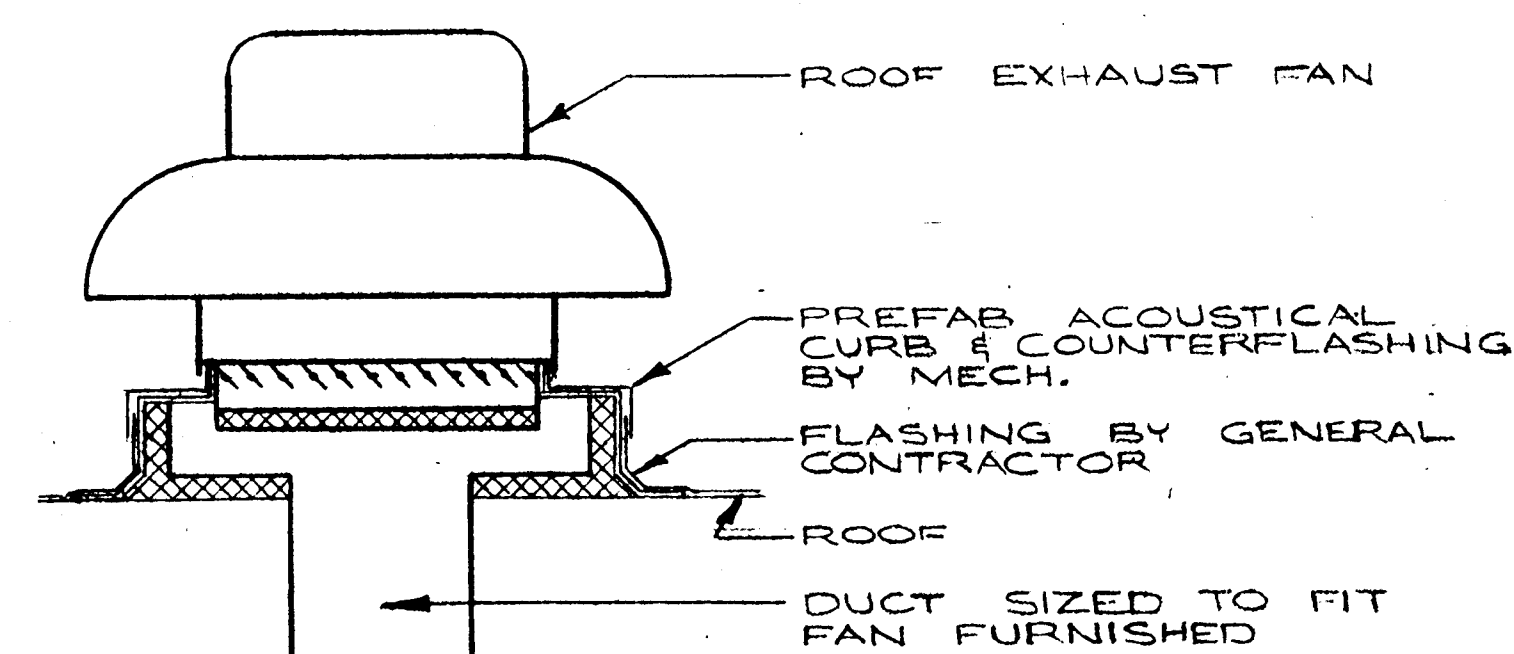


M-7
4 EXHAUST FAN DETAIL
SOUND CURB N.T.S.

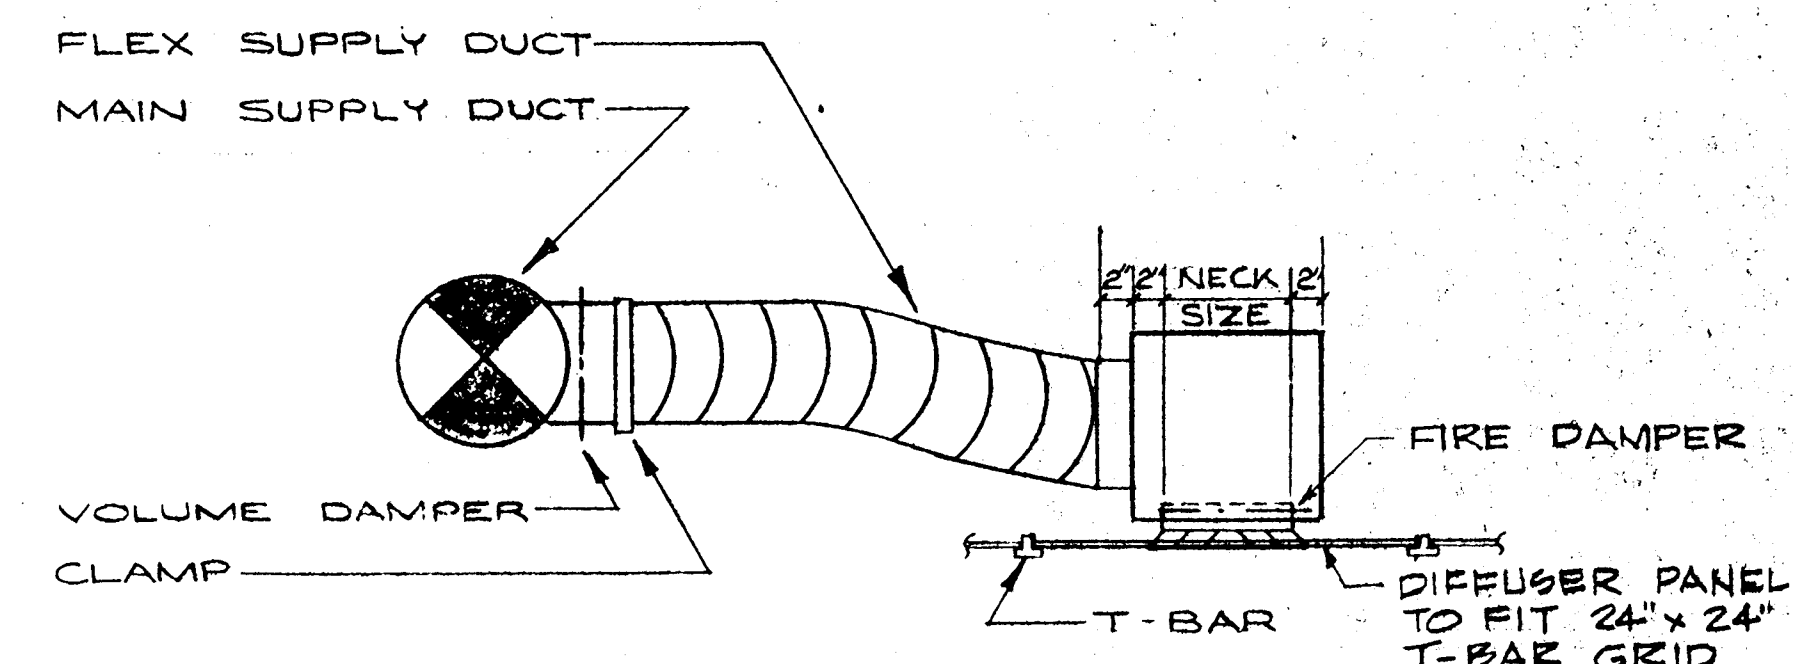

M-7
6 DIFFUSER NO. 1
N.T.S.

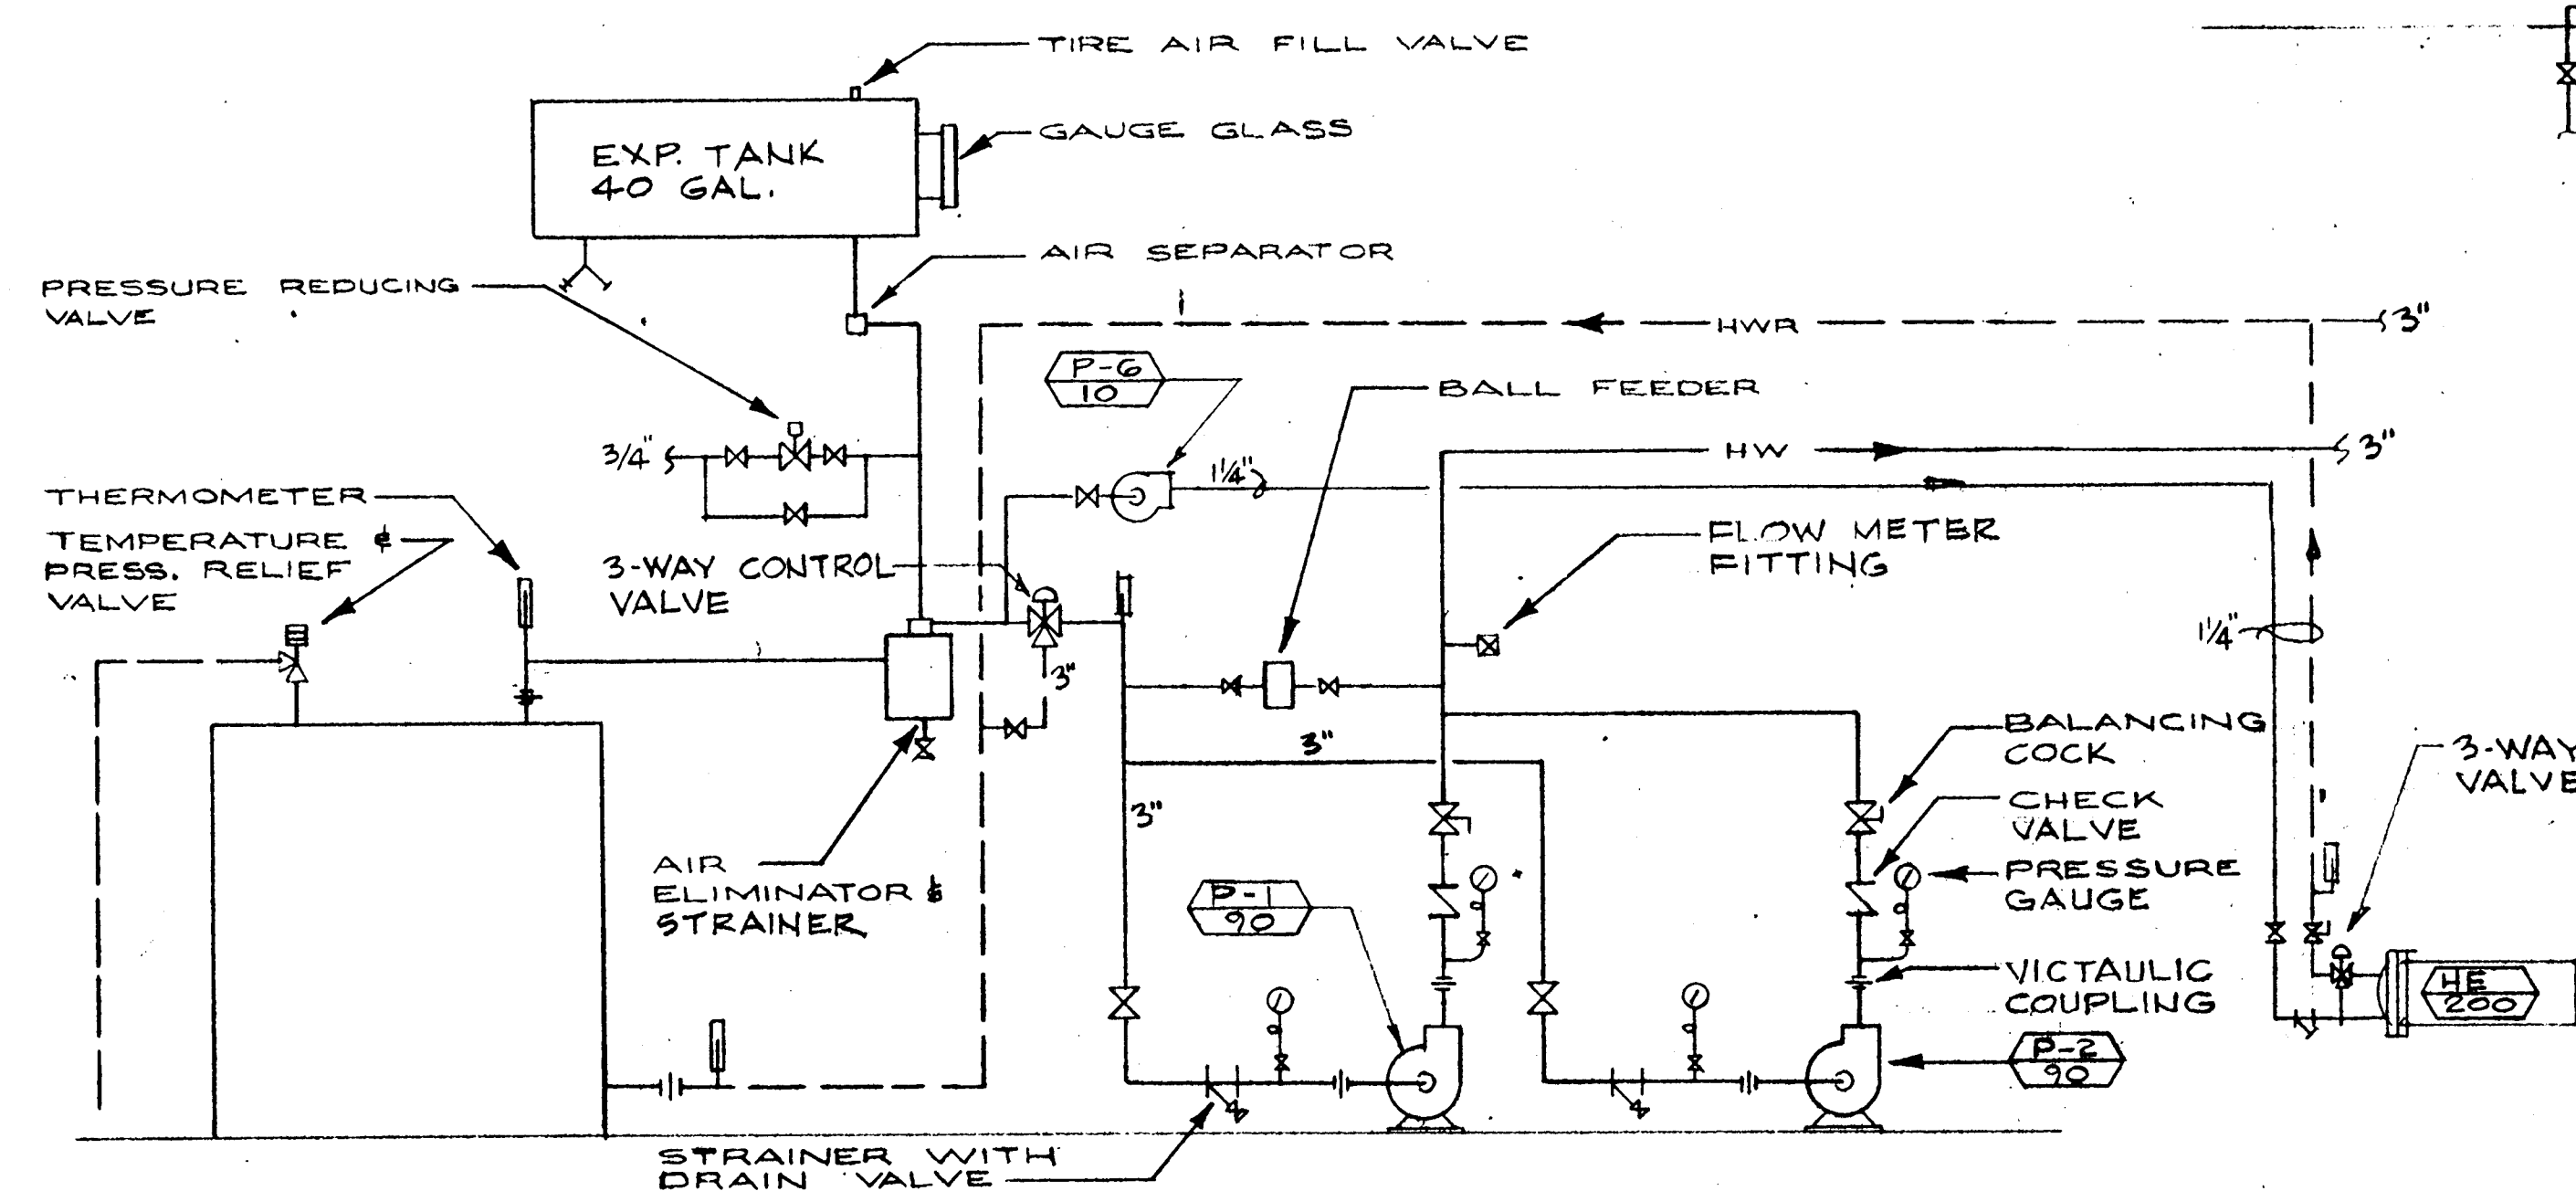

M-7
7 BOILER PIPING DIAGRAM

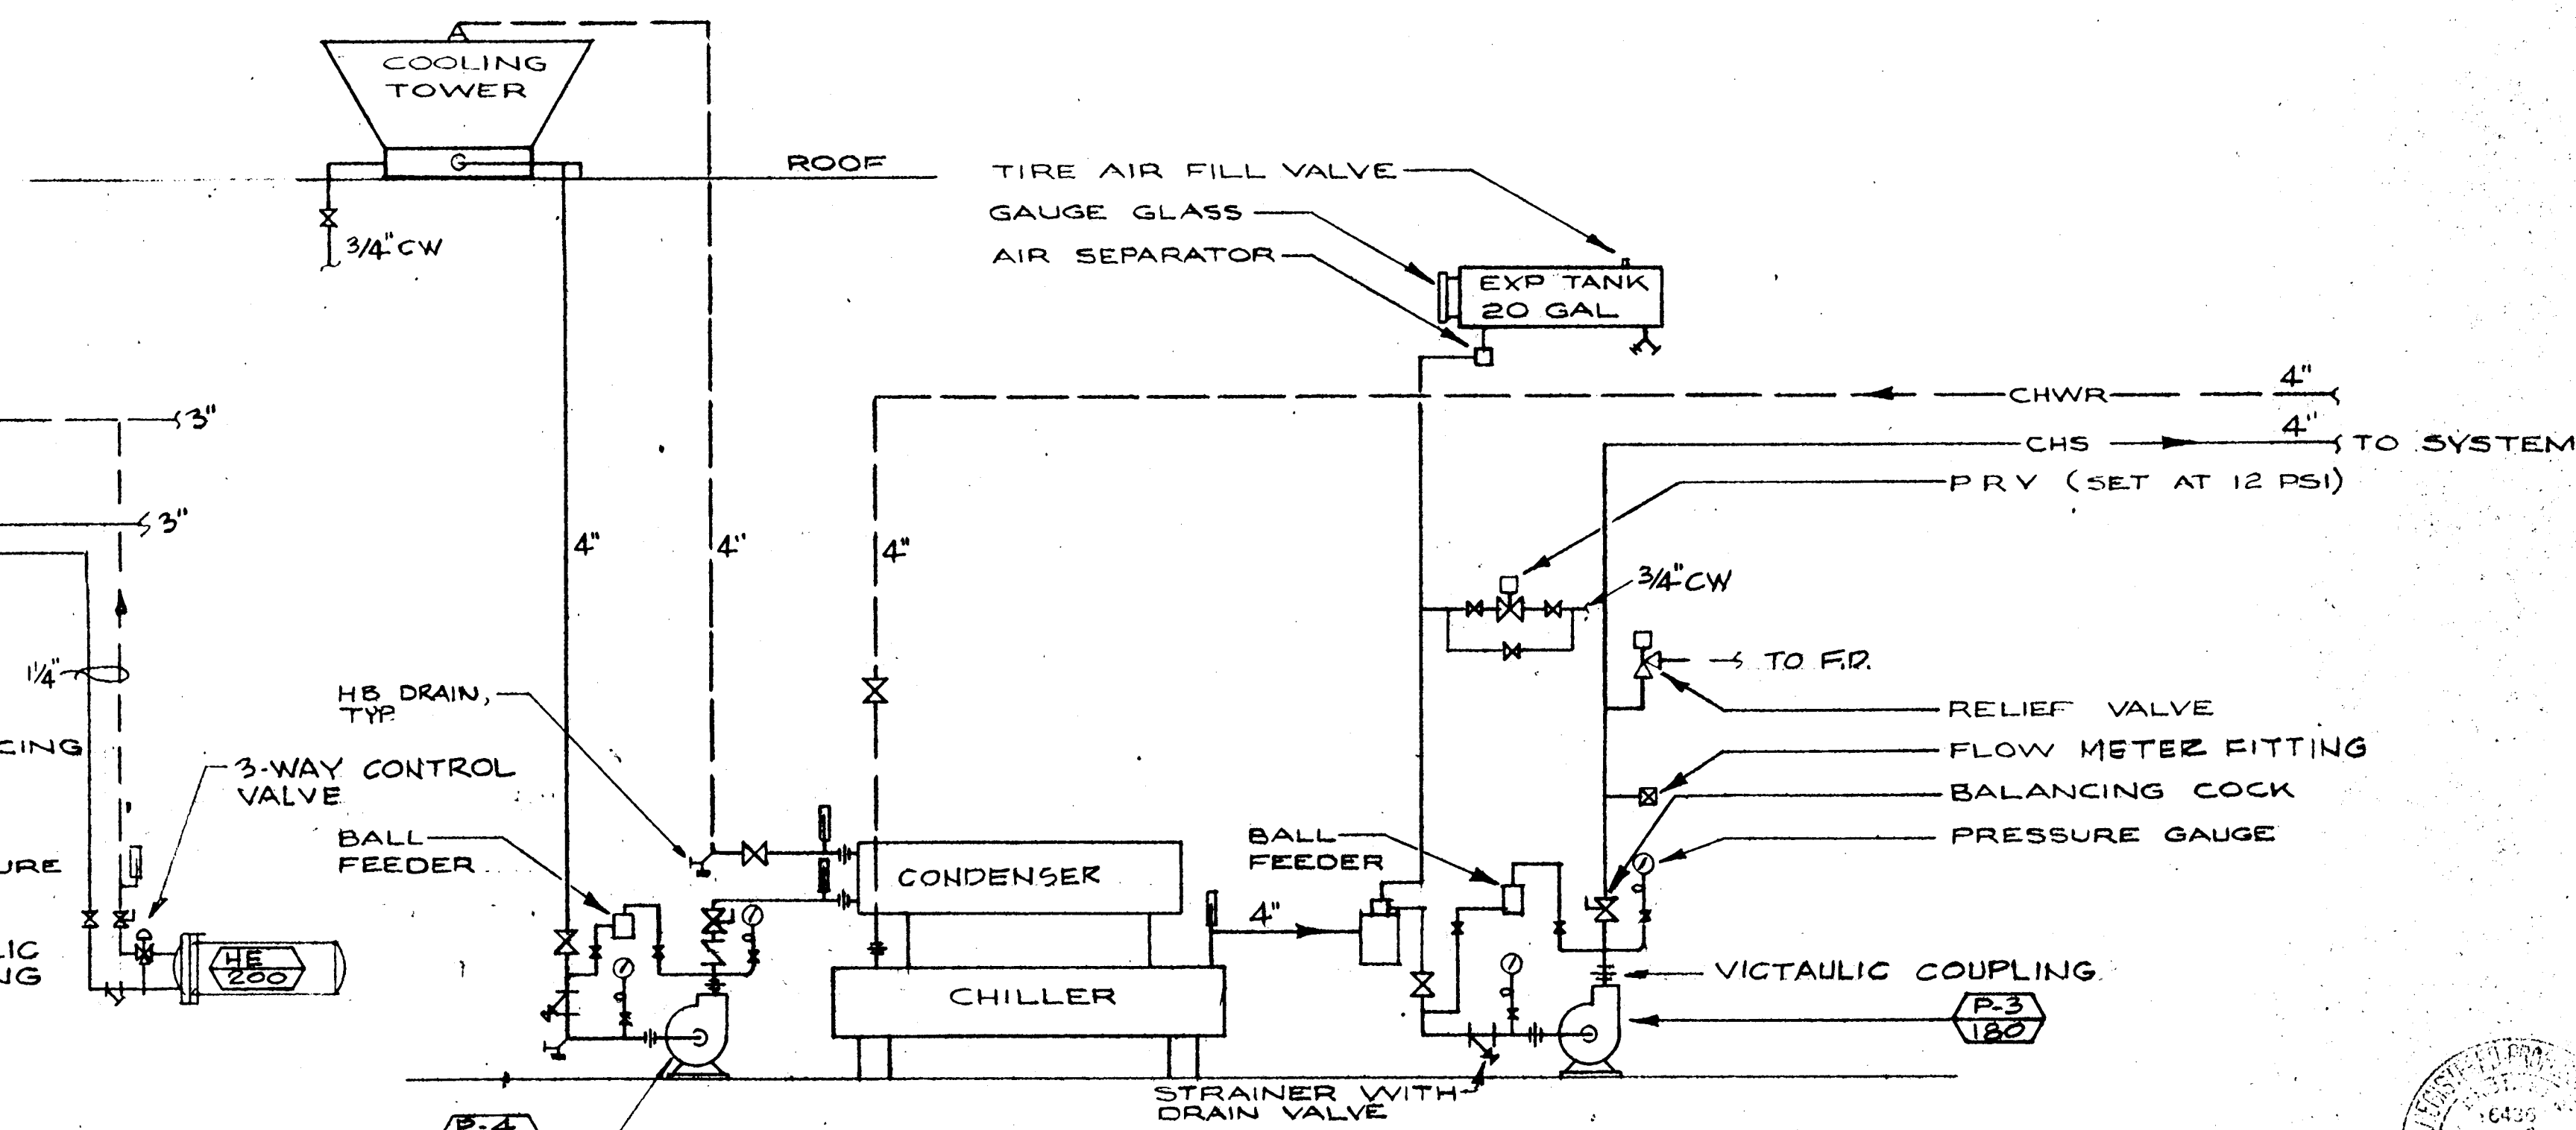


M-7
8 CHILLER PIPING DIAGRAM

DETAILS & FLOW DIAGRAMS
S.W. BROCKMAN ROAD AND SW DAVIES ROAD
SEASIDE, OREGON
ELEMENTARY SCHOOL - SCHOOL DISTRICT 48
BEAVERTON, WASHINGTON COUNTY, OREGON


WILLIAMS & EHMANN AIA
ARCHITECTS-PLANNERS
377 S.E. MILWAUKEE AVENUE
PORTLAND, ORE. 97205

REVISIONS
DRAWN BY
DATE 12-20-74
CHECKED BY
DATE 12-20-74
FIG. 7


SHEET
M 7
OF 11

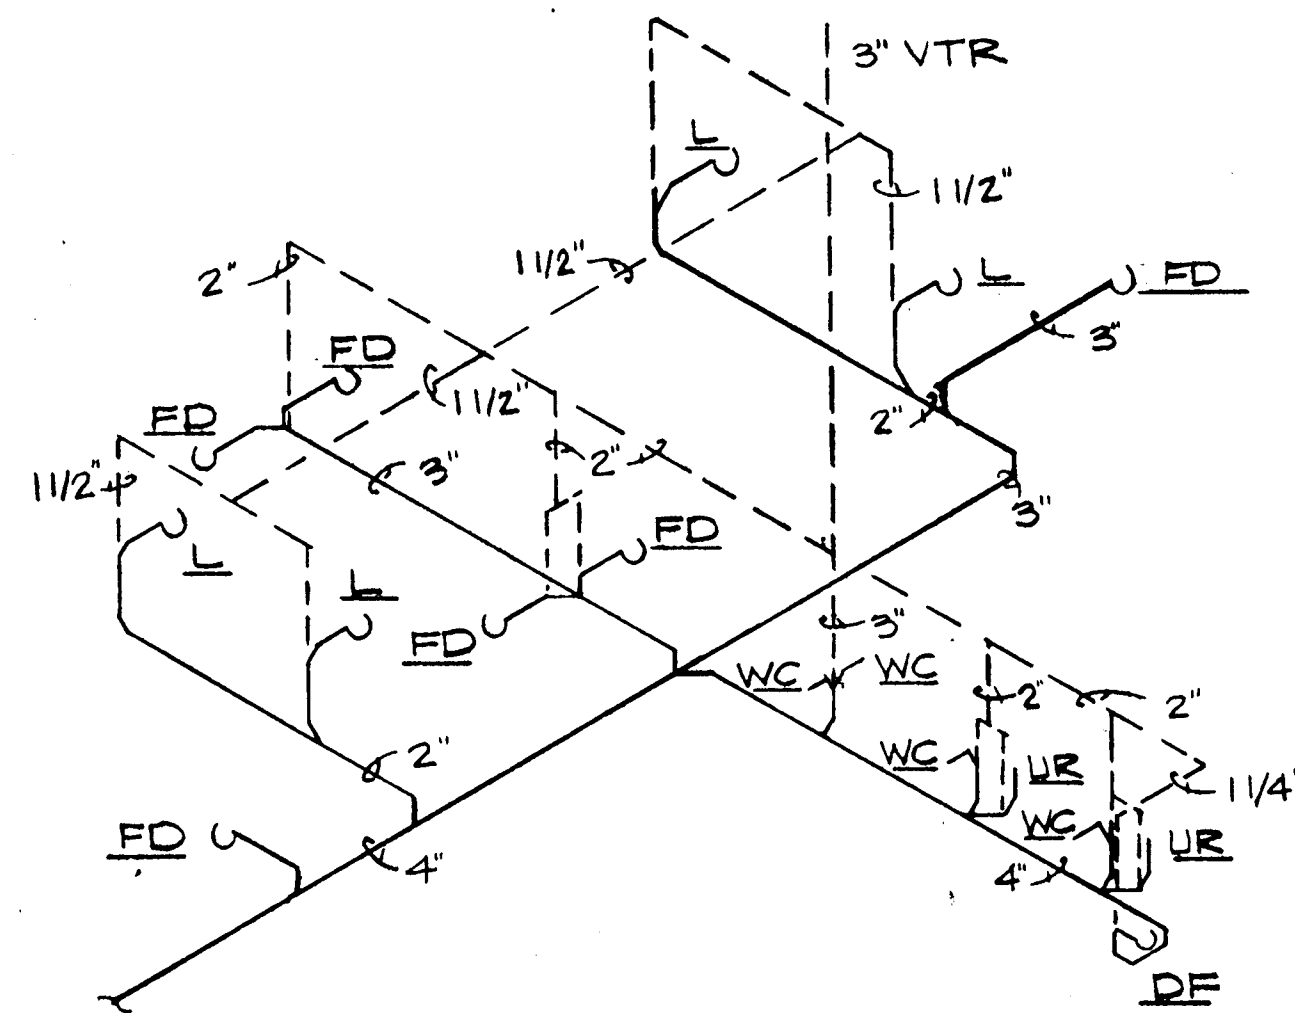


M-8
1 WASTE & VENT RISER

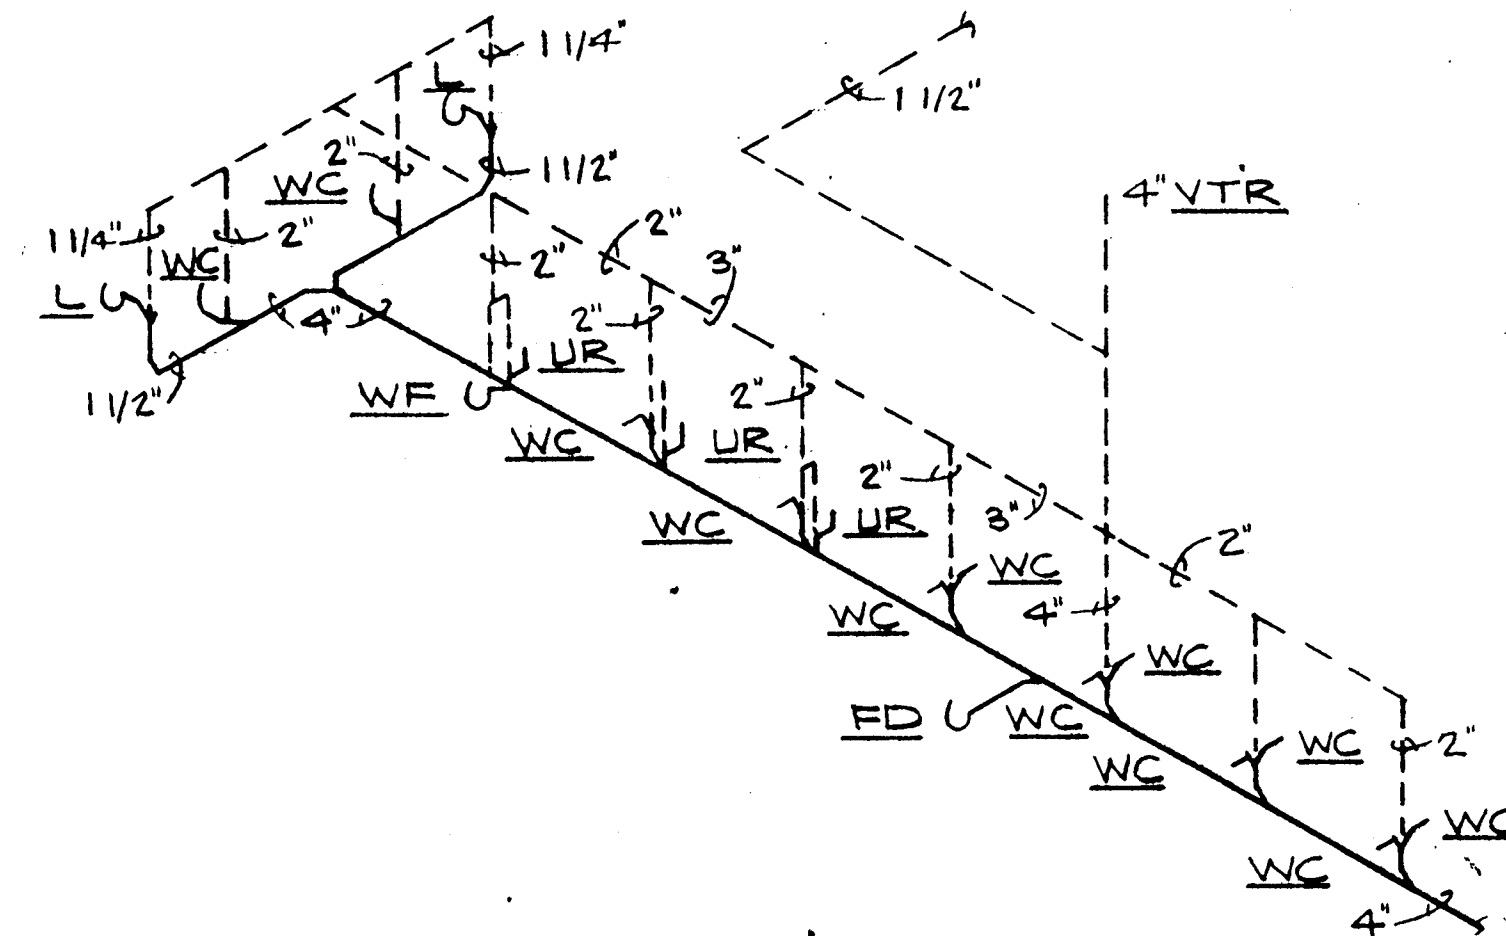


M-8
2 WASTE & VENT RISER

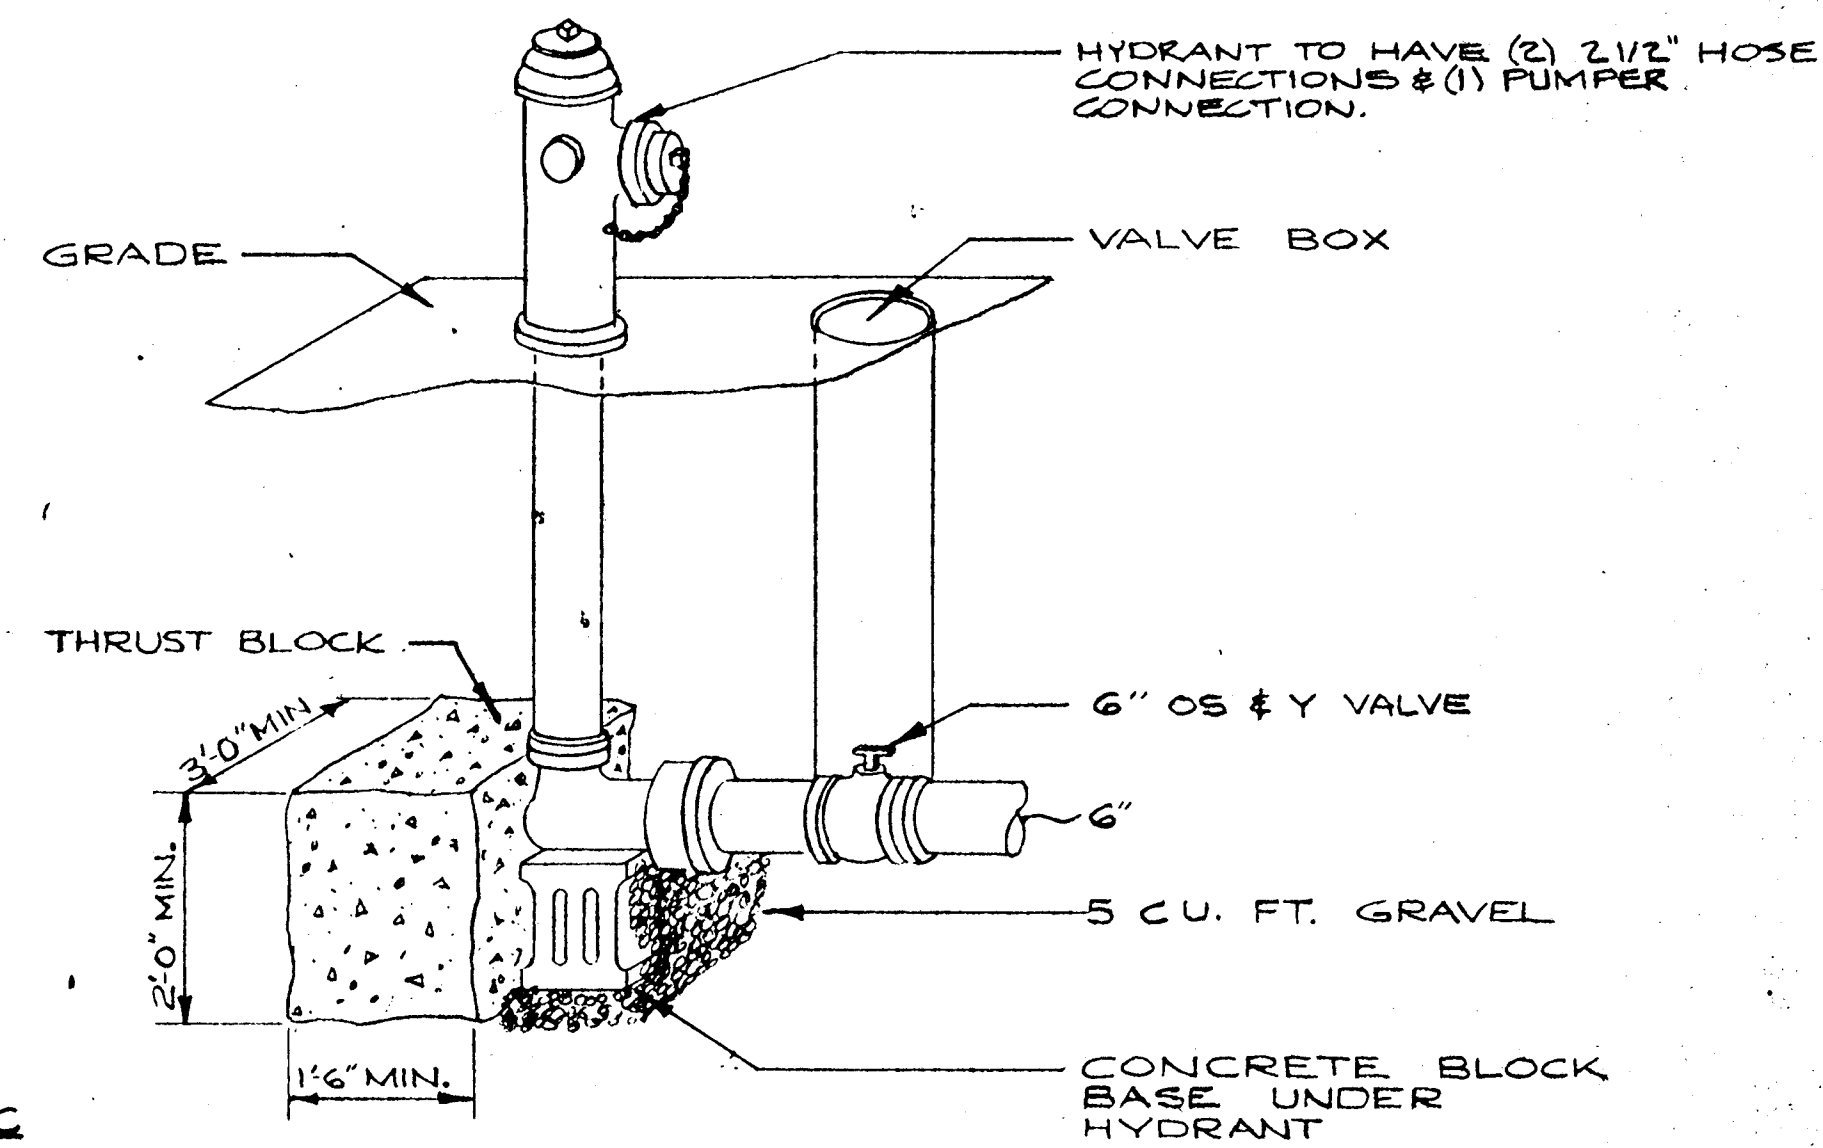


M-8
6 FIRE HYDRANT DETAIL

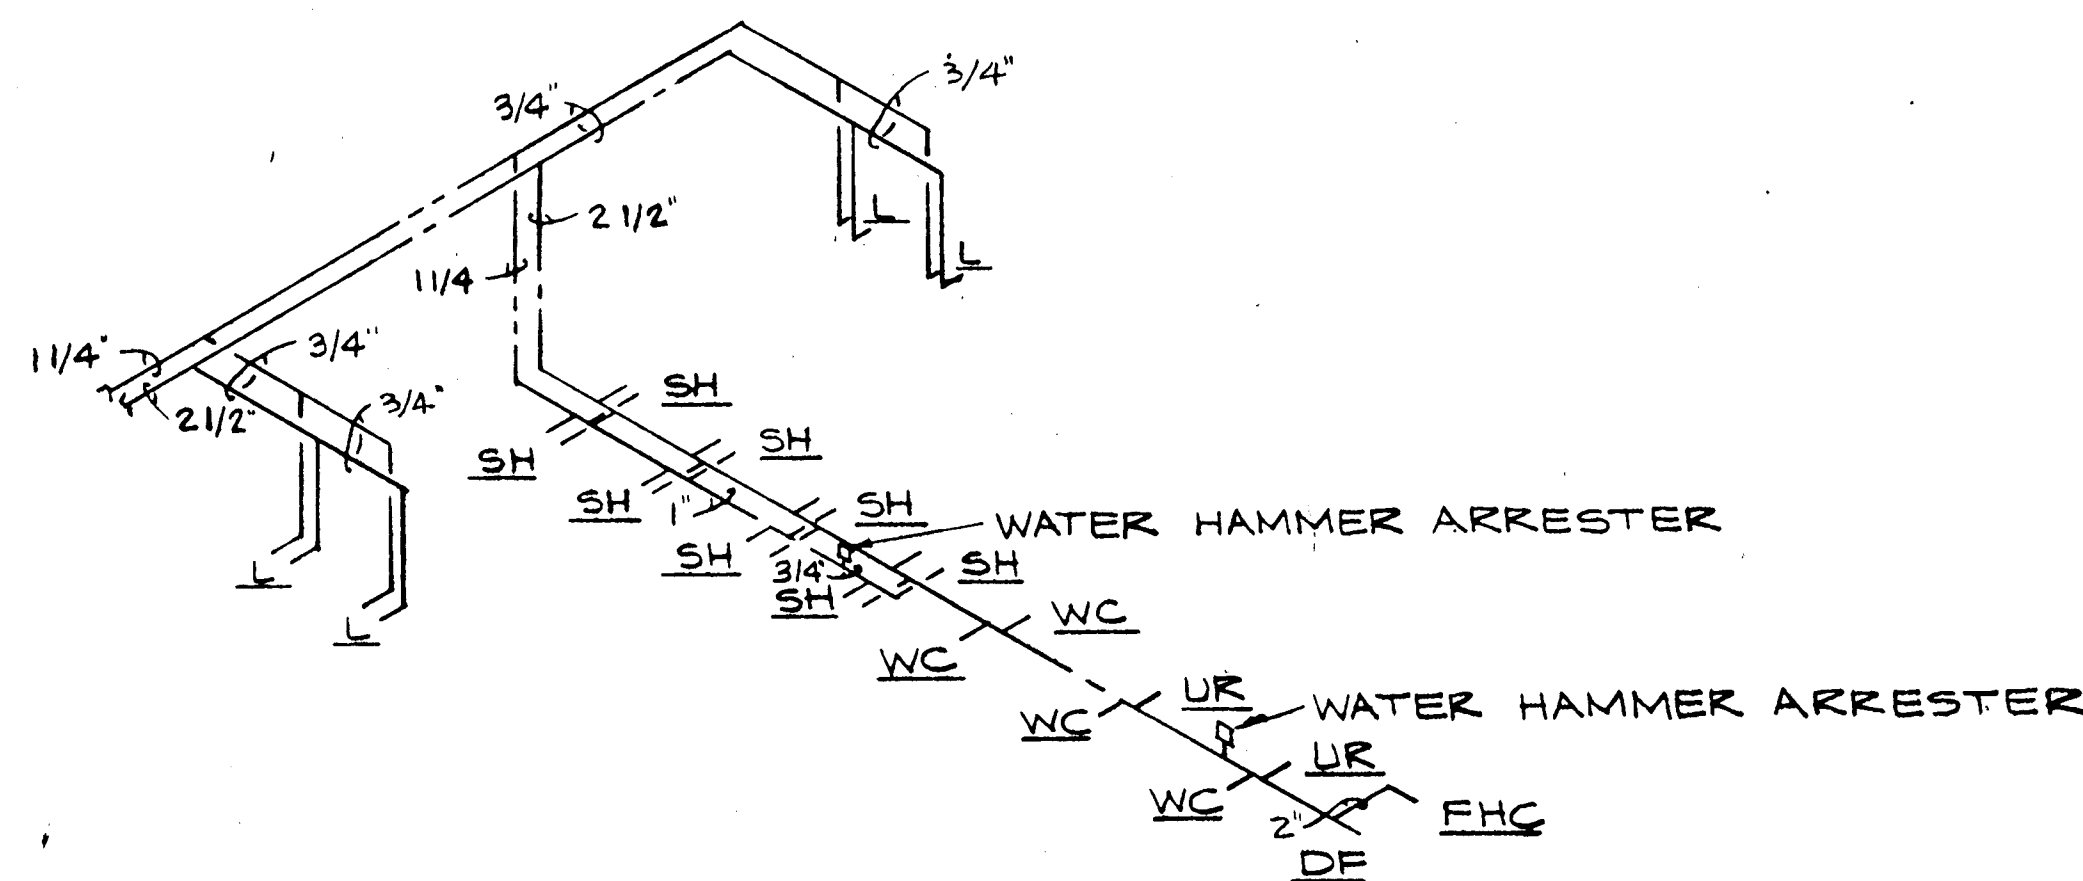


M-8
A HOT & COLD WATER RISER

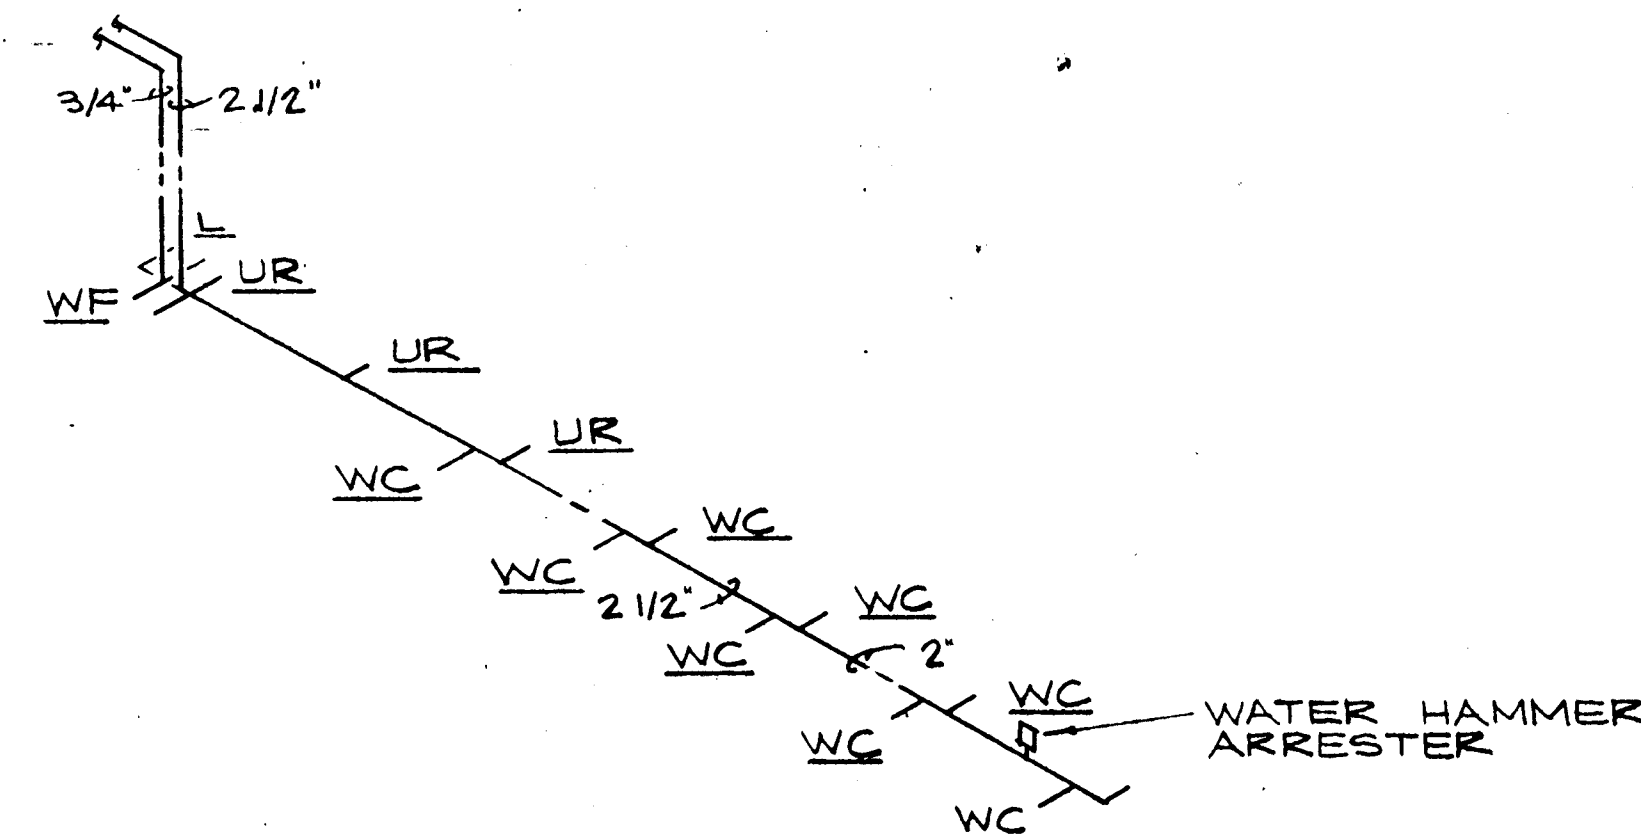


M-8
B HOT & COLD WATER RISER

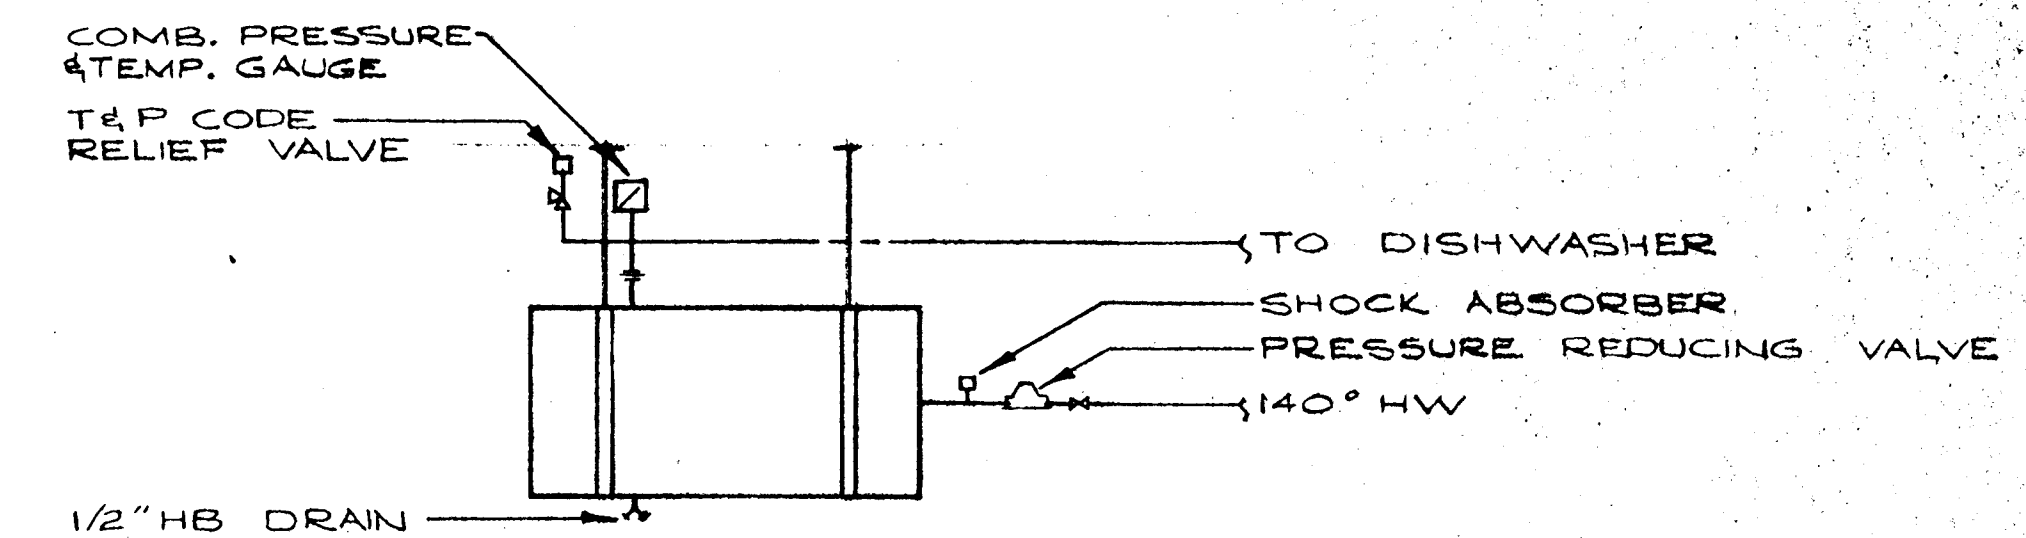


M-8
7 DISHWASHER BOOSTER HEATER DETAIL

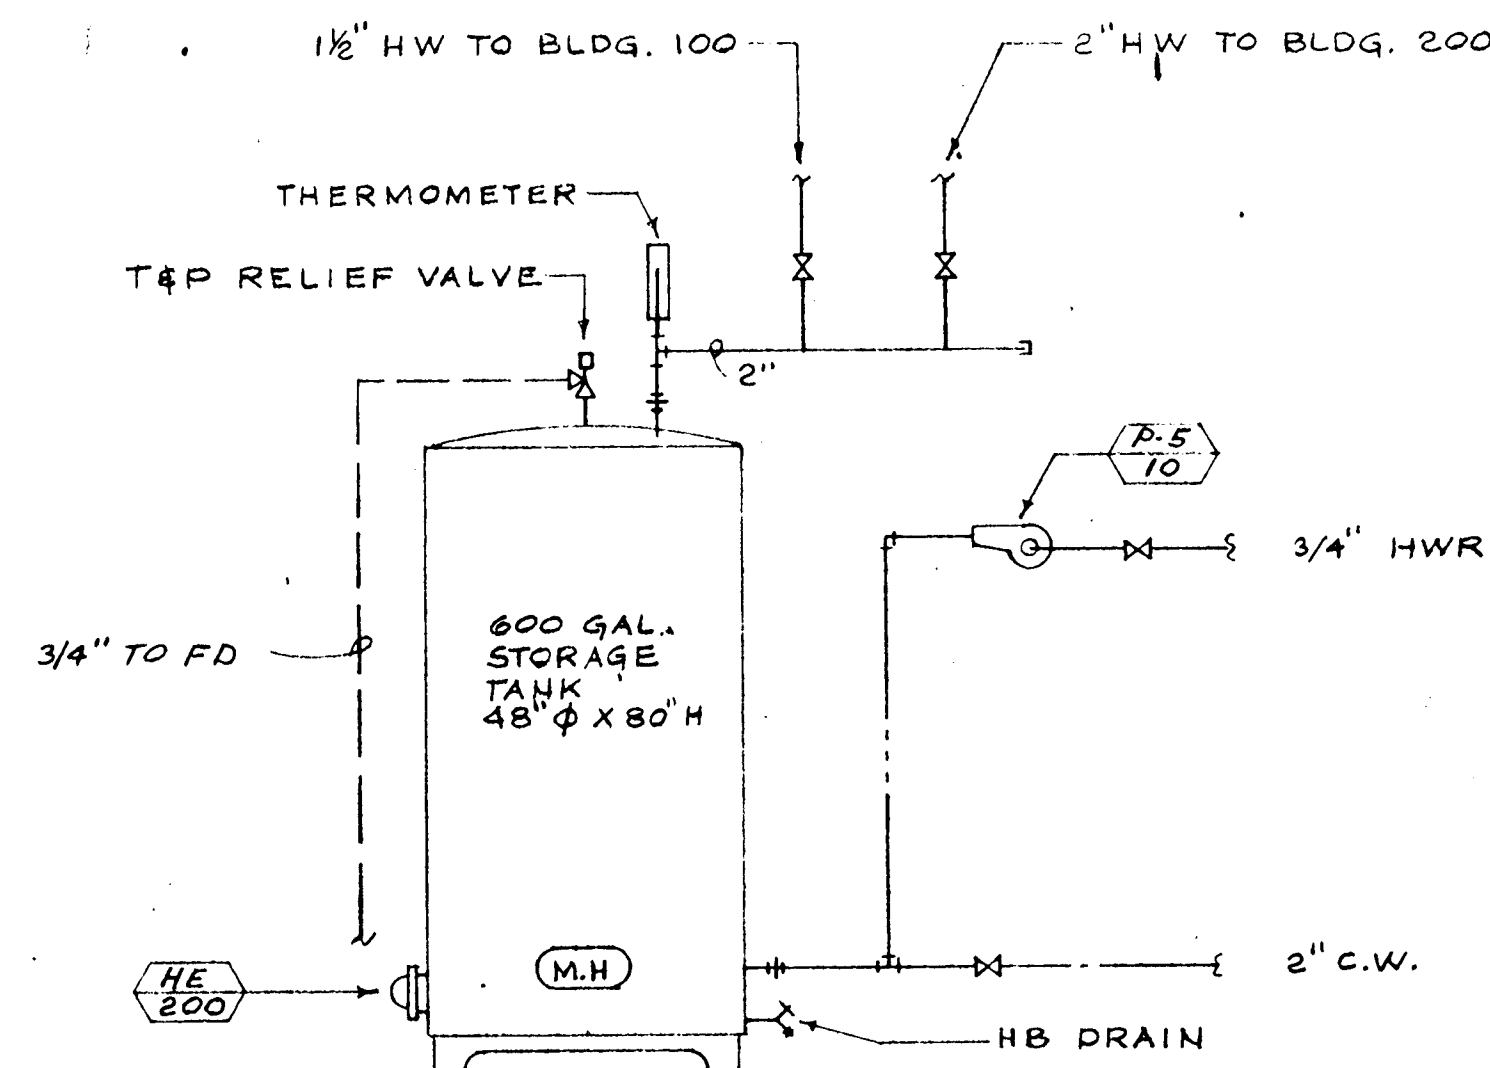

M-8
3 WATER HEATER PIPING DIAGRAM

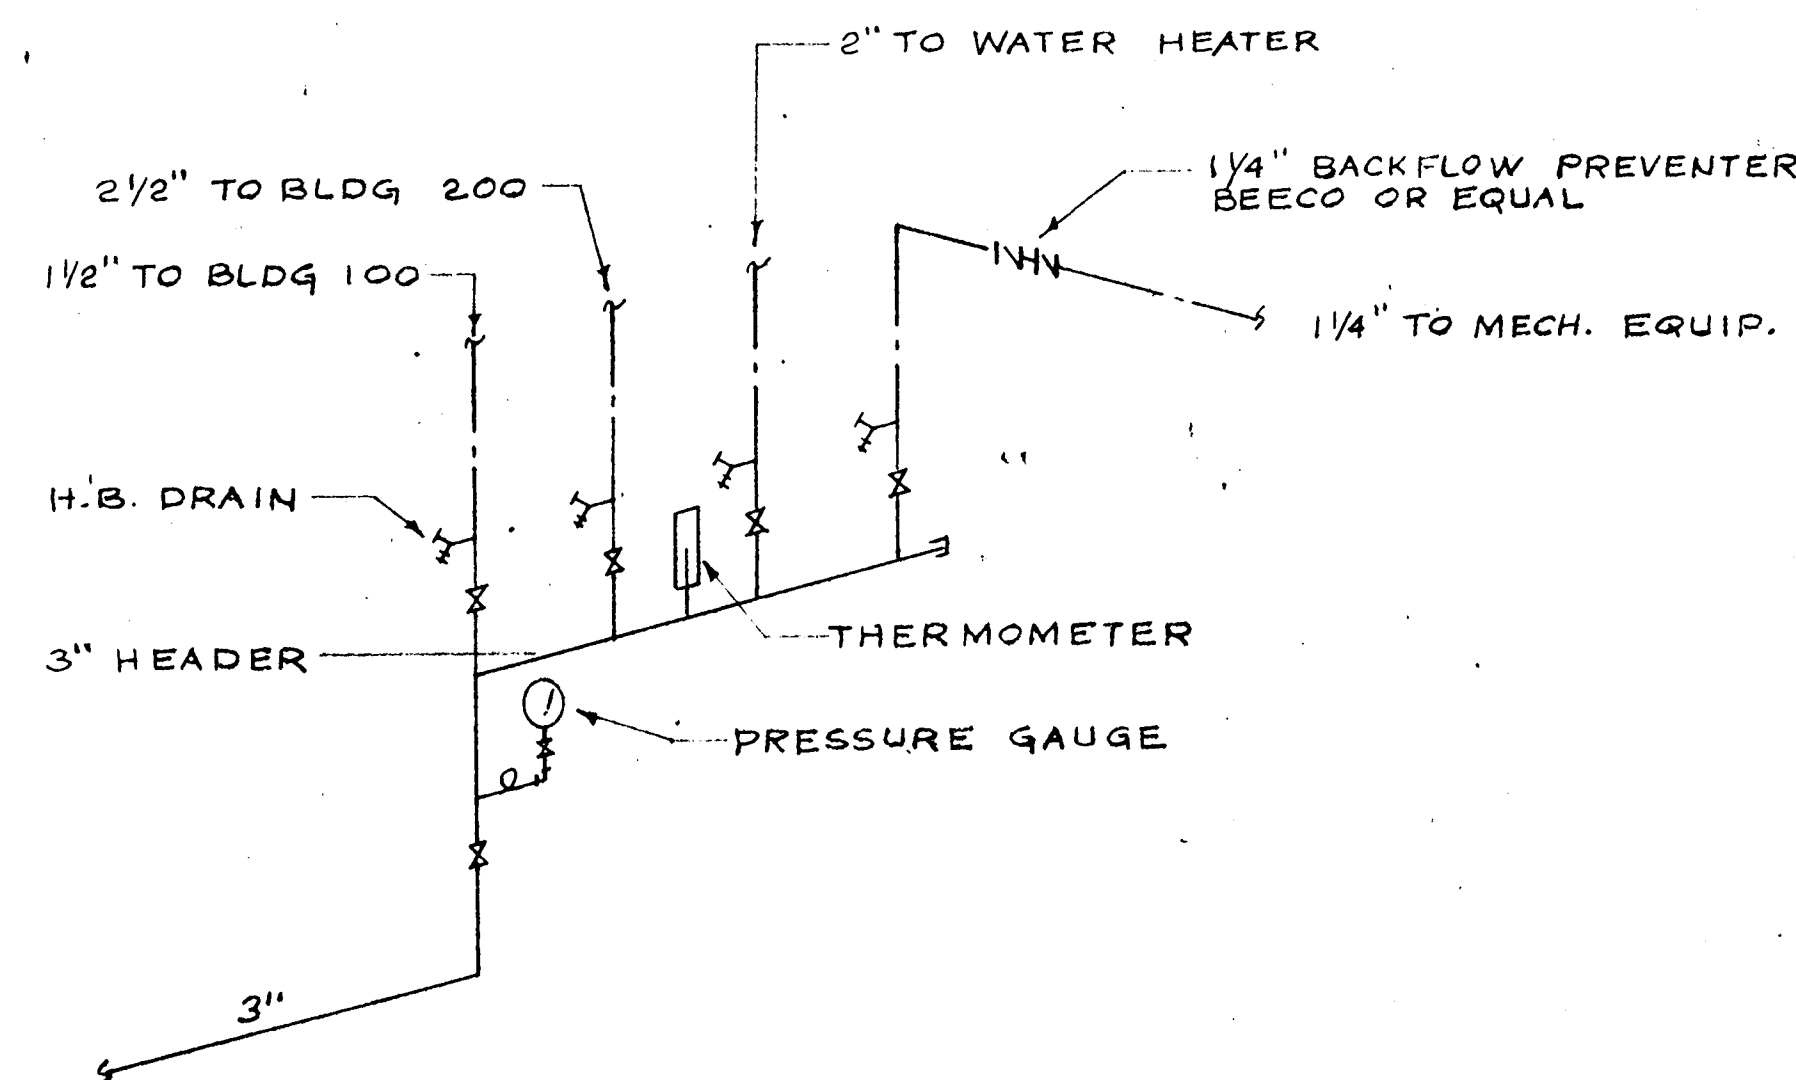

M-8
4 CW MANIFOLD

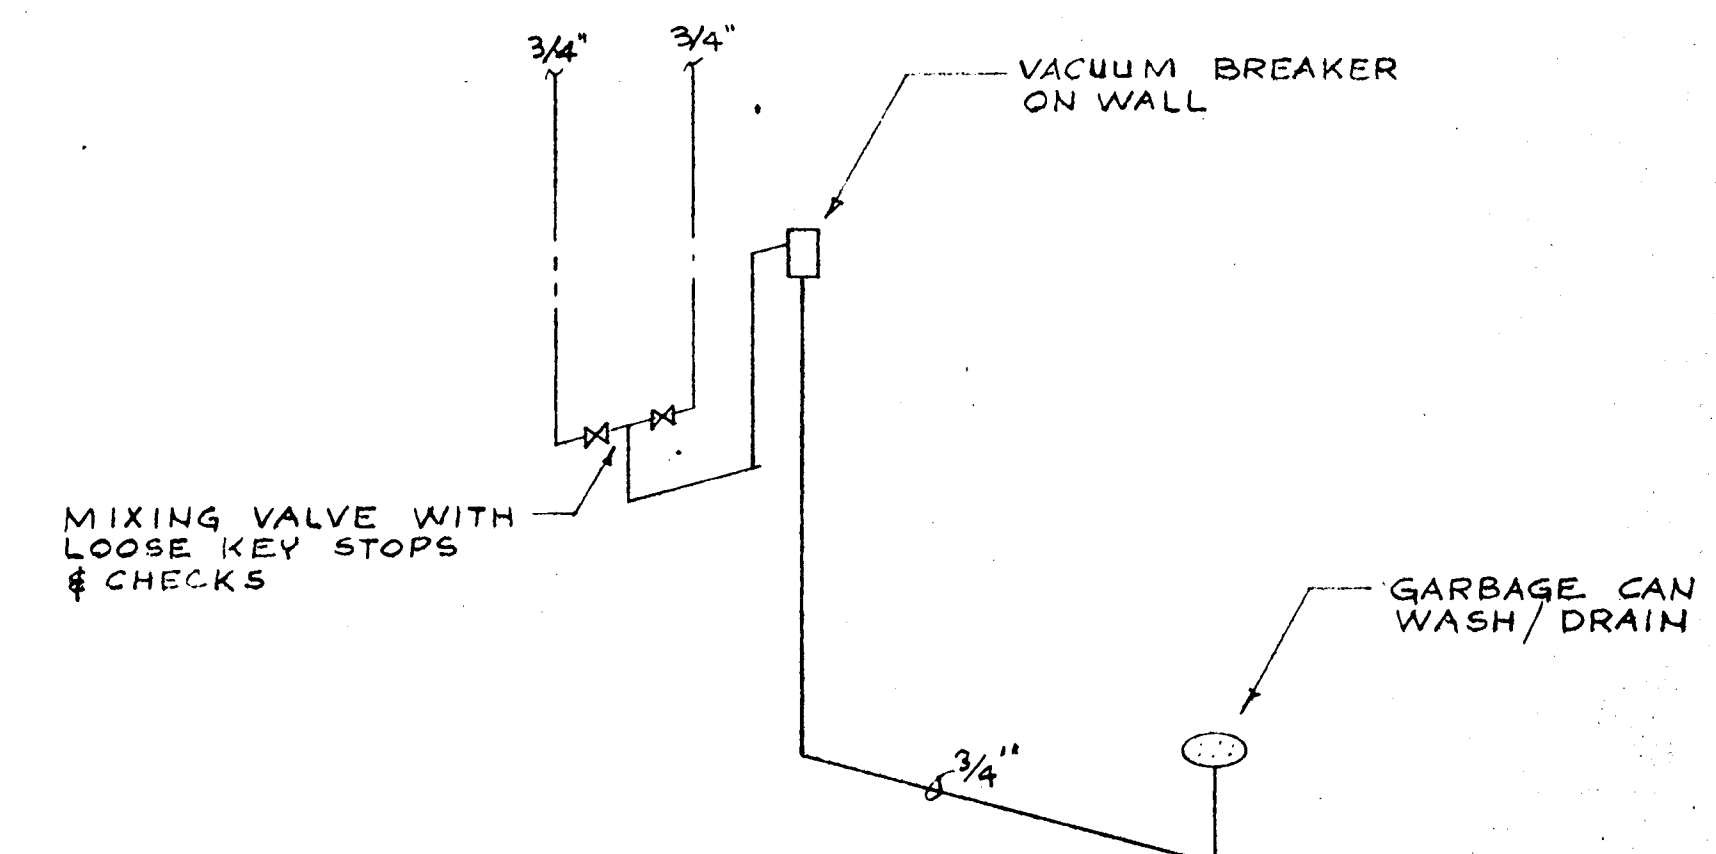

M-8
5 GARBAGE CAN WASH PIPING DIAGRAM


PLUMBING DETAILS
ON BROCKMAN ROAD AND SUNDRIES ROAD
BEAVERTON OREGON
ELEMENTARY SCHOOL - SCHOOL DISTRICT 48
BEAVERTON WASHINGTON COUNTY OREGON

WILLIAMS & EHMANN AIA
ARCHITECTS-PLANNERS
3777 S.E. MILWAUKIE AVENUE
PORTLAND, ORE. 97202 503-232-1125


REVISIONS
DATE 1-30-74
CON 73-MT
SHEET

M 8




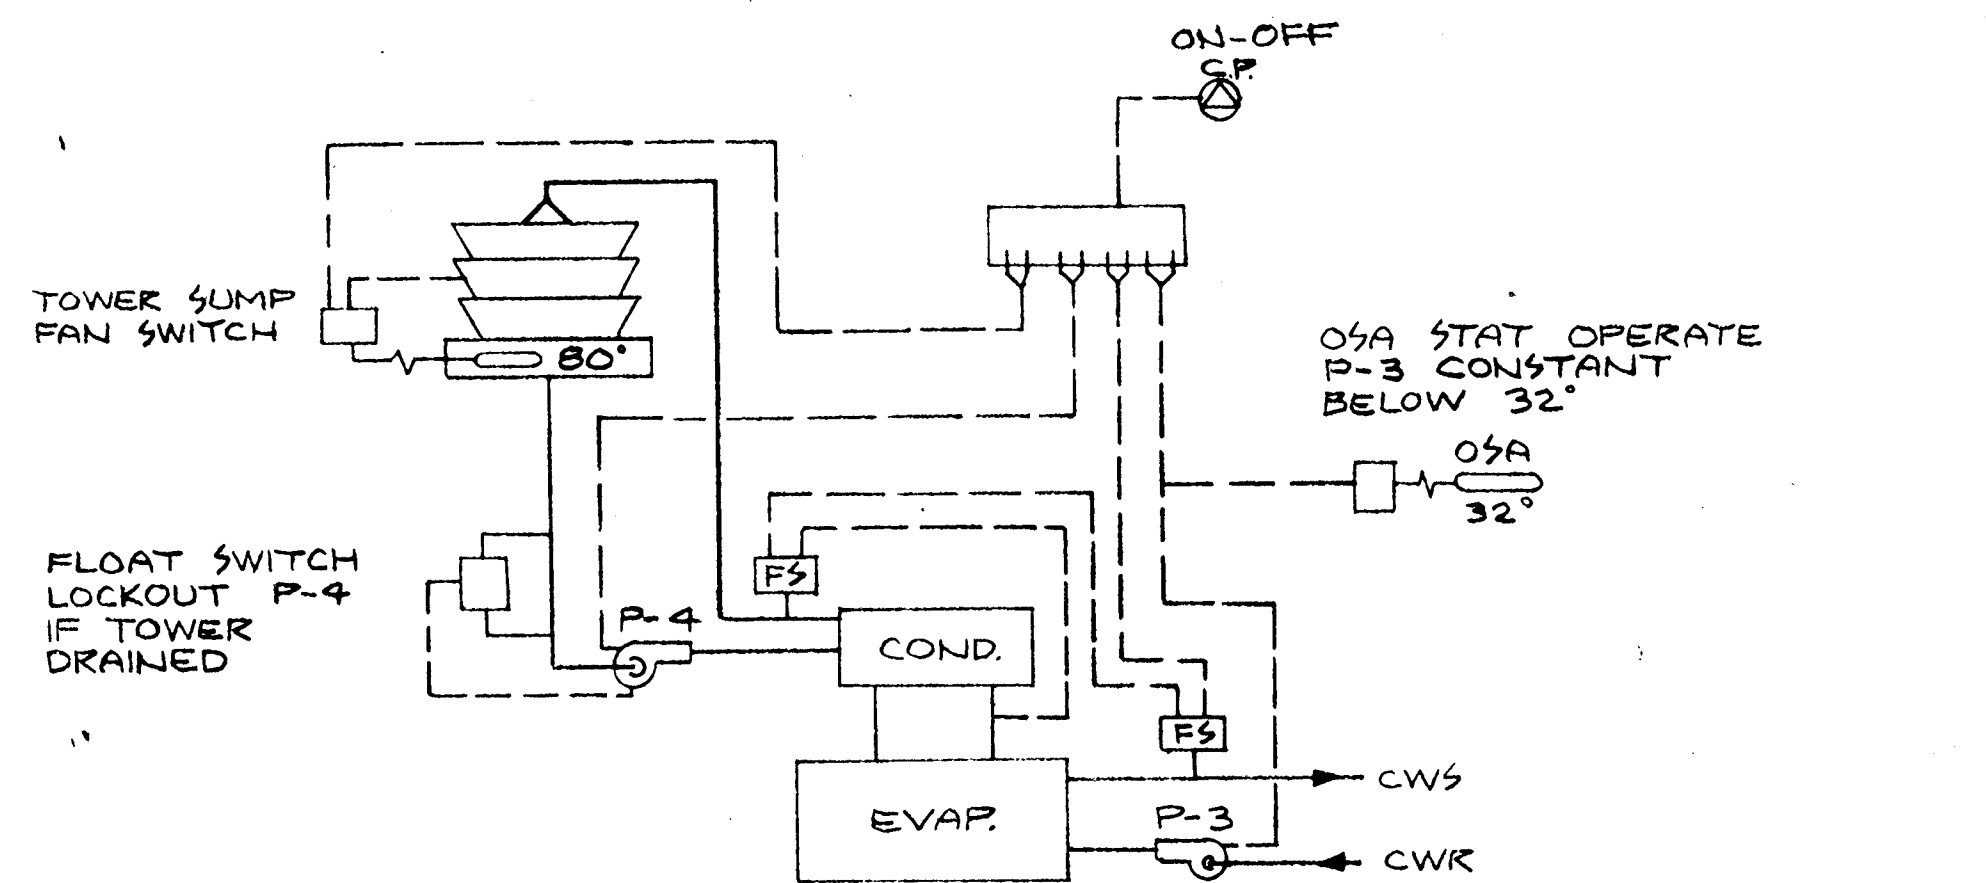


CHILLER

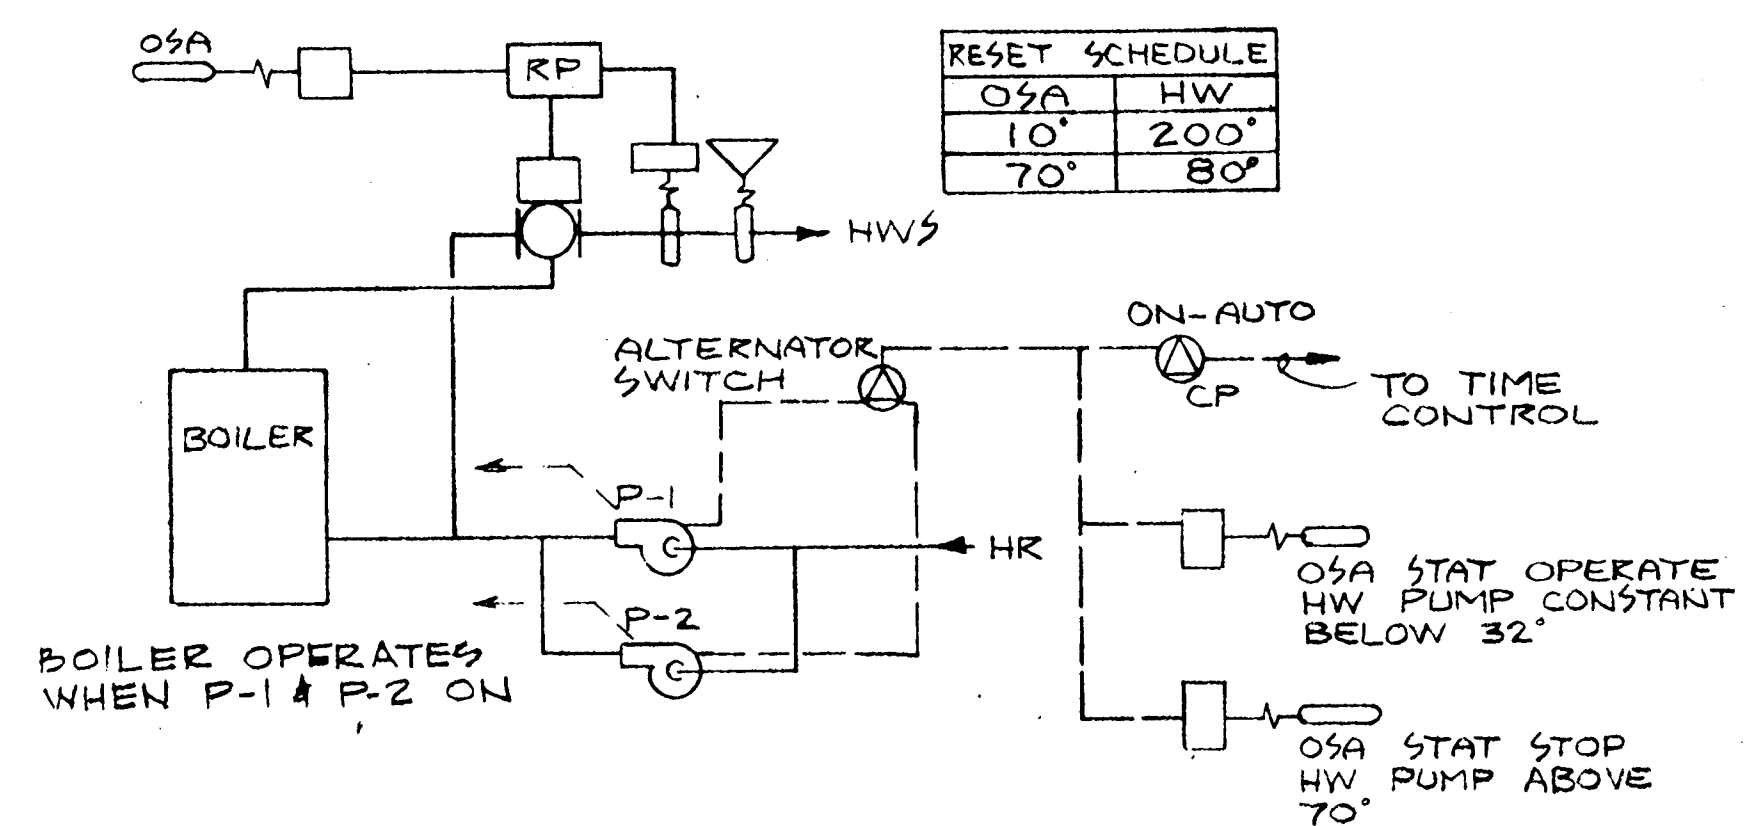

BOILER

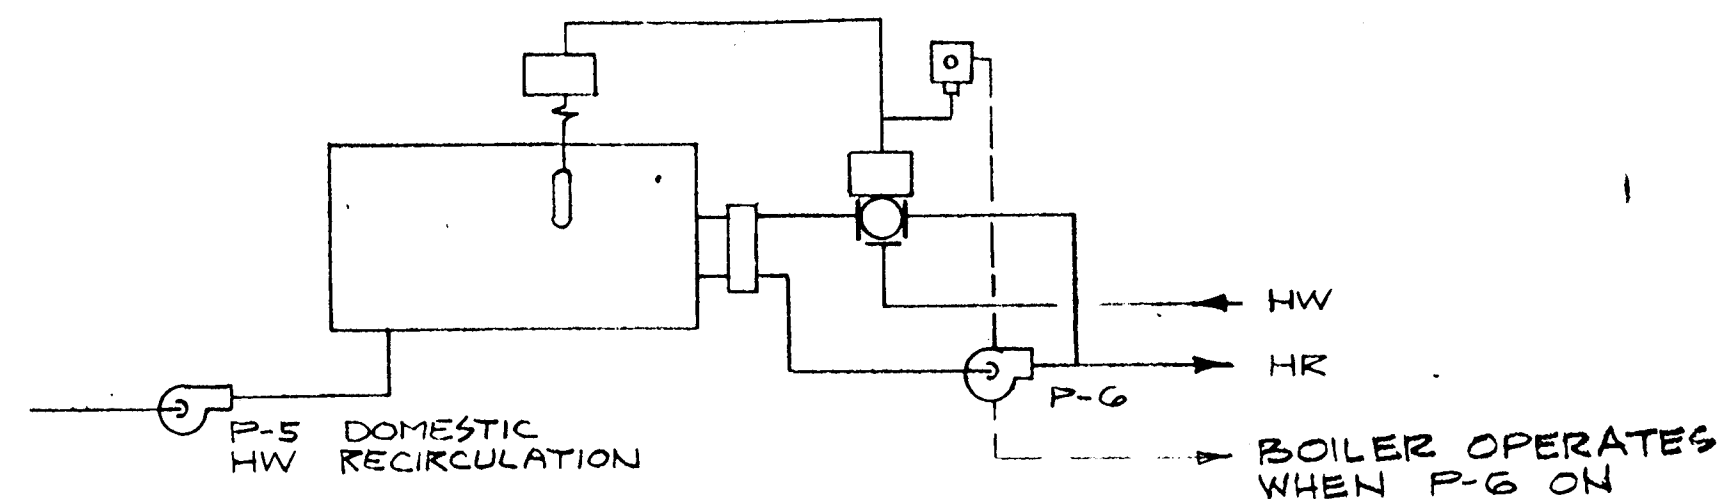

DOMESTIC HOT WATER

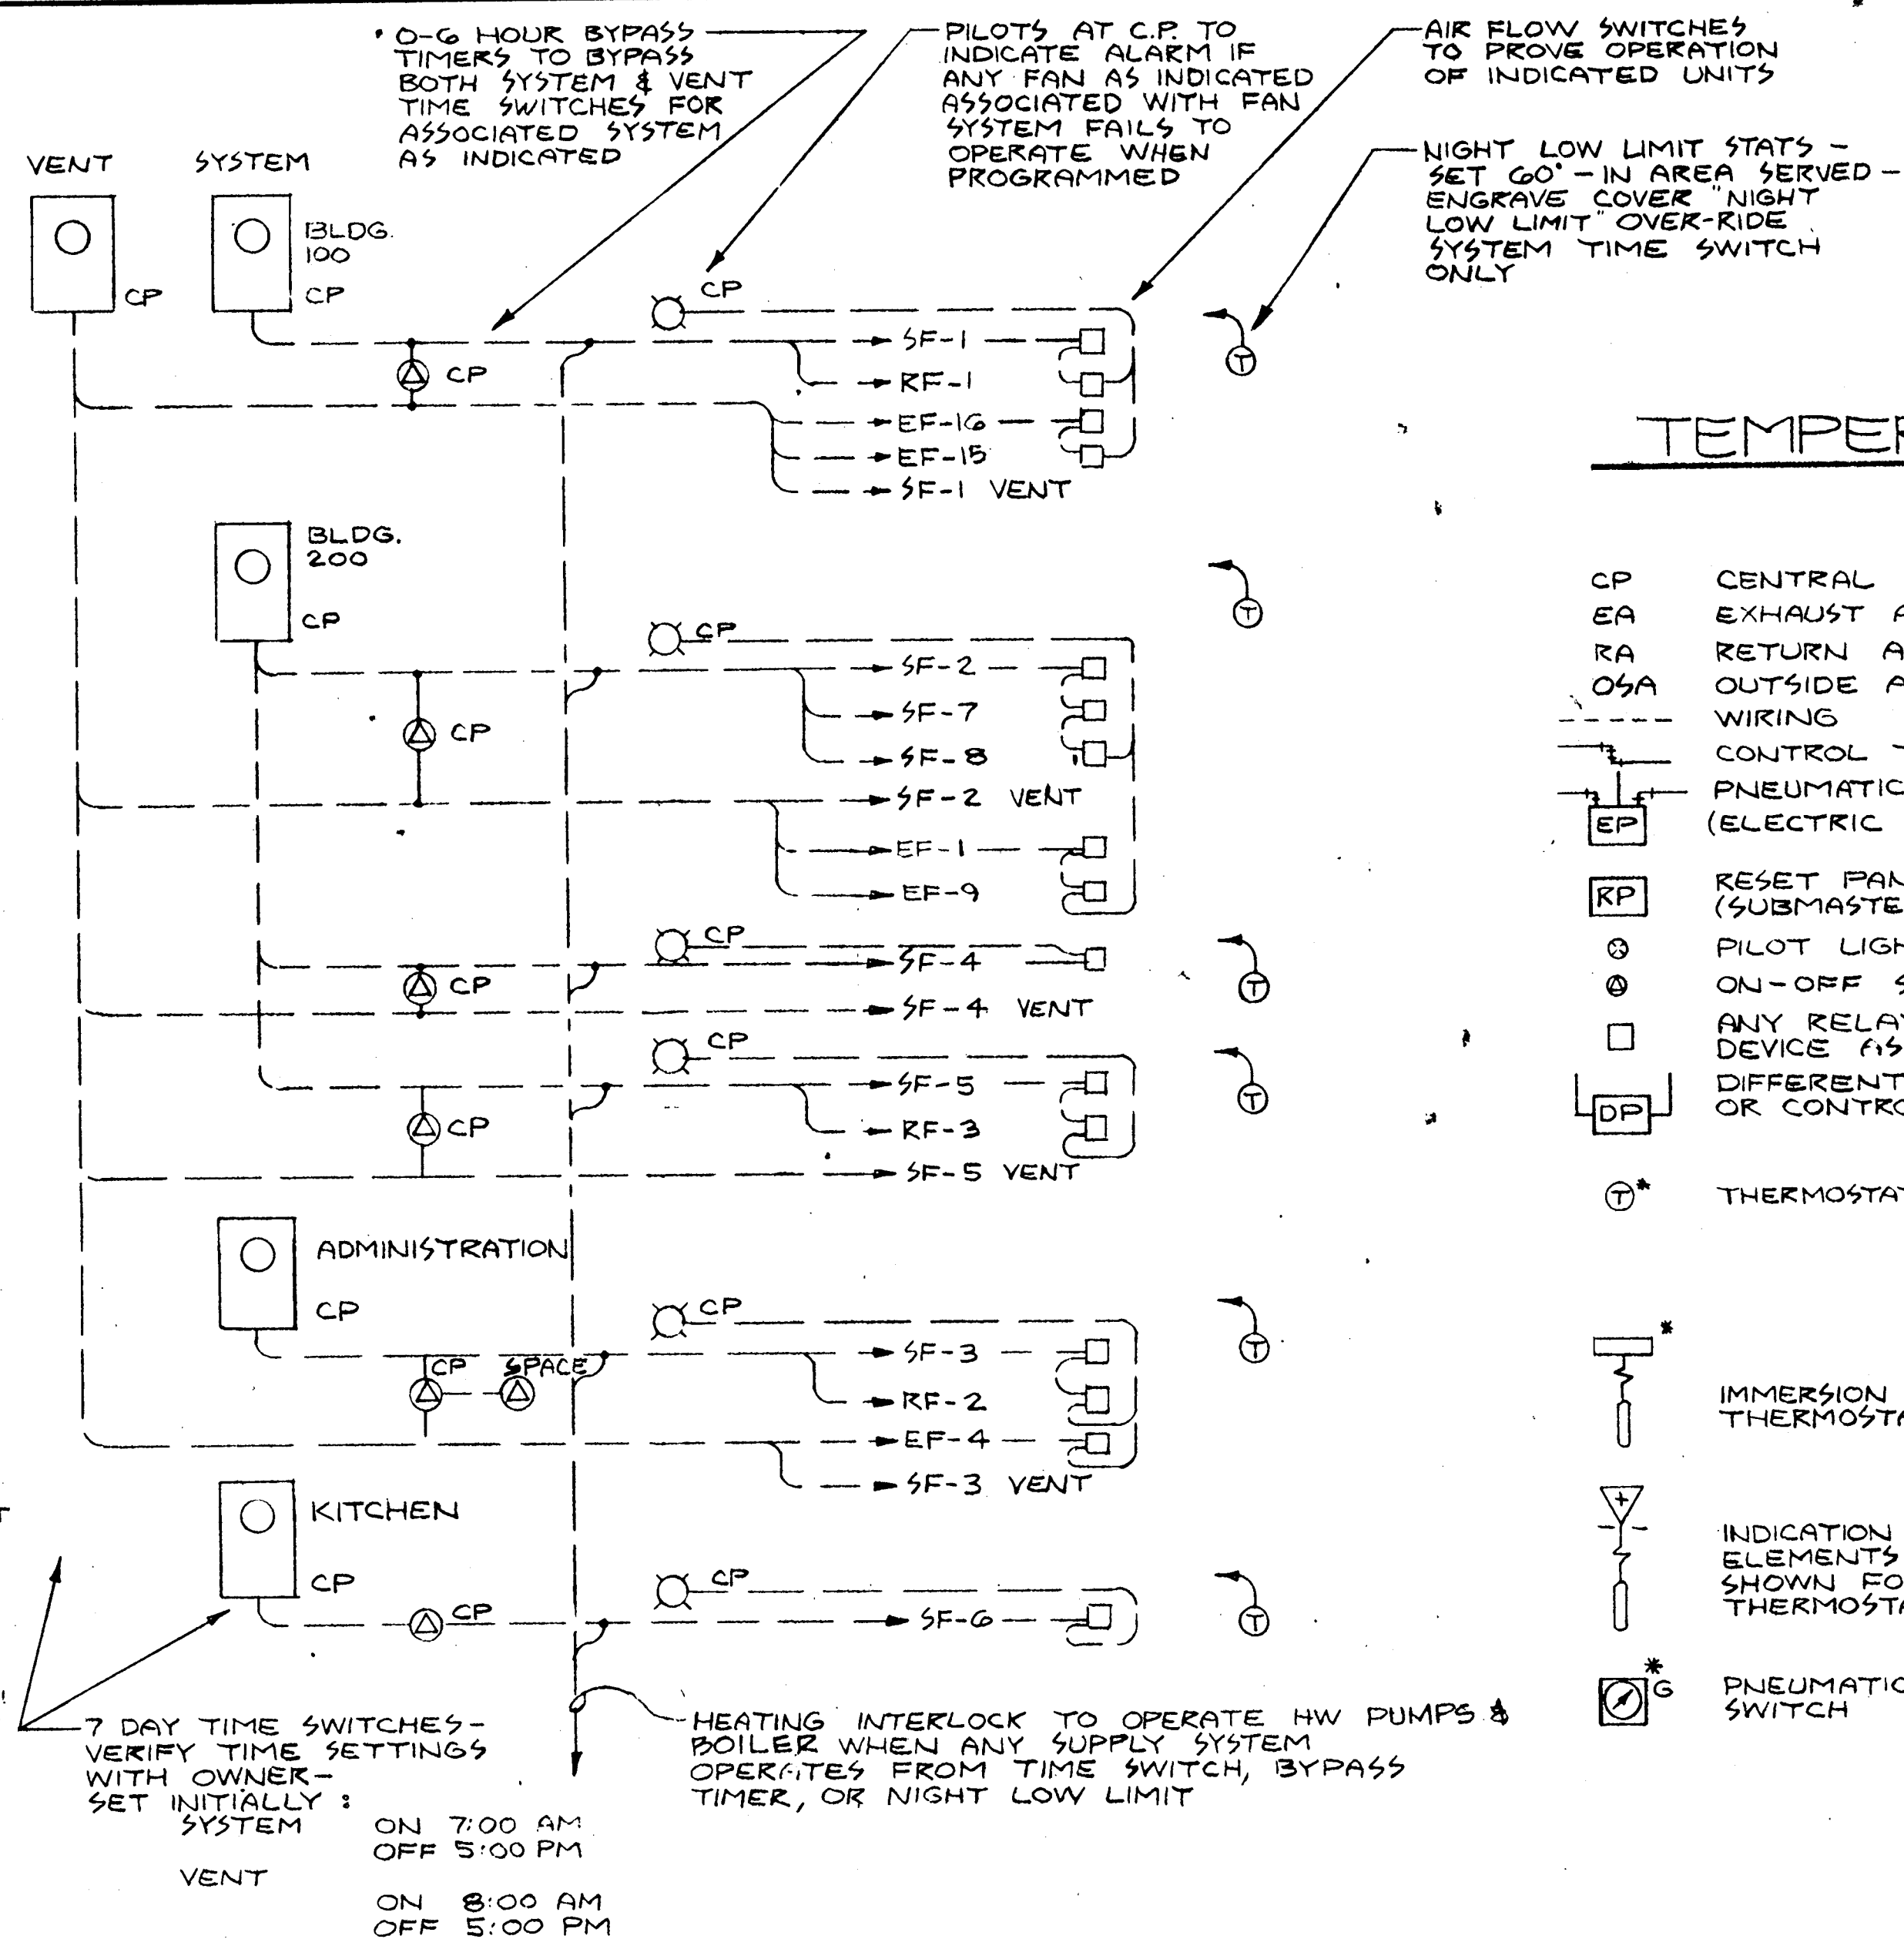

TIME CONTROL

TEMPERATURE CONTROL LEGEND


CP	CENTRAL PANEL	NC	NORMALLY CLOSED
EA	EXHAUST AIR	FU	NON-FREEZE
RA	RETURN AIR	LSFS	CONNECT TO LOAD SIDE OF FAN STARTER
O5A	OUTSIDE AIR		DAMPER MOTOR
---	WIRING		2-WAY CONTROL VALVE
---	CONTROL TUBING		3-WAY CONTROL VALVE
EP	PNEUMATIC RELAY (ELECTRIC OPERATED)		FLOW SWITCH
RP	RESET PANEL (SUBMASTER INSTRUMENT)	NO	NORMALLY OPEN
⊙	PILOT LIGHT		DUCT THERMOSTAT - 15" AVERAGING TYPE SENSING ELEMENT
⊙	ON-OFF SWITCH (ELECTRIC)		CONTROL POINT W/MANUAL REMOTE READJUSTMENT
□	ANY RELAY OR MISCELLANEOUS DEVICE AS NOTED		
DP	DIFFERENTIAL PRESSURE INDICATOR OR CONTROLLER		
⊕	THERMOSTAT		
⊕	IMMERSION THERMOSTAT		
⊕	INDICATION POINT ELEMENTS AS SHOWN FOR THERMOSTAT		
⊕	PNEUMATIC SWITCH		

CONTROL DIAGRAMS
SW. BROCKMAN ROAD AND SW. DAVIES ROAD
BEAVERTON, OREGON


ELEMENTARY SCHOOL - SCHOOL DISTRICT 48
BEAVERTON, WASHINGTON COUNTY, OREGON

WILLIAMS & EHMANN AIA
ARCHITECTS-PLANNERS
3777 S.E. MILWAUKEE AVENUE
PORTLAND, ORE 97202 503-238-1195

REVISIONS
DATE 1-20-74
BY 15-67
M 9

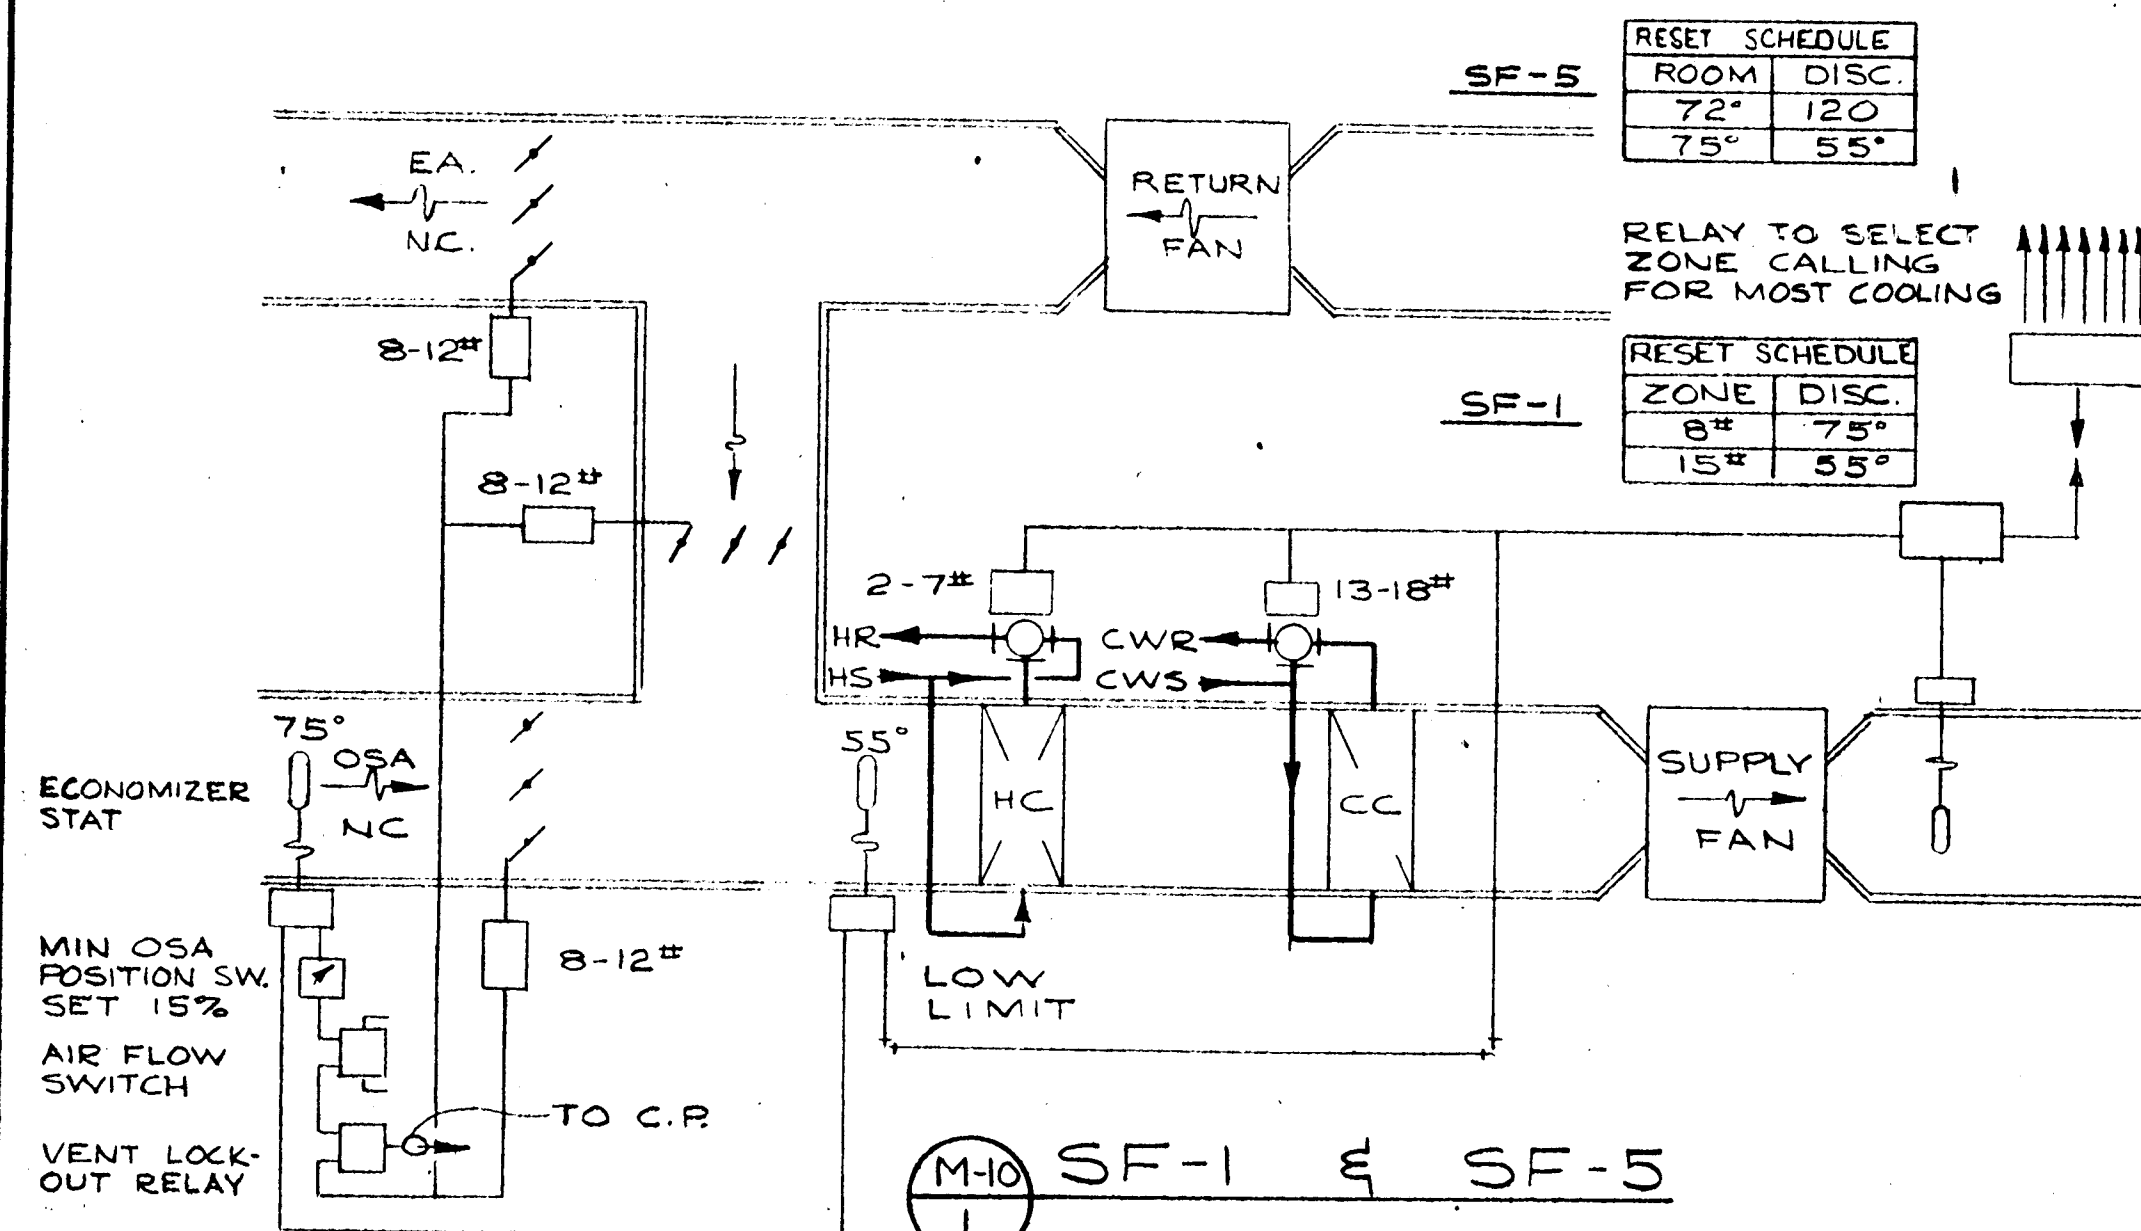


M-10 2 VARIABLE VOLUME BOX

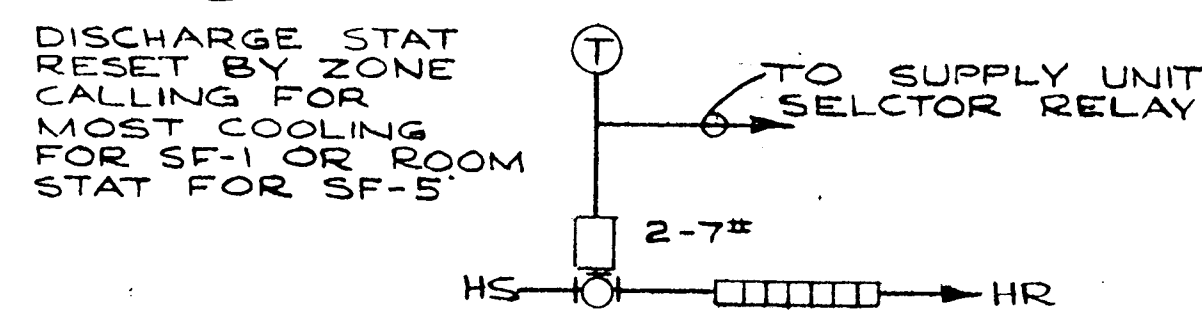


M-10 3 RADIATION


AQUASTAT STOP FAN IF HW NOT AVAILABLE

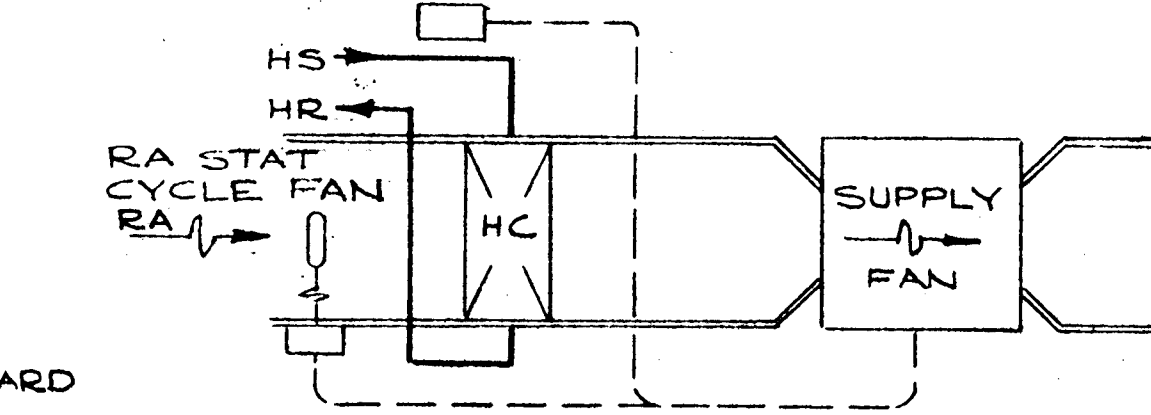


M-10 5 CUH

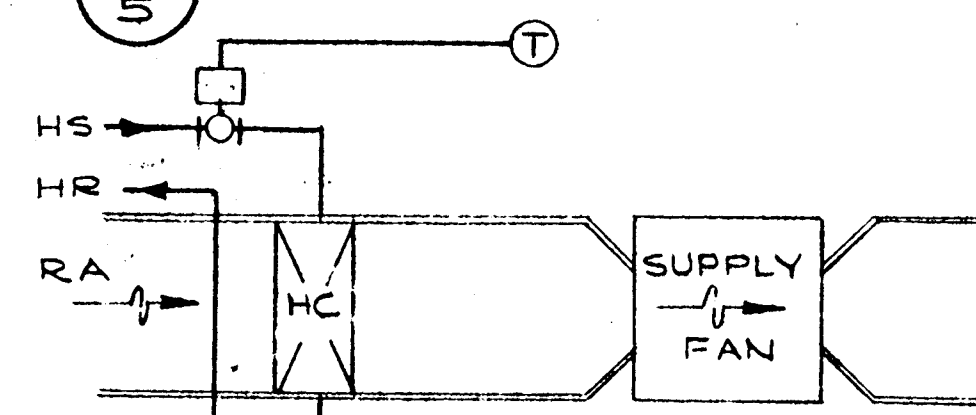


M-10 7 SF-7 & SF-8

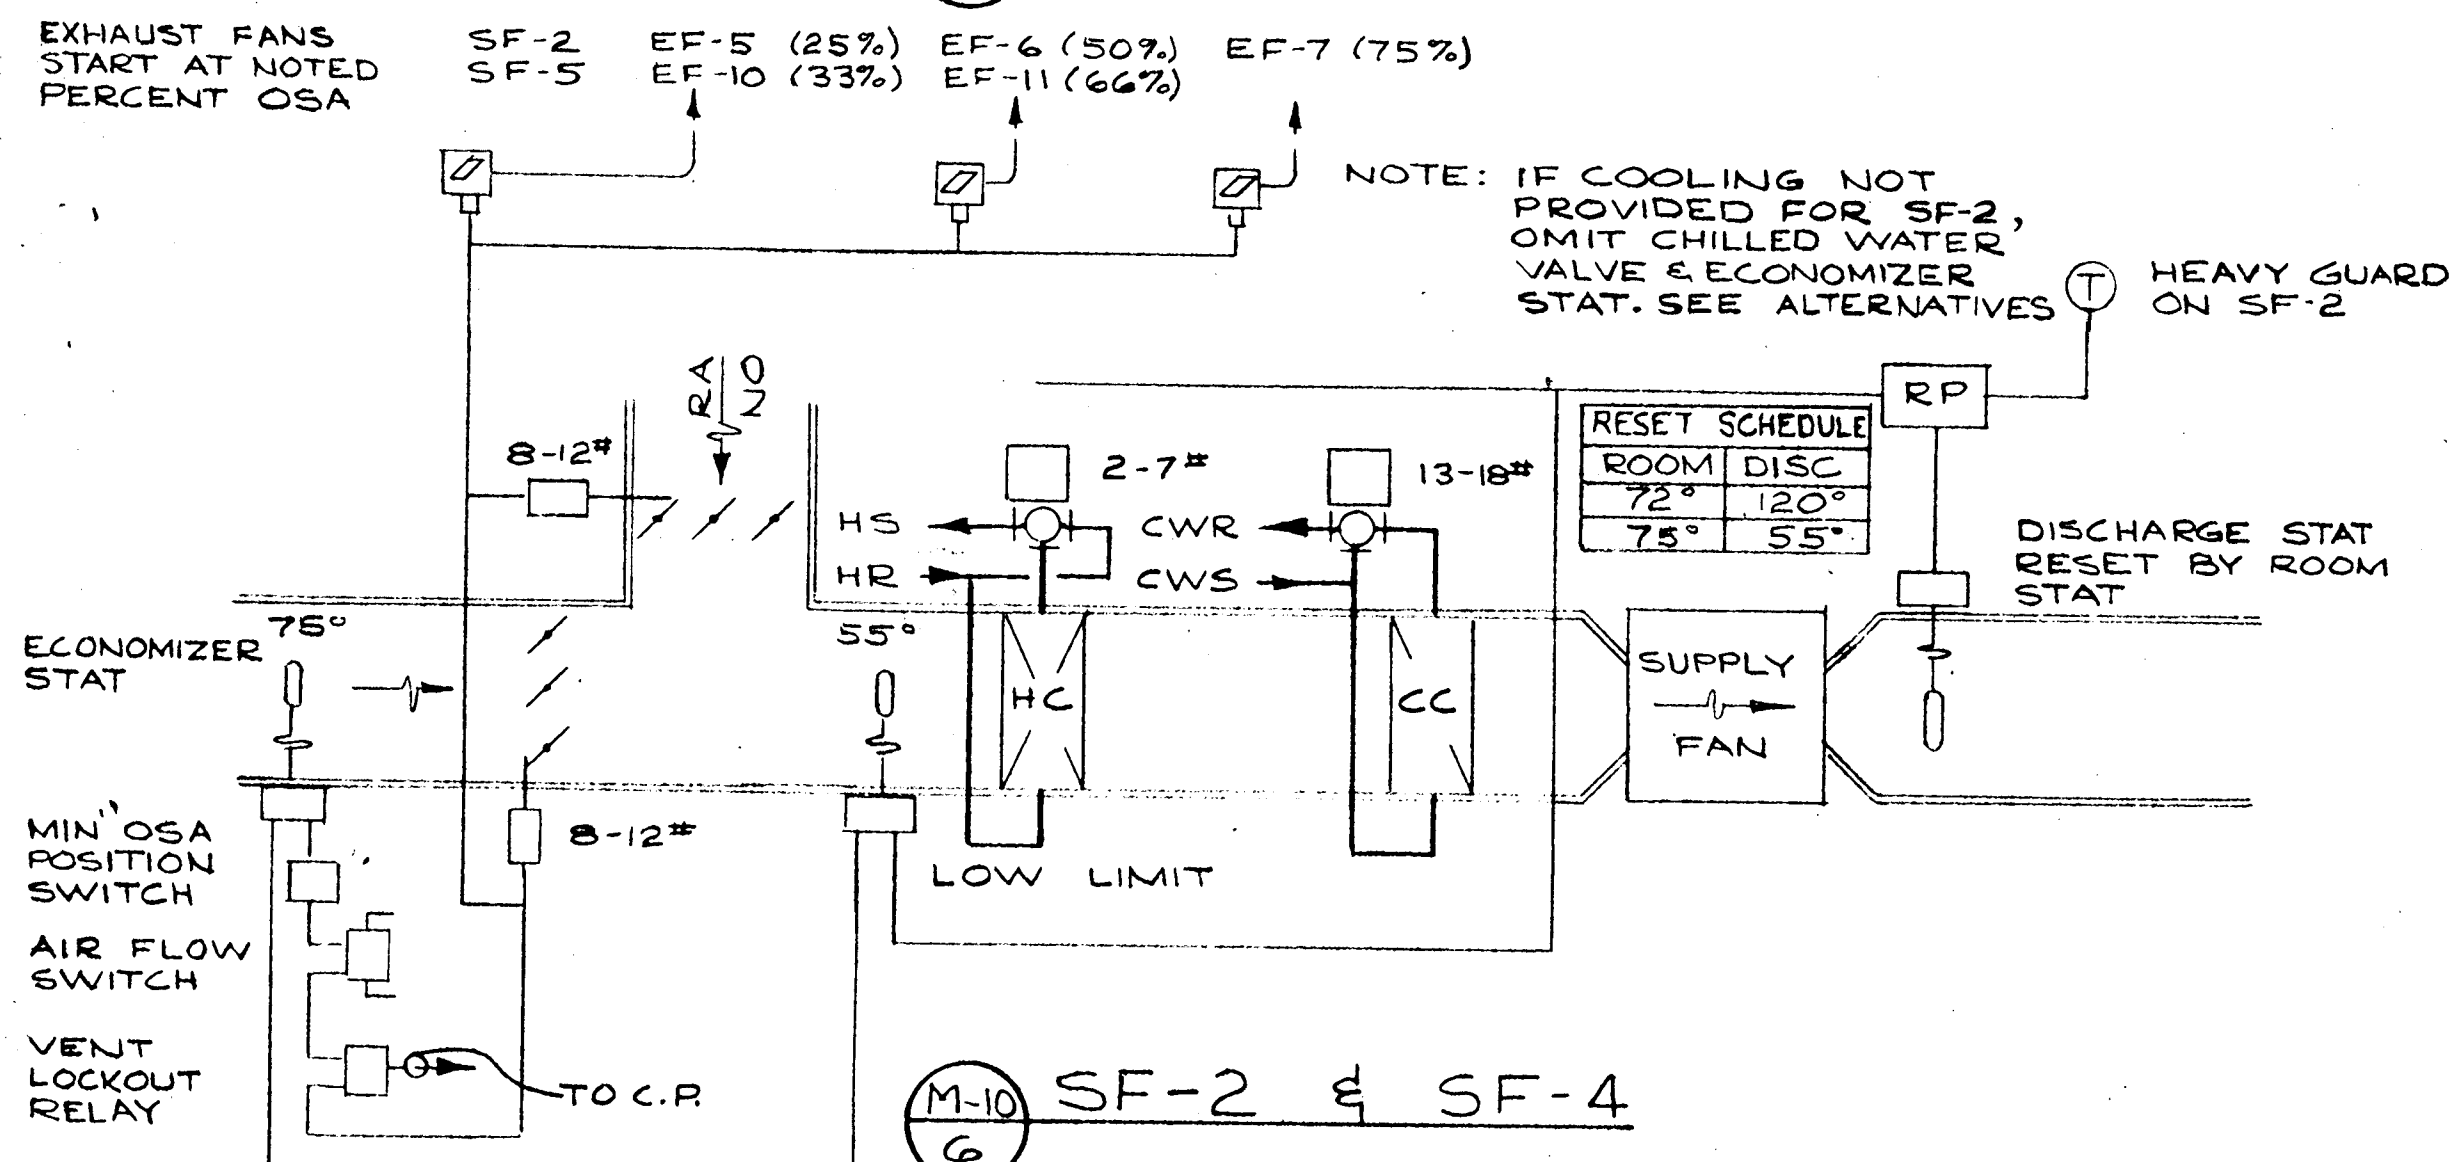


M-10 6 SF-2 & SF-4

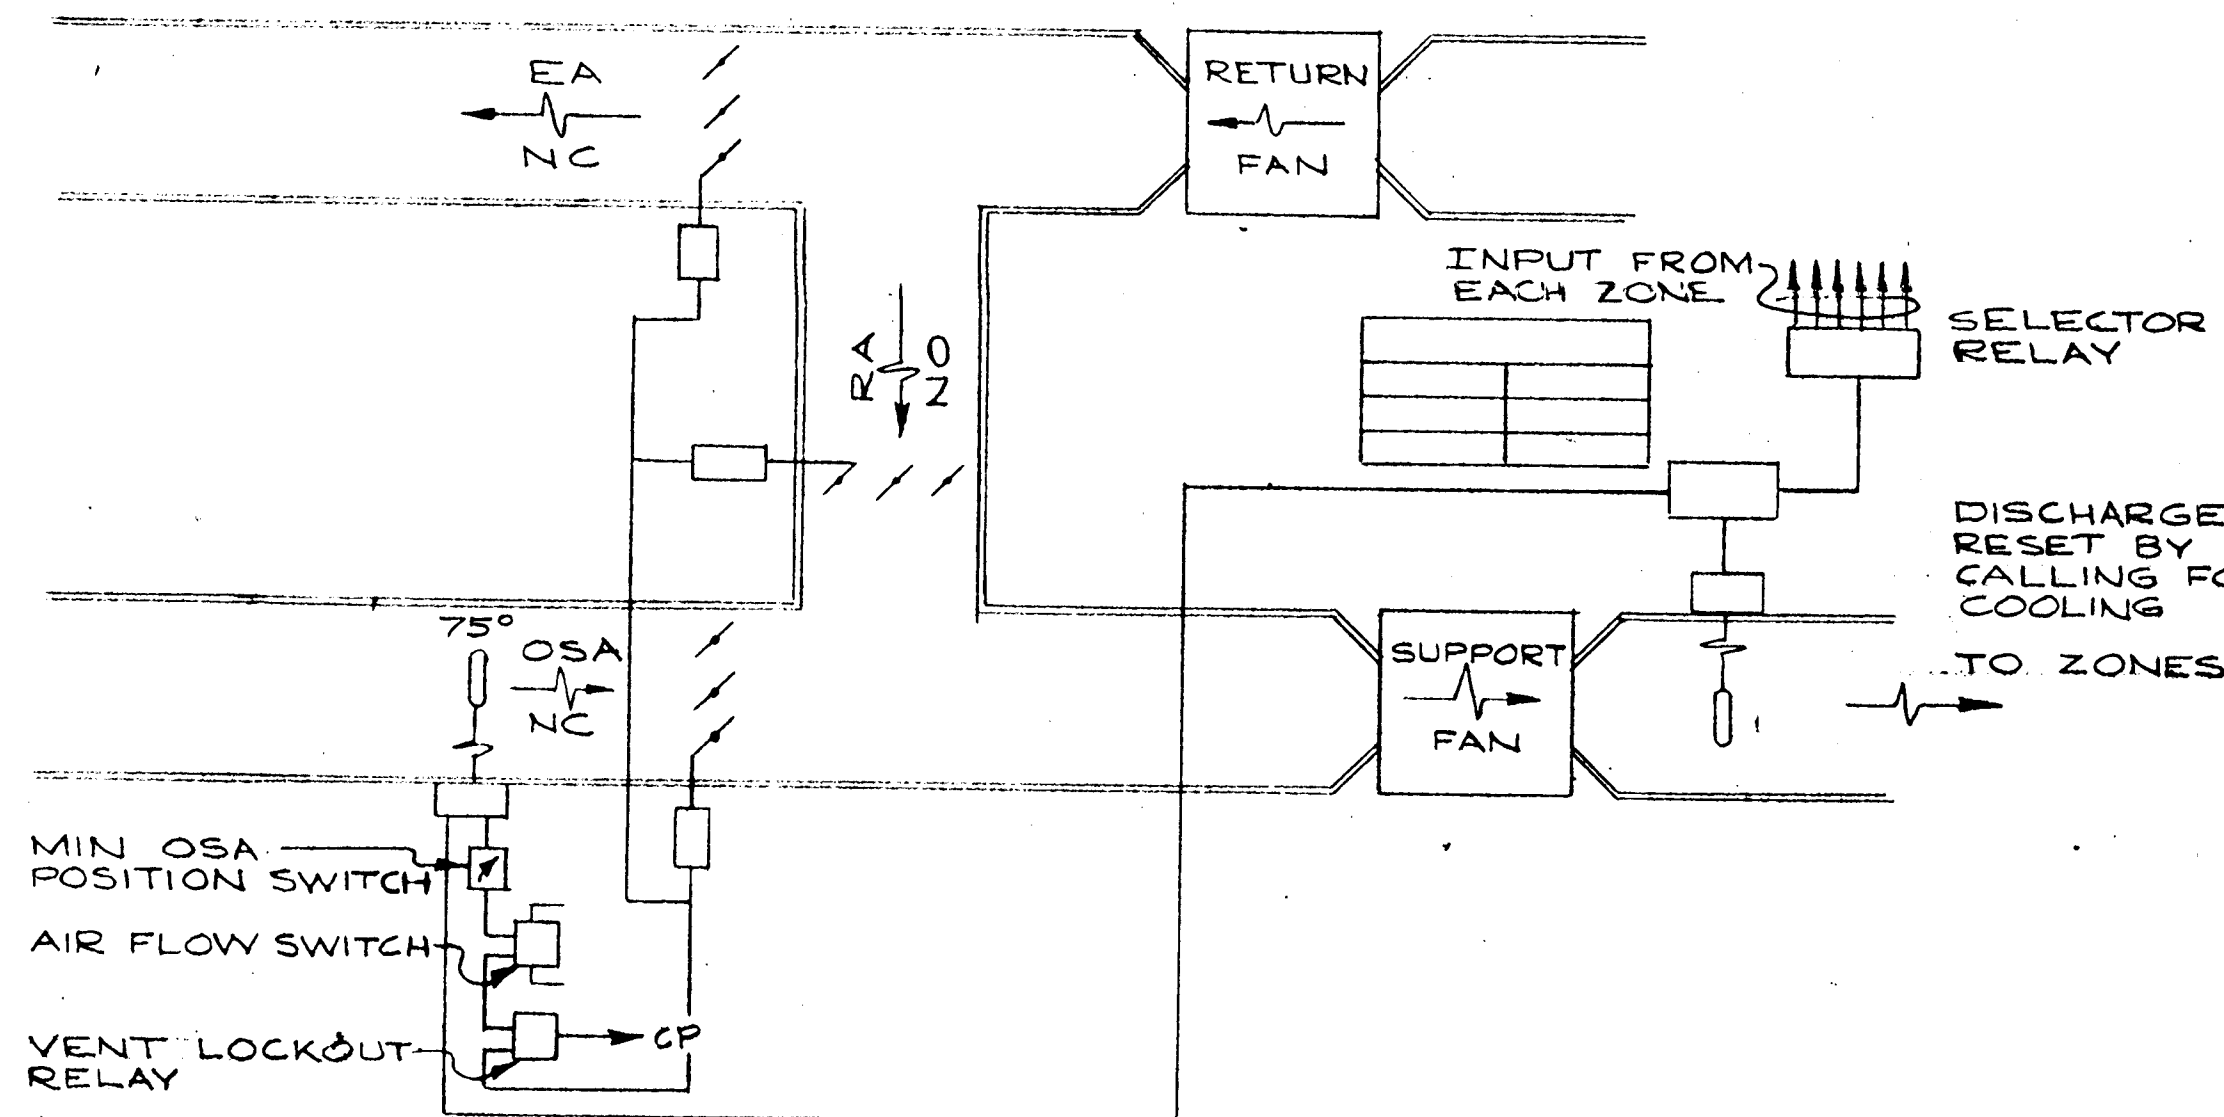


M-10 8 SF-3

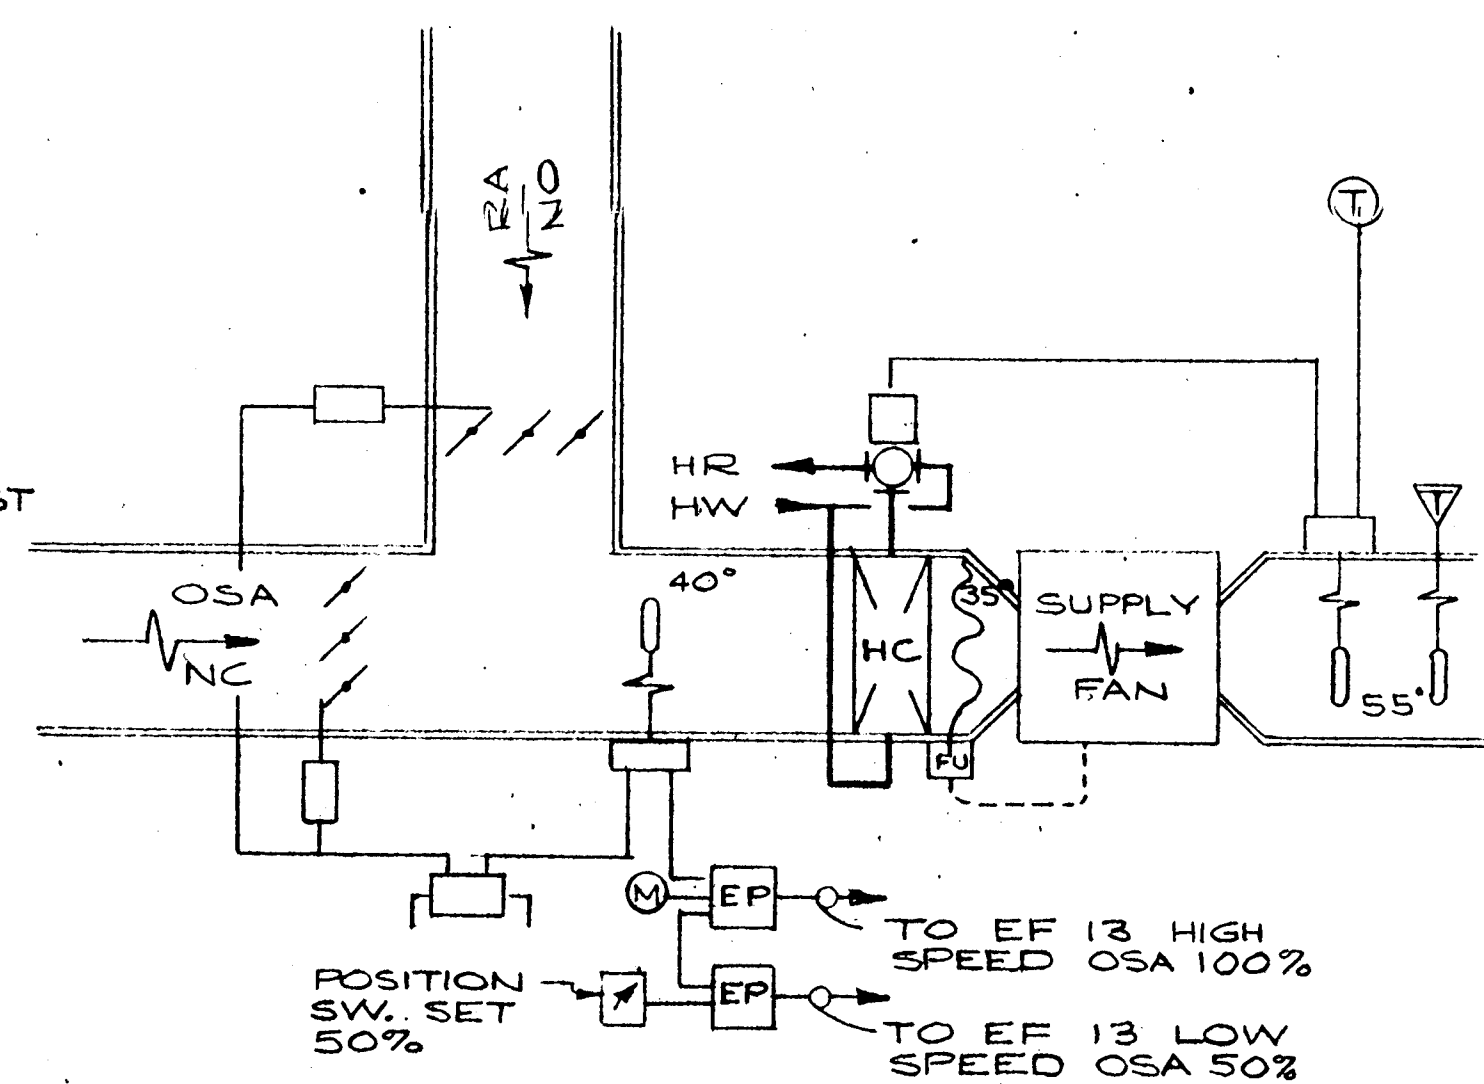


M-10 9 SF-6

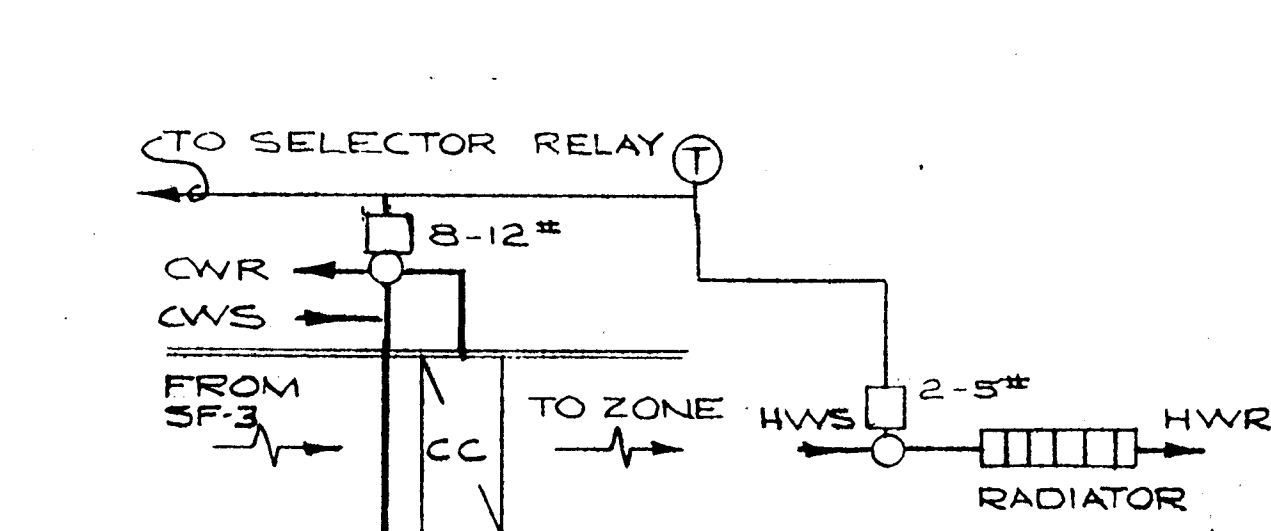

M-10 4 PERIMETER ZONES

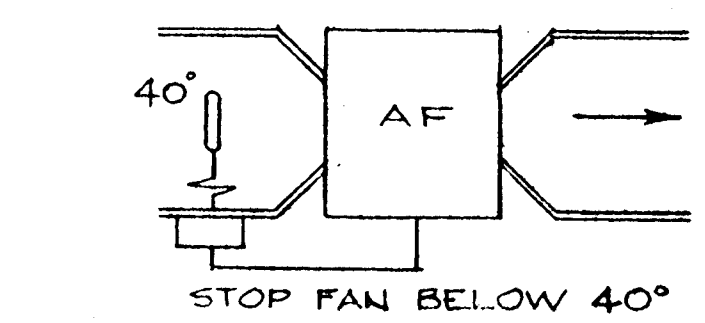

M-10 10 ATTIC FAN

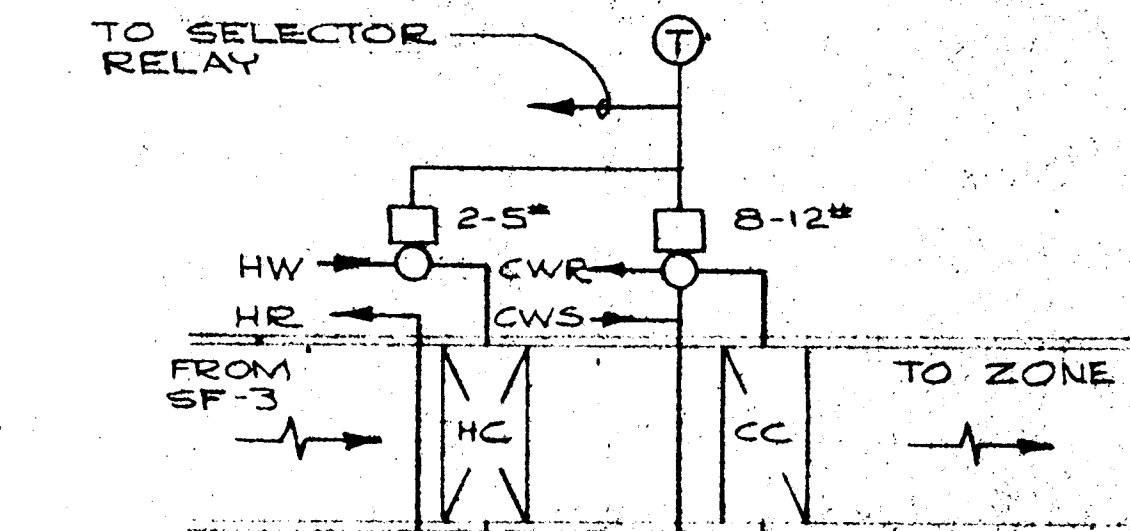

M-10 11 INTERIOR ZONES

CONTROL SEQUENCE

SF-1: SUPPLY RETURN FANS START FROM CENTRAL TIME CONTROL SYSTEM. ROOM STAT OPERATES VARIABLE VOLUME BOX OR RADIATION CONTROL VALVE THROUGH LOWER HALF OF CONTROL RANGE. UPPER HALF OF CONTROL RANGE OF STAT CALLING FOR MOST COOLING RESETS UNIT DISCHARGE STAT. DISCHARGE STAT OPERATES UNIT HEATING VALVE, DAMPERS, & UNIT COOLING VALVE IN SEQUENCE. OUTSIDE AIR CLOSING TO MINIMUM ABOVE 75° OUTSIDE. OUTSIDE AIR CLOSED ON FAN STOP & UNIT VENTILATION ALLOWED BY CENTRAL TIME CONTROL SYSTEM.

SF-2: SUPPLY FAN STARTS FROM CENTRAL TIME CONTROL SYSTEM. ROOM STAT RESETS CONTROL POINT OF DISCHARGE STAT. DISCHARGE STAT OPERATES UNIT HEATING VALVE, DAMPERS, & UNIT COOLING VALVE IN SEQUENCE. OUTSIDE AIR CLOSING TO MINIMUM ABOVE 75° OUTSIDE. OUTSIDE AIR CLOSED ON FAN STOP & UNTIL VENTILATION ALLOWED BY CENTRAL TIME CONTROL SYSTEM. EF-5, 6, 7 INTERLOCKED TO OPERATE WHEN OSA DAMPER 25%, 50% & 75% OPEN RESPECTIVELY.

SF-3: SUPPLY AND RETURN FANS START FROM CENTRAL TIME CONTROL SYSTEM. PERIMETER ZONE ROOM STAT OPERATES RADIATION VALVES THROUGH LOWER THIRD OF RANGE, RESET UNIT THROUGH MIDDLE THIRD OF RANGE, & OPERATE ZONE COOLING COIL THROUGH UPPER THIRD OF RANGE. INTERIOR ZONE ROOM STAT OPERATES ZONE HEATING COIL THROUGH LOWER THIRD OF RANGE, RESET UNIT THROUGH MIDDLE THIRD OF RANGE, & OPERATE ZONE COOLING COIL THROUGH UPPER THIRD OF RANGE. RELAY SELECTS ZONE CALLING FOR GREATEST COOLING WHICH RESETS UNIT DISCHARGE STAT THROUGH MIDDLE THIRD OF RANGE. DISCHARGE STAT OPERATES DAMPERS. OUTSIDE AIR CLOSING TO MINIMUM ABOVE 75° OUTSIDE. OUTSIDE AIR CLOSING ON FAN STOP & UNTIL VENTILATION ALLOWED BY CENTRAL TIME CONTROL SYSTEM.

SF-4: OPERATES AS NOTED FOR SF-2 EXCEPT EF-10 AT 33% & EF-11 AT 66% ARE INTERLOCKED EXHAUST FANS.

SF-5: OPERATES AS NOTED FOR SF-1 EXCEPT DISCHARGE STAT RESET BY SINGLE UNIT ROOM STAT.

SF-6: SUPPLY FAN STARTS FROM CENTRAL TIME CONTROL SYSTEM ROOM STAT & DISCHARGE, LOW LIMIT OPERATE UNIT HEATING VALVE. ANTIFREEZE STAT STOPS FAN. OUTSIDE AIR OPEN 50% IF EF-13 ON LOW SPEED & TO 100% IF EF-13 ON HIGH SPEED. OUTSIDE AIR SUBJECT TO MIXED AIR LOW LIMIT. OUTSIDE AIR CLOSED ON FAN STOP.

SF-7: SUPPLY FAN STARTS FROM CENTRAL TIME CONTROL SYSTEM. ROOM STAT OPERATES HEATING COIL VALVE.

SF-8: OPERATES AS NOTED FOR SF-7.

CUH: RETURN AIR THERMOSTAT CYCLES FAN SUBJECT TO AQUASTAT WHICH KEEPS FAN OFF UNLESS HEATING AVAILABLE.

AF: ATTIC STAT CYCLES FAN WITH OPERATION ABOVE 50°.

DOMESTIC HOT WATER: TANK STAT OPERATES HEATING VALVE. P-6 ON IF VALVE OPEN. RETURN LINE AQUASTAT CYCLES RECIRCULATION PUMP P-5.

BOILER: P-1 OR P-2 OPERATE FROM CENTRAL TIME CONTROL SYSTEM SUBJECT TO ON-AUTO SWITCH. PROVIDE ALTERNATOR SWITCH. SELECTED PUMP OFF ABOVE 75° OUTSIDE & OPERATES CONSTANT BELOW 32° OUTSIDE REGARDLESS OF OTHER CONTROL. MAIN HEATING 3-WAY VALVES CONTROLLED BY DISCHARGE STAT RESET BY OUTSIDE STAT. **BOILER OPERATES WHEN P-1, P-2 OR P-6 ON.**

CHILLER: SYSTEM OPERATES FROM CENTRAL TIME CONTROL SYSTEM SUBJECT TO AUTO-OFF SWITCH. IF OPERATION PROGRAMMED & OSA ABOVE 60°, P-3 STARTS. P-4 STARTS IF TOWER FILLED AS SENSED BY FLOAT SWITCH. COOLING TOWER FAN ALLOWED TO OPERATE & CHILLER ALLOWED TO OPERATE IF FLOW IS PROVEN IN CONDENSER & CHILLER CIRCUITS. COOLING TOWER FAN CYCLED BY SUMP STAT. P-3 OPERATES CONSTANT BELOW 32° OUTSIDE.

CENTRAL TIME CONTROL SYSTEM: SYSTEM TIME SWITCH (3RD'D) START ASSOCIATED SUPPLY SYSTEMS. VENTILATION TIME SWITCH STARTS ASSOCIATED EXHAUST FANS & ALLOWS OUTSIDE DAMPERS TO OPEN. BY PASS TIMERS RESTORE INDIVIDUAL SUPPLY SYSTEM OPERATIONS & BY PASS BOTH VENTILATION & SYSTEM TIME SWITCHES. NIGHT LOW LIMIT STAYS BY PASS SYSTEM TIME SWITCH FOR ASSOCIATED SYSTEM ONLY. PILOTS AT CENTRAL PANEL SHALL INDICATE IF ASSOCIATED SYSTEM FANS FAIL TO OPERATE. SEE DRAWINGS FOR FANS ASSIGNED TO EACH TIME SWITCH, BY PASS TIMER ALARM PILOT, & NIGHT LOW LIMIT STAT.

BOILER INTERLOCK PROVIDED TO START P-1 OR P-2 IF ANY SUPPLY SYSTEM OPERATES FROM TIME SWITCH, BY PASS, OR NIGHT LOW LIMIT STAT.

CONTROL DIAGRAMS
SW. BROCKMAN ROAD AND SW. DAVIES ROAD
BEAVERTON OREGON
ELEMENTARY SCHOOL - DISTRICT 48
BEAVERTON WASHINGTON COUNTY

WILLIAMS & EHMANN-AIA
ARCHITECTS-PLANNERS
3777 S.E. MILWAUKEE AVENUE
PORTLAND, ORE. 97202 503-232-1195

REVISIONS
DATE 1-20-74
COM 13-67
SHEET
M 10
OF 11

SUPPLY FAN SCHEDULE

[illegible]

COOLING COIL SCHEDULE

SYMBOL	SERVING	CFM	SIZE			MAX FACE VEL FPM	AIR TEMP				ENT H ₂ O TEMP	MAX GPM	MAX AIR PD IN H ₂ O	MAX H ₂ O PD IN H ₂ O	MAX TINS/ INCH	MBH	REMARKS
			NO	HDR	TUBES		ENT		LVG								
							DB	WB	DB	WB							
CC-1	FOYER	1250	1	18	24"	415	77.4	64	55	54.5	45	7	.75"	5'	8	36	
CC-2	GYM OFFICE	620	1	12	18	415	77.4	64	55	54.5	45	3.5	.75"	5'	8	18.0	
CC-3	PRINCIPAL	600	1	12	18	400	77.4	64	55	54.5	45	3.5	.75"	5'	8	18.0	
CC-4	OFFICE	550	1	12	18"	366	77.4	64	55	54.5	45	3.2	.75"	5'	8	16	
CC-5	FACULTY	500	1	12	12	500	77.4	64	55	54.5	45	2.9	.75"	5'	8	14	
CC-6	SPECIAL ED	300	1	9	12	400	77.4	64	55	54.5	45	1.7	.75"	5'	8	9	

HEATING COIL SCHEDULE

SYMBOL	SERVING	CFM	SIZE		MAX FACE VEL. FPM	MAX AIR PD IN H ₂ O	AIR TEMP		WTR TEMP		MAX GPM	MAX FINS INCH	MBH	MAX WTR PD.	PIPE SIZE
			NO.	HDR TUBE			ENT	LVG	ENT	LVG					
HC-1	FOYER	1250	18	24	416	.75"	62.7	82.7	180	140	1.4	8	27	5'	1/2"
HC-2	GYM OFFICE	620	12	18	413	.75"	62.7	82.7	180	140	.7	8	14	5'	1/2"
HC-3	OFFICE	550	12	18	366	.75"	62.7	82.7	180	140	.6	8	12	5'	1/2"
HC-4	SPECIAL ED.	300	4	12	400	.75"	62.7	82.7	180	140	.4	8	7	5'	1/2"

EXHAUST & RETURN FAN SCHEDULE

SYMBOL	SERVING	CFM	TOTAL SP WATER	MOTOR			MAX SONES AT 5FT	TYPE	REMARKS
				HP	VOLT	PHASE			
EF-1	BOYS & GIRLS LAV	1200	3/8"	1/3	120	1	5.0	ROOF	PACE CRE-11
EF-2+3	TOILET	100	1/4	-	120	1	5.0	ROOF	PACE DD-200 R
EF-4	FACULTY	500	3/8	1/8	120	1	3.0	ROOF	PACE DD-650 R, SOUND CURB
EF-5,6,7,8	GYM	1800	3/8	1/2	208	3	3.0	ROOF	PACE CRE-15, SOUND CURB
EF-9	LOCKER ROOMS	1500	3/8	1/3	120	1	5.0	ROOF	PACE CRE-15,
EF-10,11	CAFETERIA	2000	3/8	1/2	208	3	3.0	ROOF	PACE CRE-16, SOUND CURB
EF-12	MAINTENANCE	200	1/4	-	120	1	5.0	ROOF	PACE DD-350 R
EF-13	RANGE HOOD	3800	1	1 1/2	208	3	7.5	ROOF	PACE CRE-20, 2 SPEED
EF-14	DISHWASHER HOOD	1200	1/2	1/2	208	3	7.5	ROOF	PACE CRE-11, 2 SPEED
EF-15,16	BLDG. 100	870	1/4	1/6	120	1	5.0	CEILING	PACE DD 850
RF-1	BLDG. 100	12,000	1/2	5	208	3	-	AXIAL	TRANE MODEL Q SIZE 44
RF-2	ADMINISTRATION	2800	3/4	3/4	208	3	-	AXIAL	TRANE MODEL Q SIZE 19
RF-3	MUSIC ROOM	1500	5/8	1/2	208	3	-	AXIAL	TRANE MODEL Q SIZE 16

PUMP SCHEDULE

SYMBOL	SERVING	GPM	HEAD WATER	WATER TEMP °F	MOTOR			TYPE PUMP	RPM	REMARKS
					HP	VOLT	PHASE			
P-1-2	HEATING PUMPS	90	105	210	7 1/2	208	3	BASE MOUNT	1750	B&G NO U2-G
P-3	CHILLED WATER PUMP	180	52	45	5	208	3	CLOSE CPLD	1750	B&G NO 1531 2 1/2" B
P-4	CONDENSER WTR PUMP	210	40	95	5	208	3	CLOSE CPLD	1750	B&G NO 1531 4" AB
P-5	DOMESTIC WTR RECIRC. PUMP	10	15	140	1/6	120	1	IN LINE	1750	B&G 1" PR ALL BRONZE
P-6	HEAT EXCHANGER	10	15	210	1/6	120	1	IN LINE	1750	B&G 1" PR

MISCELLANEOUS EQUIPMENT

SYMBOL	DESCRIPTION	ELECTRICAL
B	<u>BOILER</u> : GAS FIRED, 1750 MBH, 52.3 HP, 2,188 MBH INPUT, 239 SQ FT. TOTAL HEATING SURFACE, KEWANEE MH75	3/4 HP BOILER MOTOR 230V, 1Ø
CH	<u>CHILLER</u> : 70 TONS, 45° LW.T., 179 GPM COND. WATER, 85° ENT, 95° LW.T., 10 FT. HD. COND. P.D., 15 FT. HD. CHILLER P.D. MAX. TRANE CG 75D	224 FLA 208 V 3 Ø
CT	<u>COOLING TOWER</u> : CAPACITY TO 210 GPM AT 70° WB, 95° EWT / 85° LW.T. SAC-VNT 50 B	7 1/2 HP FAN MOTOR
FP	<u>FINNED PIPE</u> : 4 1/4" x 1 1/4", 850 BTUH/FT., 33 FINS/FOOT, 180° AVERAGE WATER TEMP	
HE	<u>HEAT EXCHANGER</u> : (WATER HEATER) CAPACITY TO HEAT 4.2 GPM FROM 45° TO 140° WITH 10 GPM, 200° F.W.T., .0005 FOULING FACTOR	
CUH	<u>CABINET UNIT HEATER</u> : 600 CFM, 24 MBH, 190° F.W.T., PACE #GI-2	1/2 HP 120V, 1Ø
AF	<u>ATTIC FAN</u> : 4,000 CFM AT 1/4" S.F., 18" S.F., BELT DRIVE, TUBE AXIAL FAN, PACE TYPE TA	3/4 HP 208V, 3Ø

DATAPOINT CORP. 400 LITTLEFIELD AVE. SO. SAN FRANCISCO CA 94080

SA 114A H 25

SUN BRIGHMAN ROAD AND SEASIDE	SUN DAVIS ROAD OREGON
BEAVERTON	WASHINGTON COUNTY OREGON

WILLIAMS & EHMAN AIA
ARCHITECTS-PLANNERS


3777 S.E. MILWAUKIE AVENUE

REVISIONS

SECRET

M


OF

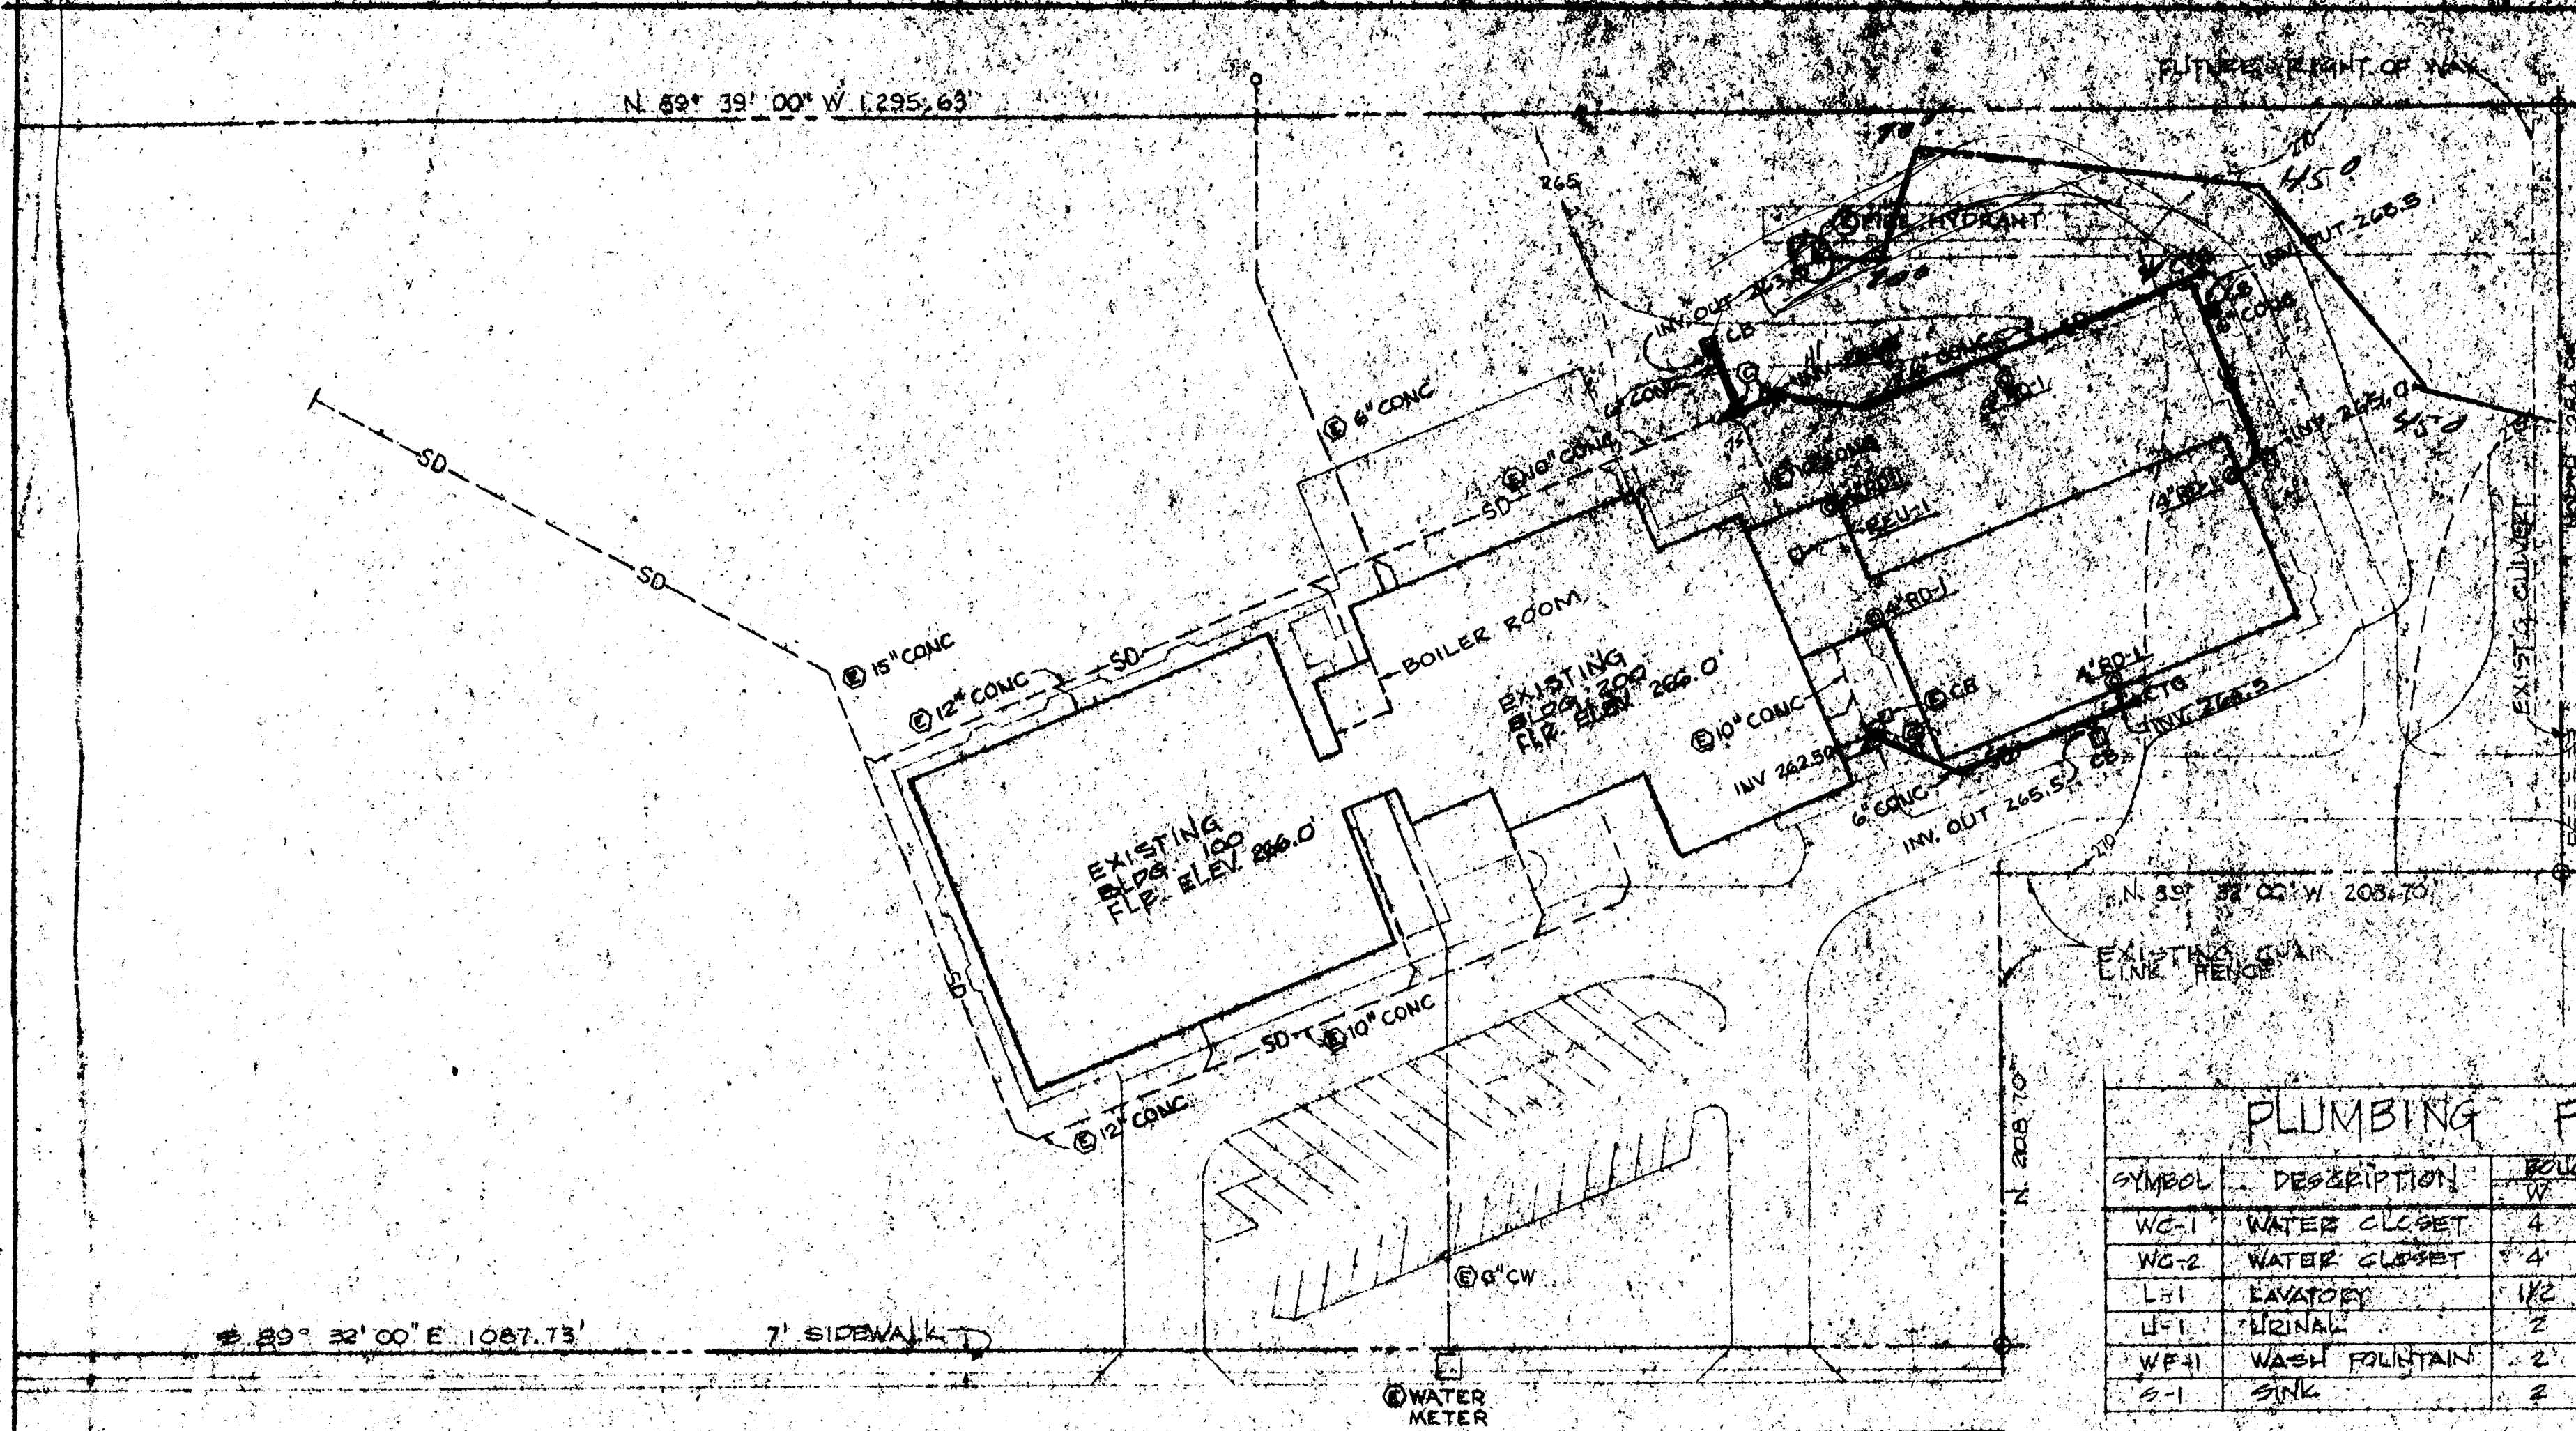


SYMBOL	DESCRIPTION	QUANTITY	REMARKS
WC-1	WATER CLOSET	4	WALL HUNG
WC-2	WATER CLOSET	4	HANDICAPPED HEIGHT
L-1	LAVATORY	1/2	HANDICAPPED TYPE
U-1	URINAL	2	
WF-1	WASH FOUNTAIN	2	SEMI-CIRCULAR
S-1	SINK	2	CLASSROOM SINK

- ### LEGEND
- CD CONDENSATE DRAIN
 - W SANITARY WASTE ABOVE GRADE
 - W SANITARY WASTE BELOW GRADE
 - SD STORM DRAIN ABOVE GRADE
 - SD STORM DRAIN BELOW GRADE
 - V VENT
 - CW COLD WATER
 - HW HOT WATER
 - RHW RECIRCULATED HOT WATER
 - GV GATE VALVE
 - GV GLOBE VALVE
 - CV CHECK VALVE
 - BV BUTTERFLY VALVE
 - BF BALANCING FITTING
 - WH WALL HYDRANT
 - DV HOSE END DRAIN VALVE
 - SA SHOCK ABSORBER, SIZE C (R.D.I. STANDARD 201)
 - PD PITCHED DOWN
 - AIR FLOW DIRECTION:
 - OSA DUCT SECTION, ROUND
 - RECUEN EXHAUST DUCT SECTION ROUND
 - INTERLUY INSULATED DUCT DOUBLE LINE, SINGLE LINE
 - FLEXIBLE DUCT CONNECTION
 - FLP FLEXIBLE KINK DAMPER DOUBLE LINE, SINGLE LINE
 - FLP BUTTERFLY KINK DAMPER DOUBLE LINE, SINGLE LINE
 - ROOM THERMOSTAT, WALL MOUNTED
 - ROOM THERMOSTAT, SUSPENDED
 - ROUND DUCT DIAMETER, INCHES
 - RECTANGULAR DUCT, INCHES
 - AIR SUPPLY UNIT
 - SUPPLY FAN
 - ROOF EXHAUST UNIT
 - UNIT HEATER
 - COOLING COIL
 - OUTSIDE AIR
 - AUTOMATIC DAMPER
 - OUTSIDE AIR DAMPER
 - RETURN AIR DAMPER
 - EXHAUST AIR DAMPER
 - CEILING SUPPLY DIFFUSER
 - CEILING EXHAUST GRILLE
 - LINEAR CEILING SUPPLY
 - FLOOR DRAIN
 - ROOF DRAIN
 - VENT THROUGH ROOF
 - CLEANOUT TO GRADE
 - FLOOR CLEANOUT
 - WALL CLEANOUT
 - CLEANOUT
 - INVERT ELEVATION
 - CAST IRON PIPE
 - CONCRETE PIPE
 - NOT IN MECHANICAL ROOM, REFERRED UNDER ANOTHER DIVISION
 - ELECTRIC HEATER, NIM
 - ELECTRIC BASEBOARD, NIM
 - ACCESS DOOR
 - CONNECT TO EXISTING
 - EXISTING TO REMAIN
 - BELOW FLOOR
 - CAP
 - RELOCATE EXISTING
 - REMOVE EXISTING


1 SITE PLAN
SCALE: 1" = 50'-0"
NOTE:
1. FOR ADDITIONAL GRADES SEE ARCHITECTURAL SITE PLAN.

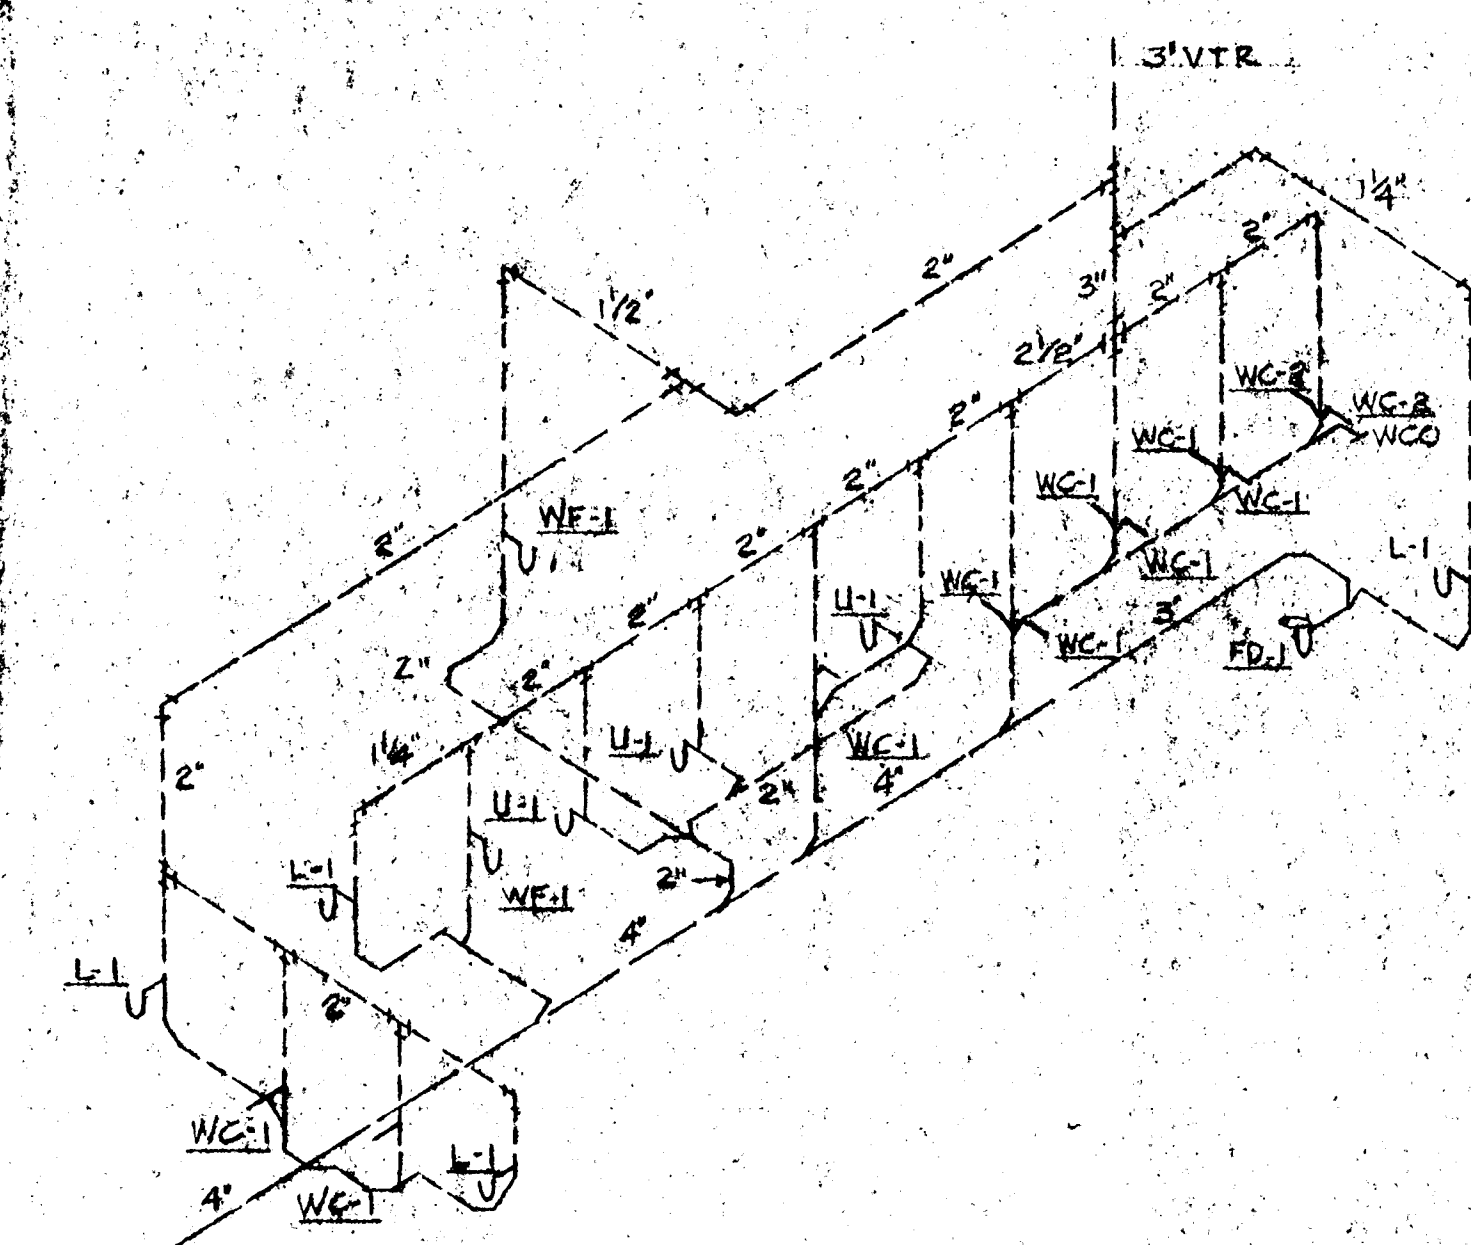

WASTE AND VENT

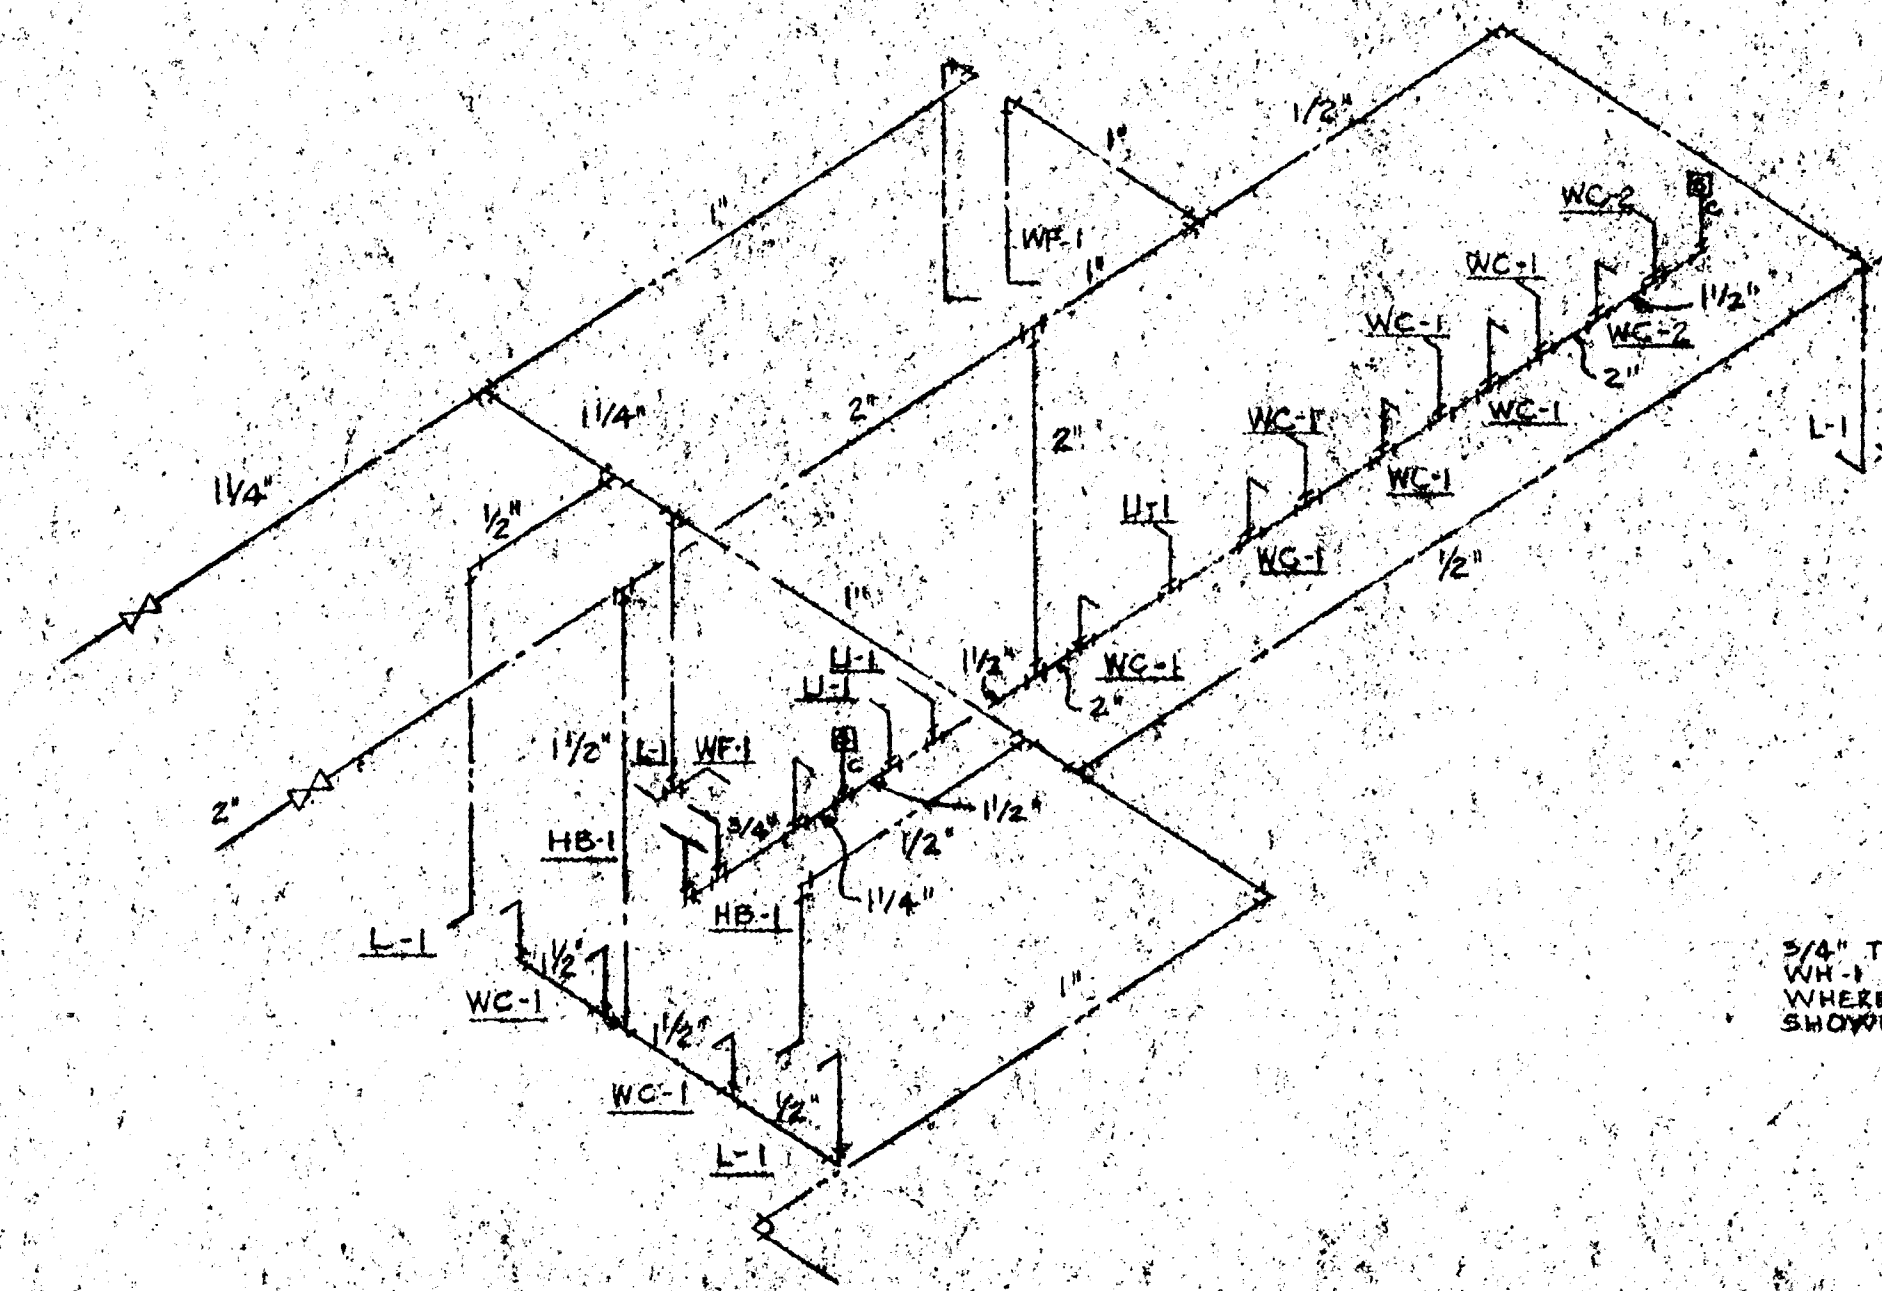



HOT AND COLD WATER

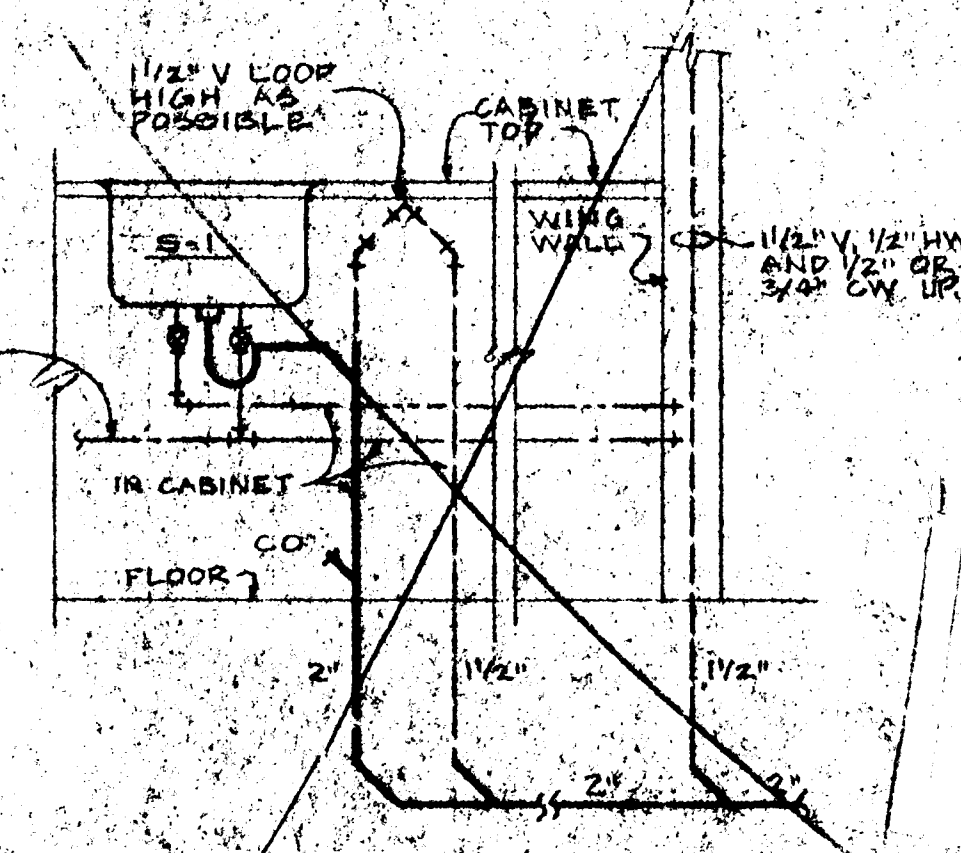

3 SINK WASTE AND VENT DIAGRAM
SCALE: NO SCALE

2 TOILET ROOM PLUMBING PIPING DIAGRAM
SCALE: NO SCALE

SIX CLASS ROOM ADDITION
HITEON ELEMENTARY SCHOOL
SCHOOL DISTRICT NO 48
1800 S.W. BROCKMAN RD - BEAVERTON, OREGON

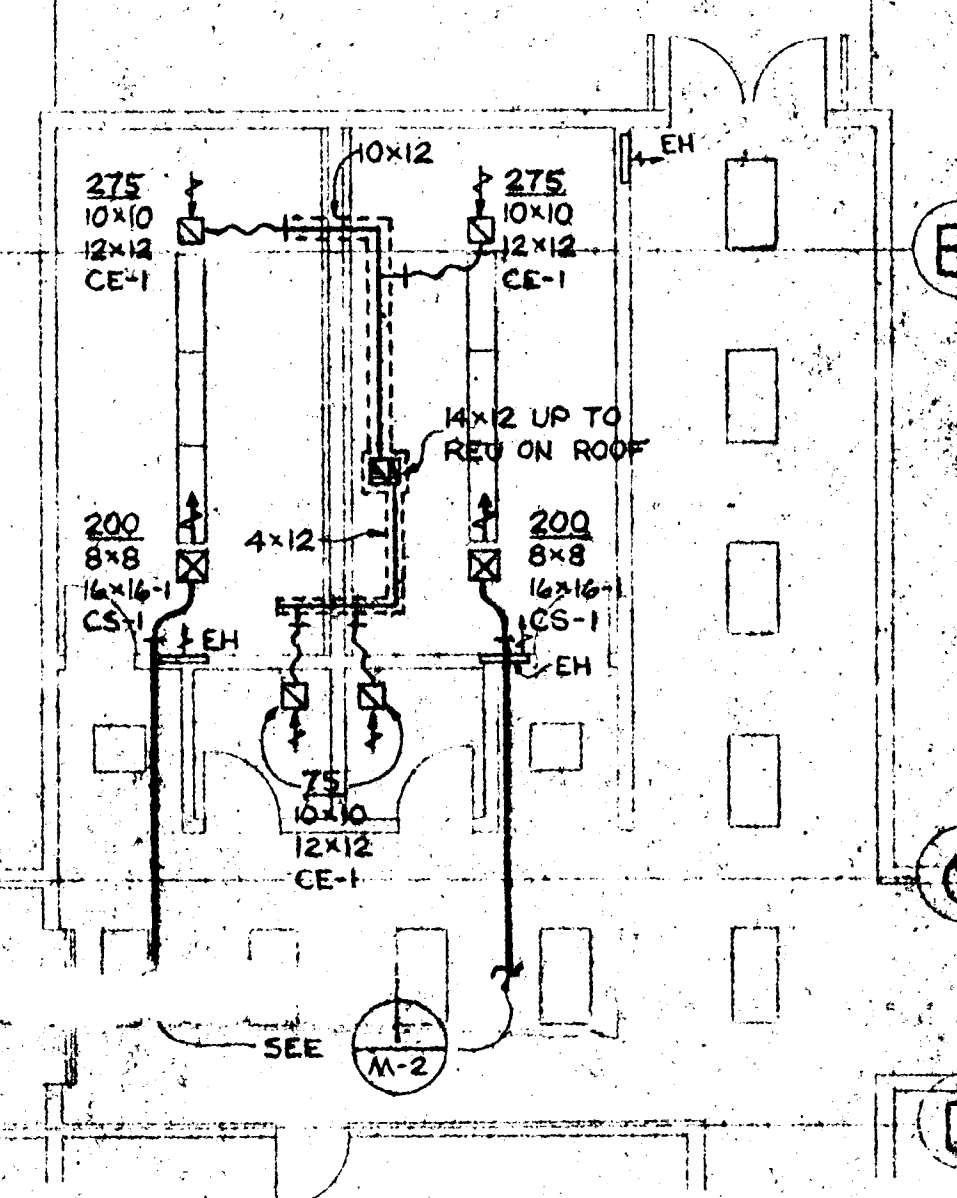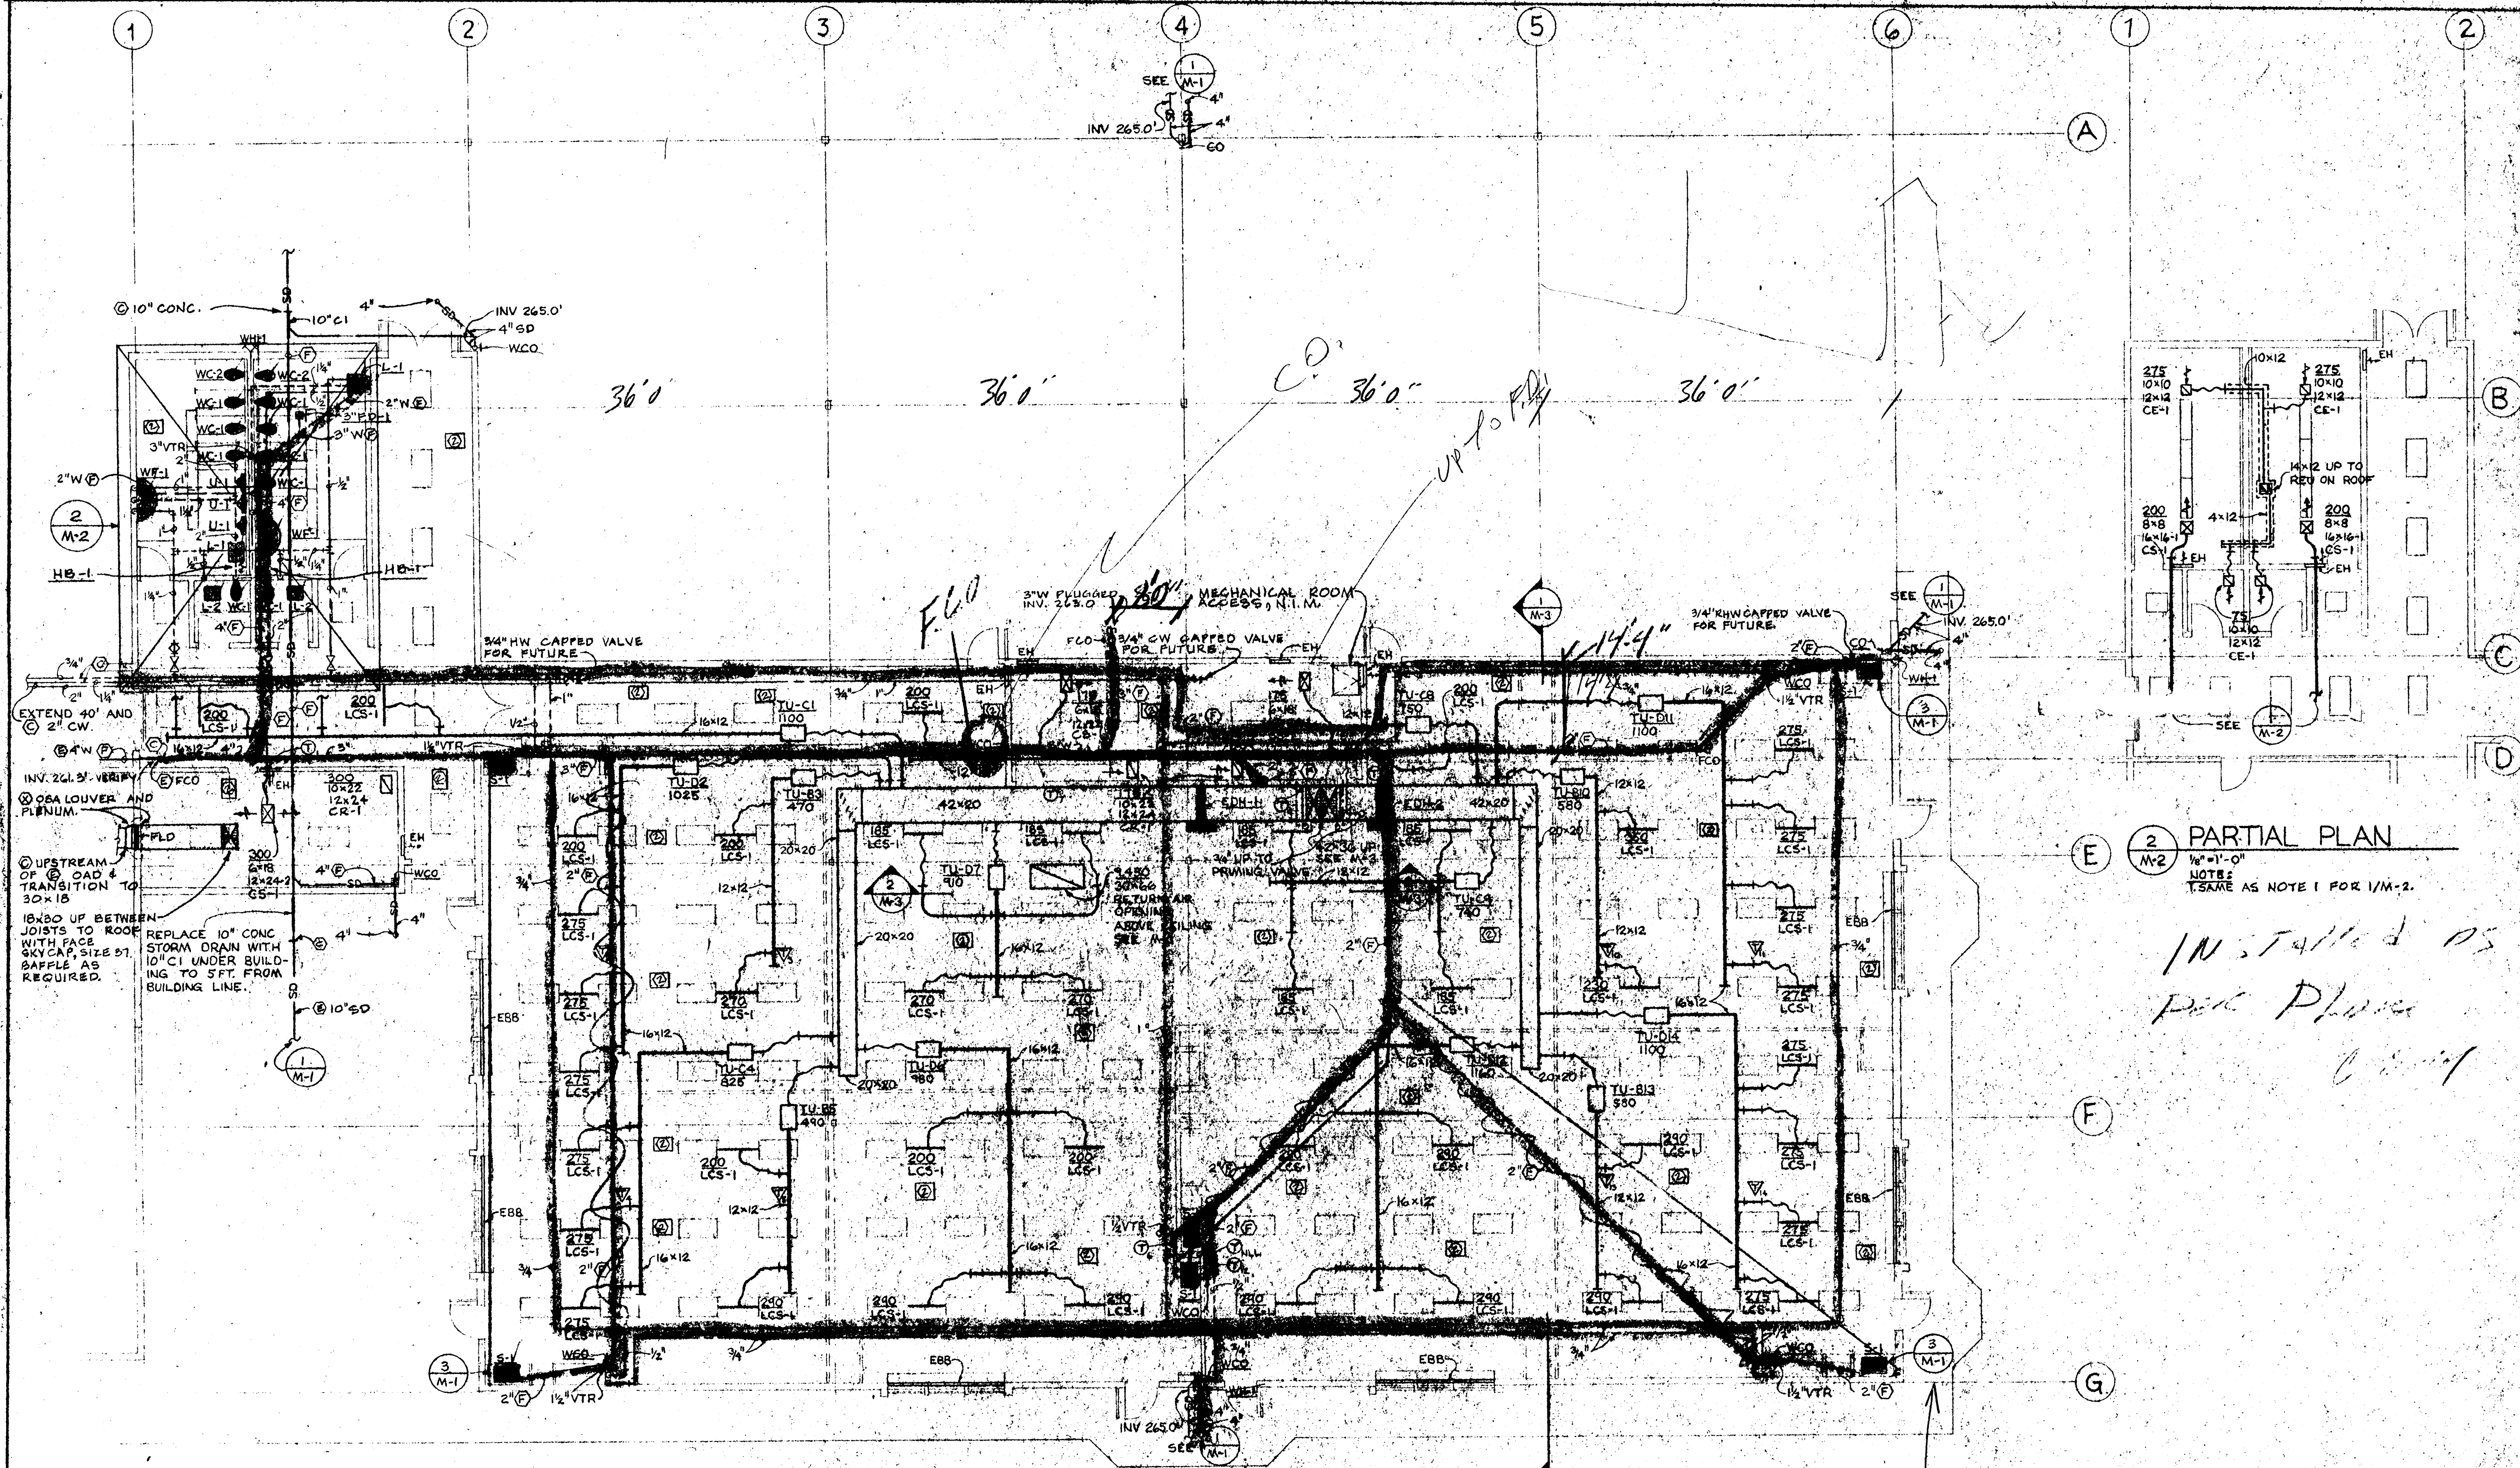




1 FLOOR PLAN
 1/8" = 1'-0"
 NOTES:
 1. ALL FLEXIBLE CONNECTORS AND RIGID ROUND DUCTS ARE 84, EXCEPT AS SCHEDULED FOR THE TERMINAL UNITS.
 2. 12x18 FLD AT GYPSUM BOARD ON BOTTOM OF T.J.S. FURNISHED AND INSTALLED BY MECHANICAL CONTRACTOR.

2 PARTIAL PLAN
 1/8" = 1'-0"
 NOTES:
 1. SAME AS NOTE 1 FOR 1/M-2.

INSTALLED AS
 per Plans
 6-2-7

SIX CLASSROOM ADDITION
 HITEON ELEMENTARY SCHOOL
 SCHOOL DISTRICT NO. 43
 15300 SW BROCKMAN RD - BEAVERTON, OREGON

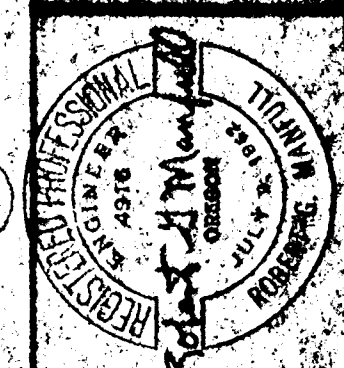


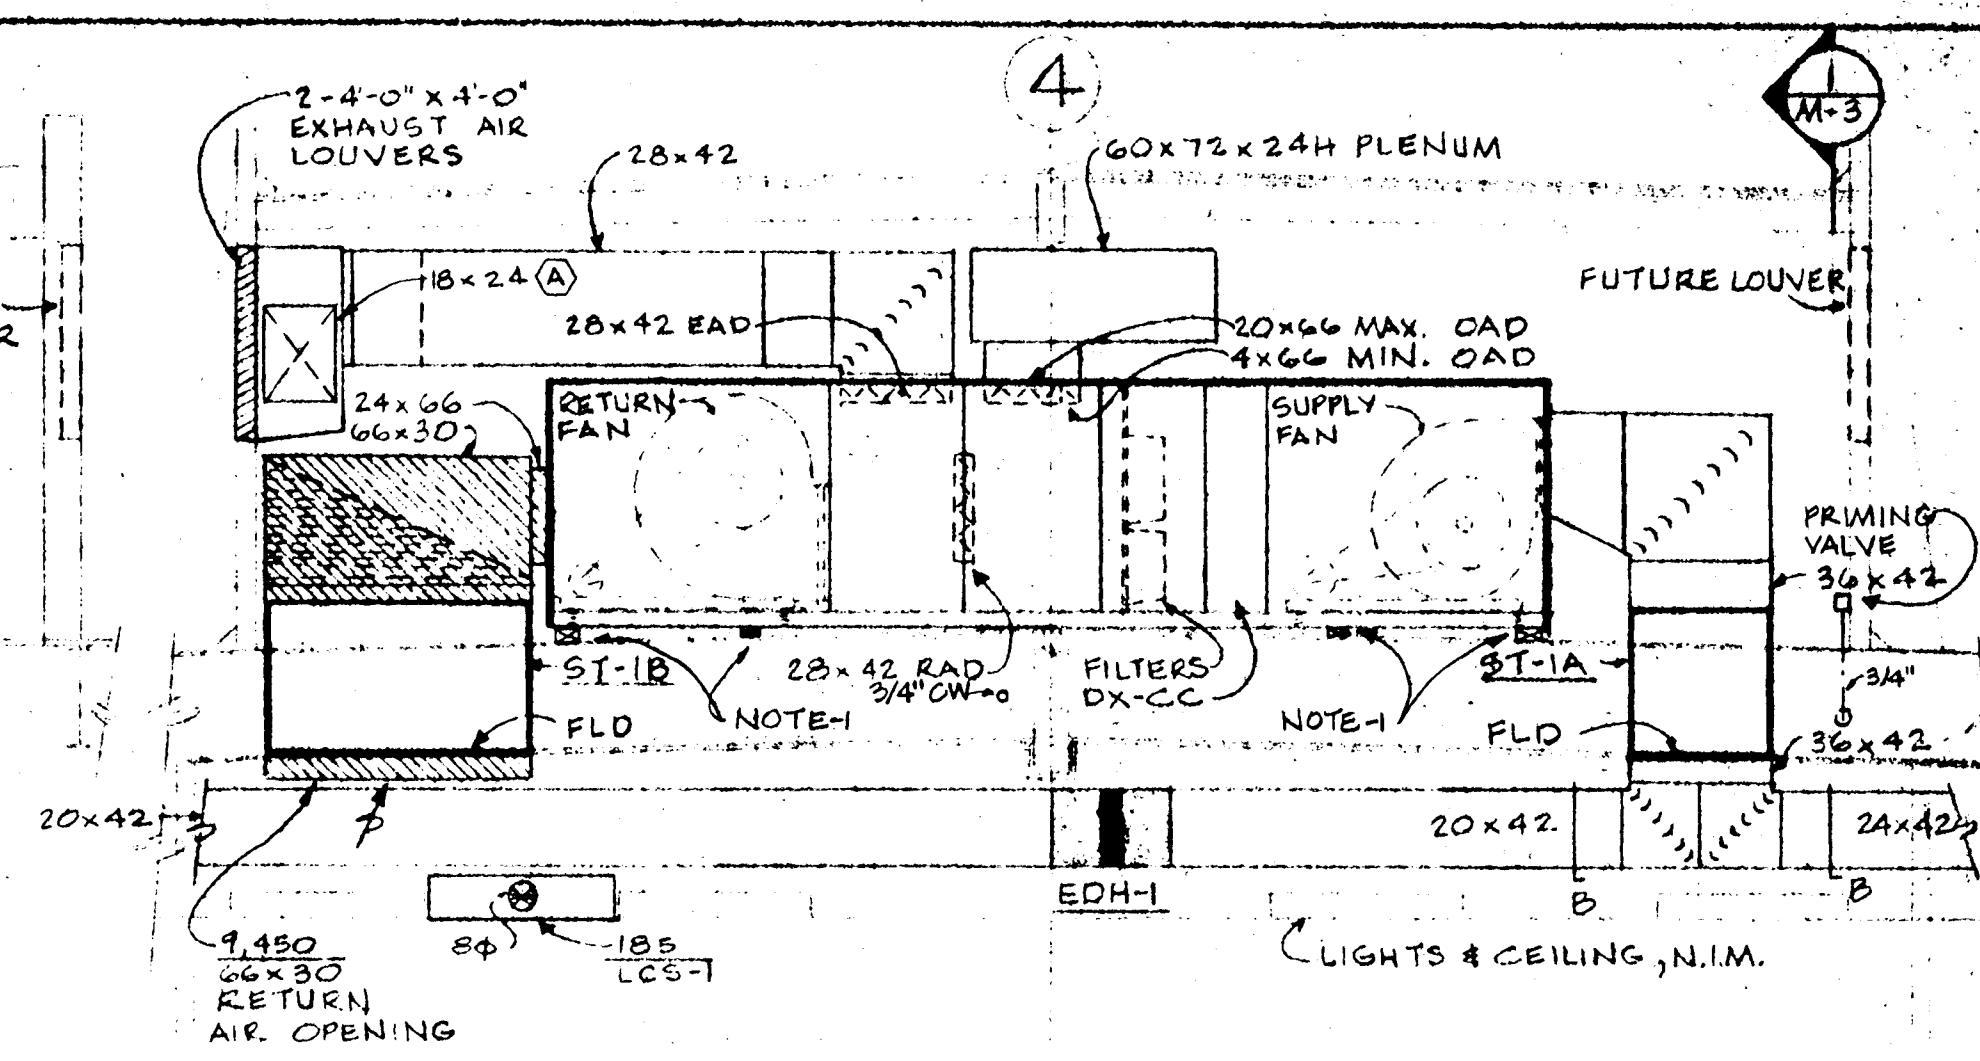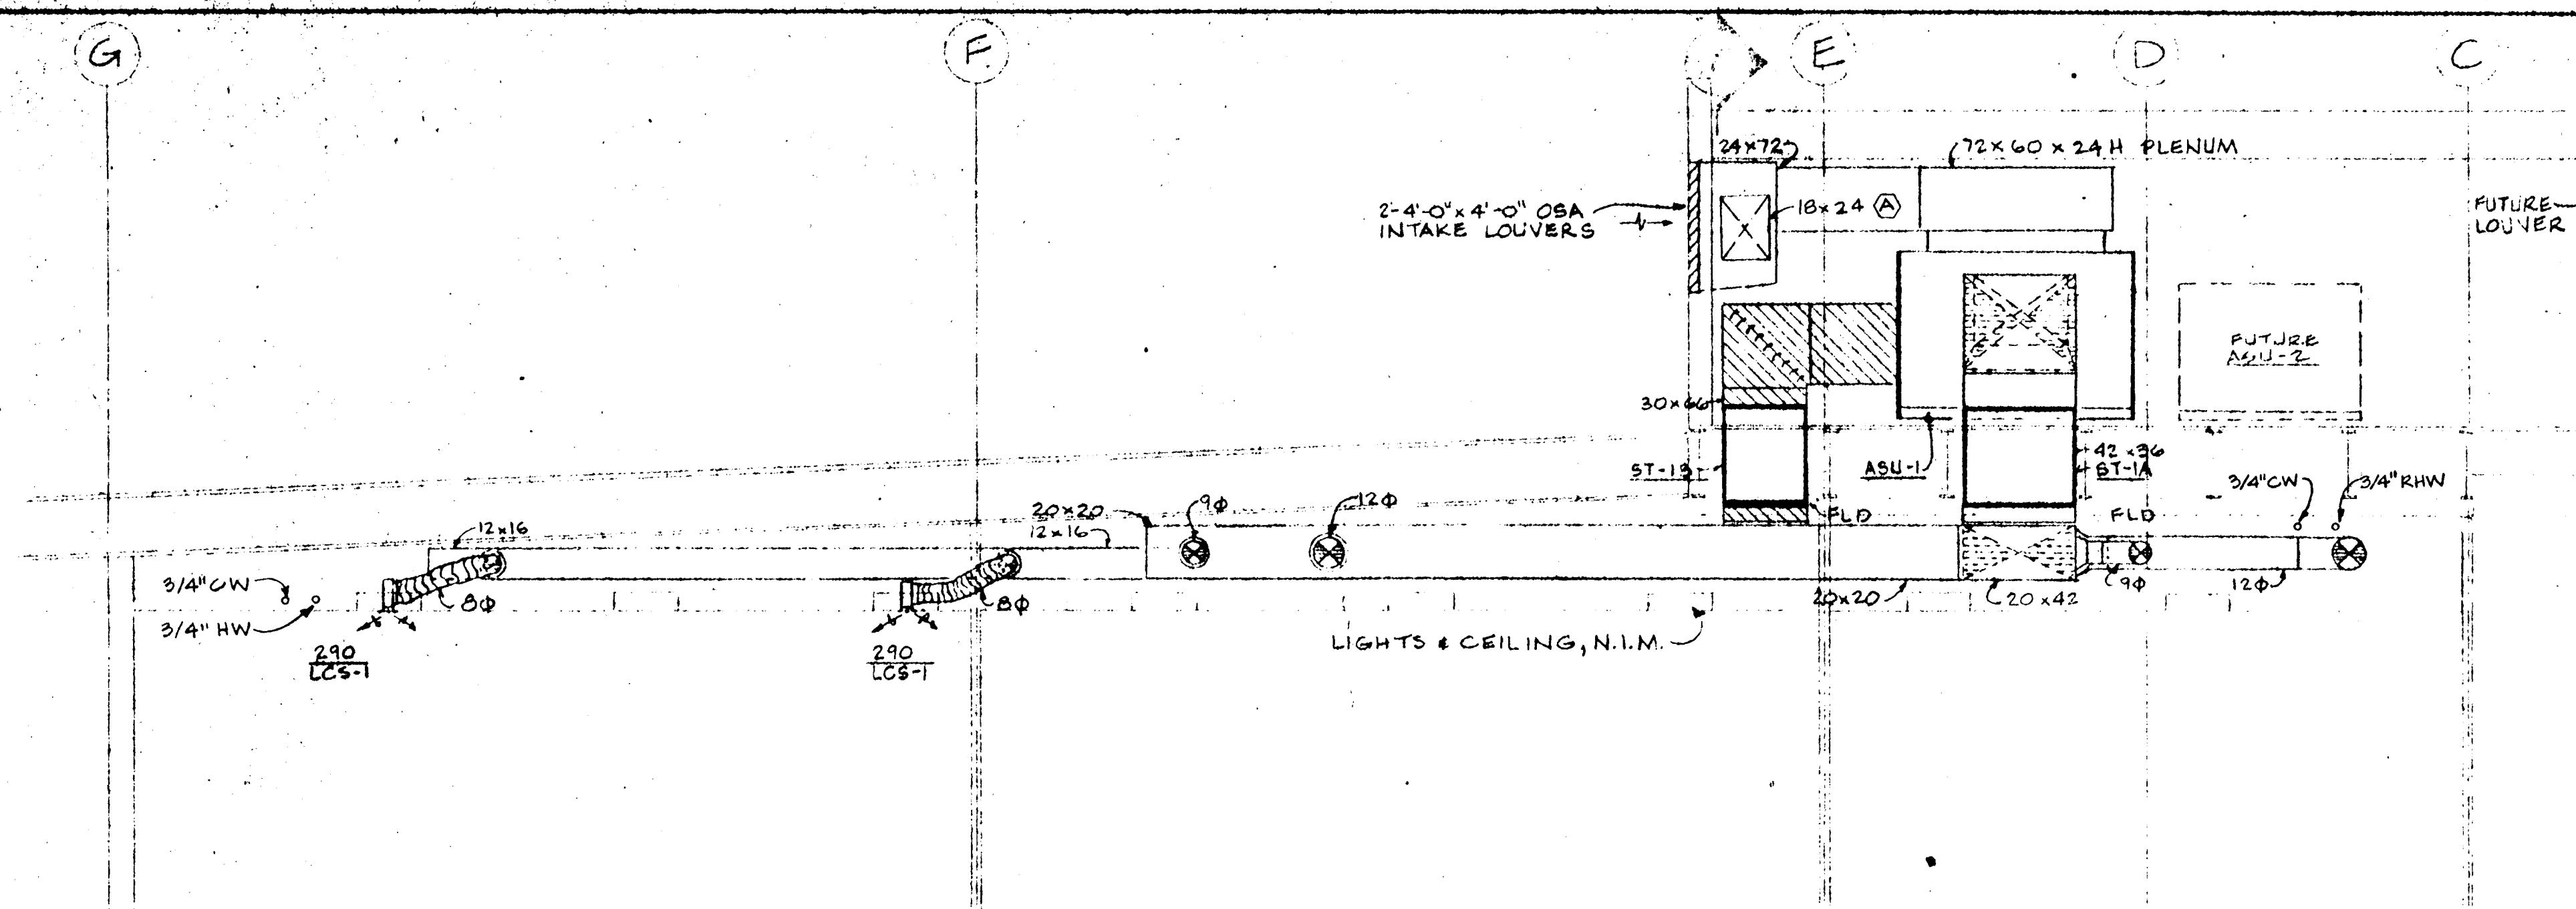

SECTION
1/4" = 1'-0"

SECTION
1/4" = 1'-0"

NOTE:
1. Provide Treated wood supports to give a level ASU installation.

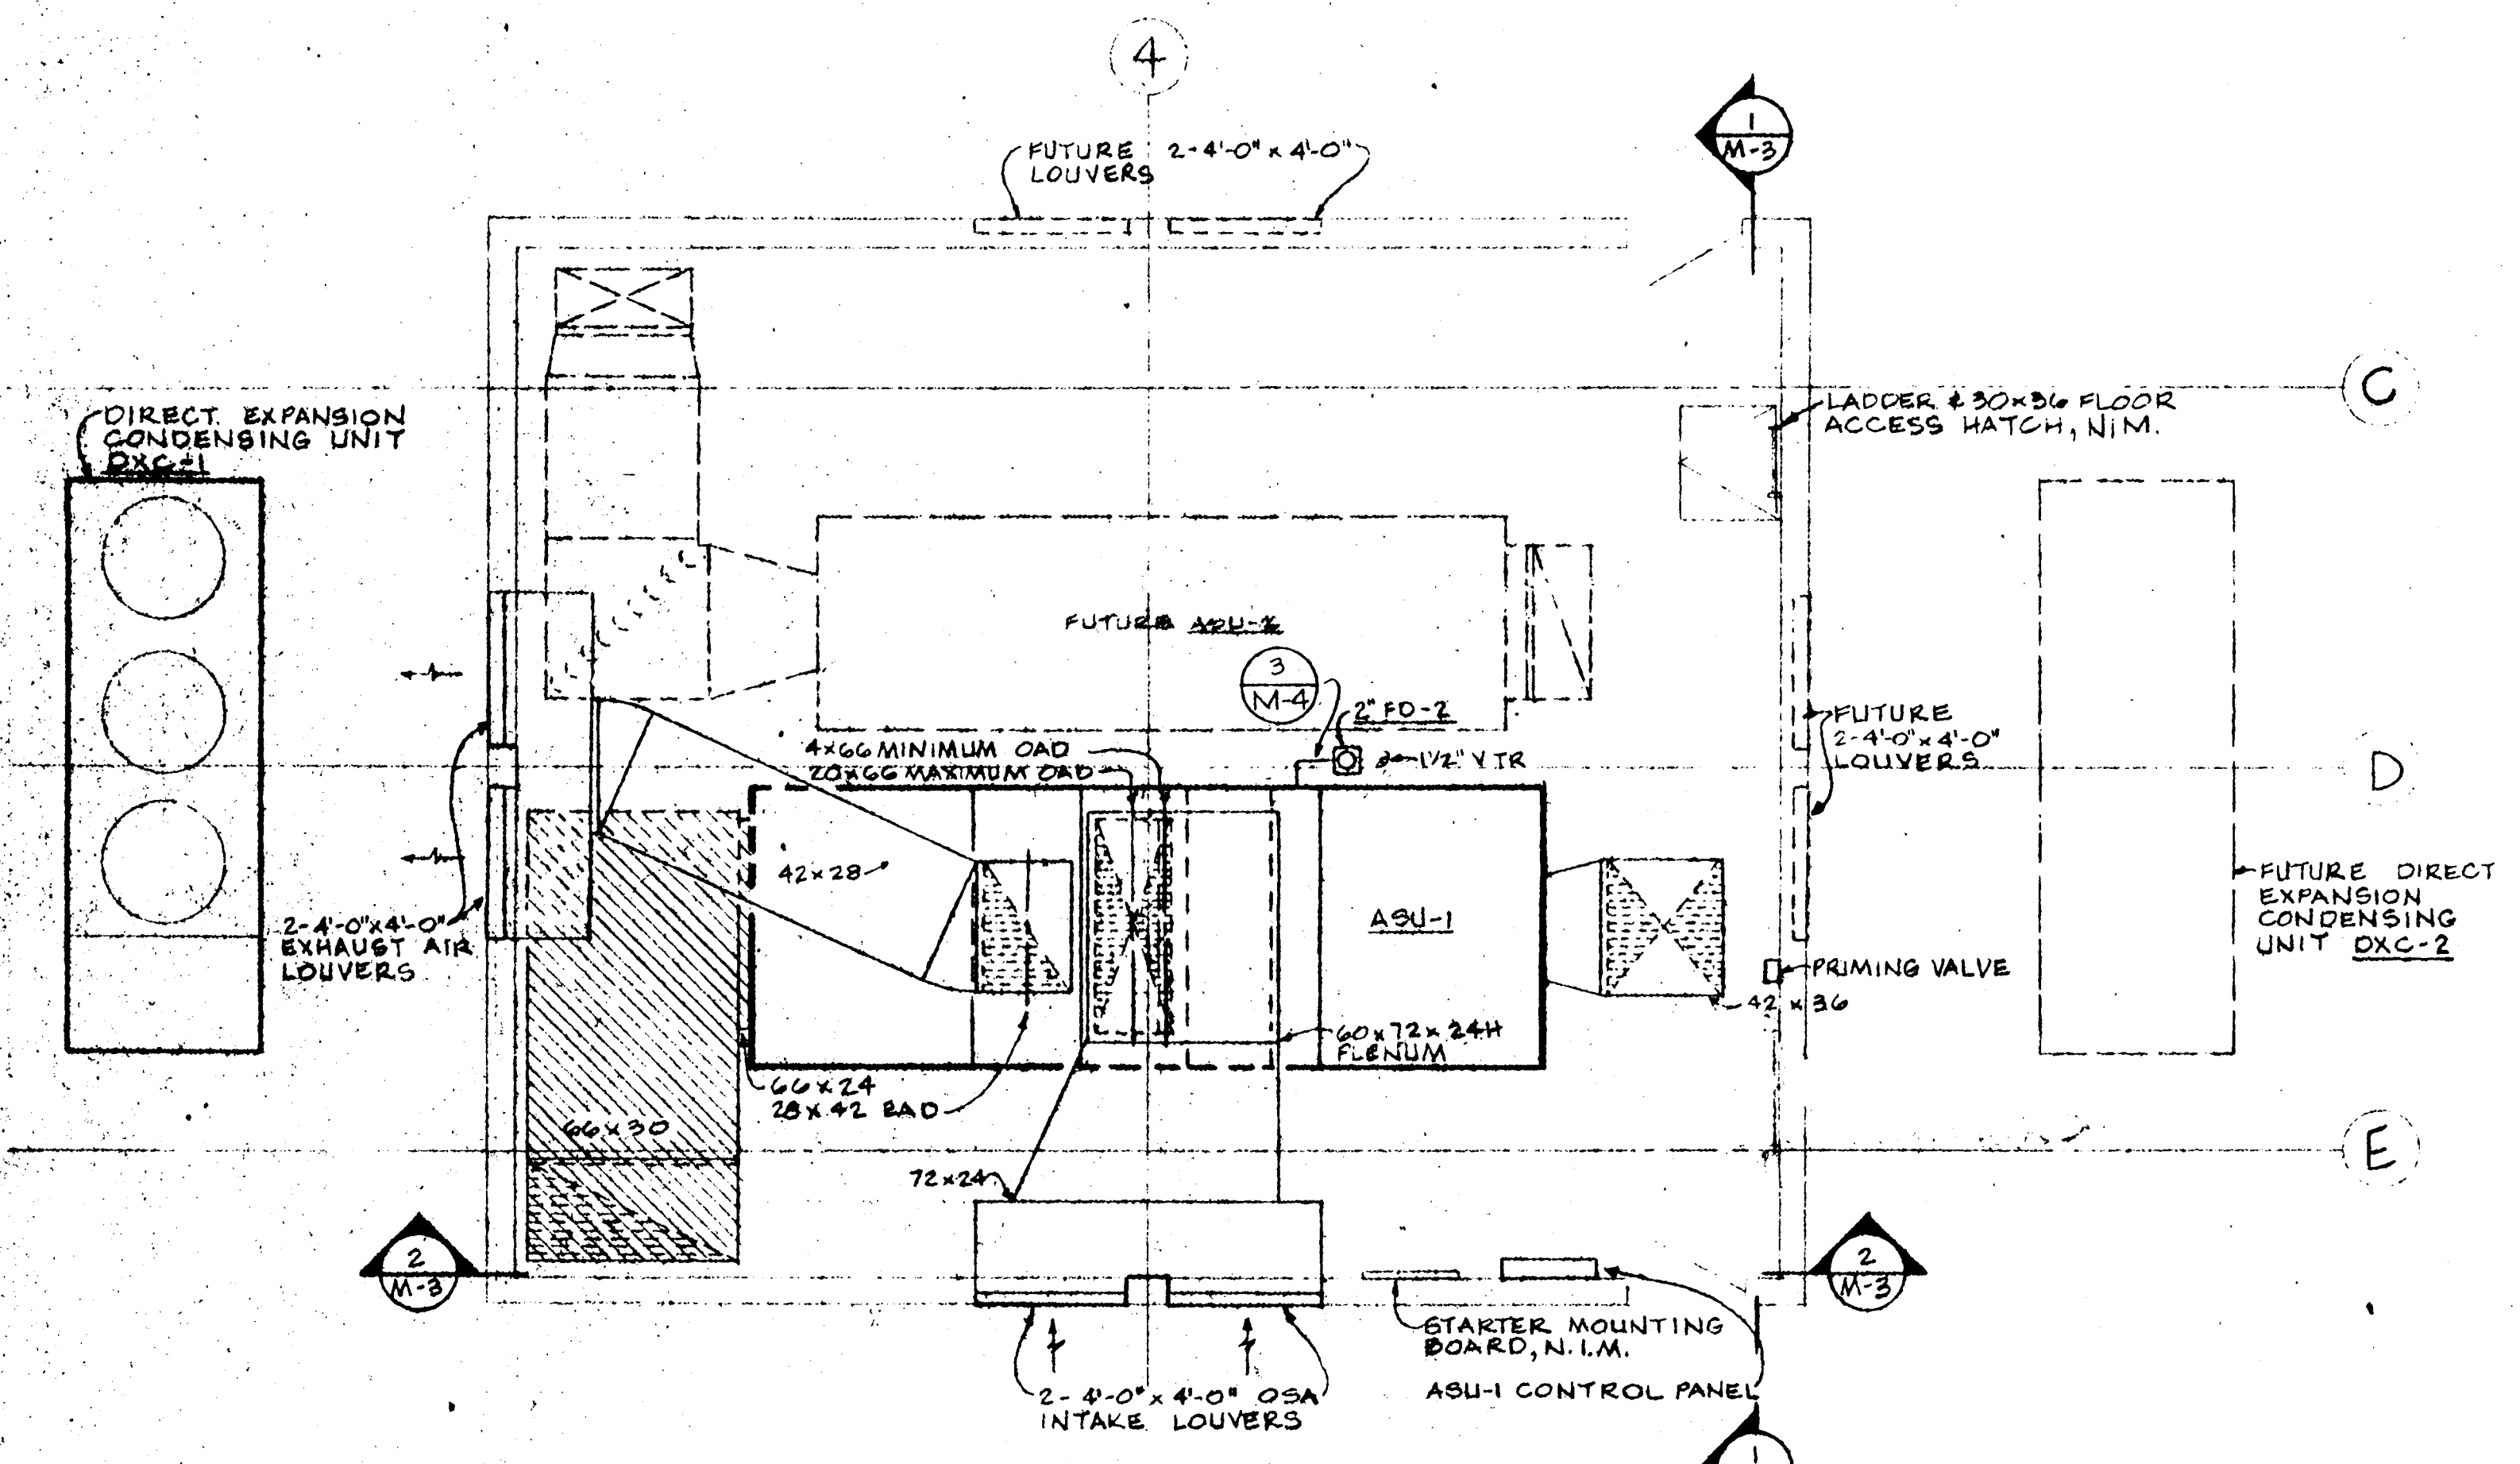




PLAN - MECHANICAL ROOM
1/4" = 1'-0"

PARTIAL MECH. PLAN & SECTIONS
WILLIAMS & GILHAM
ARCHITECTS - PLANNERS
13800 S.W. BROCKMAN RD. - BEAVERTON, OREGON


REGISTERED ARCHITECT
STATE OF OREGON
ROBERT B. WILLIAMS
13800 S.W. BROCKMAN RD. - BEAVERTON, OREGON 97005
1984

SIX CLASSROOM ADDITION
HITEON ELEMENTARY SCHOOL
SCHOOL DISTRICT NO. 48
13800 S.W. BROCKMAN RD. - BEAVERTON, OREGON

REVISION
DRAWN
CHK'D
COMM
FILE
DATE
SHEET NO.
M-3
59714

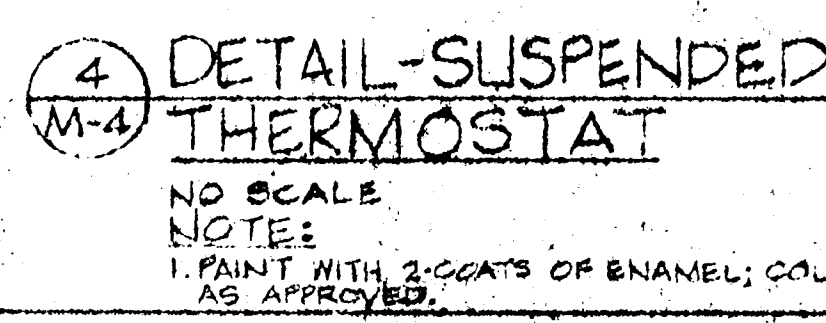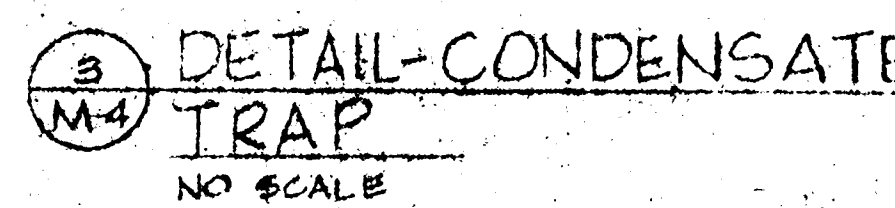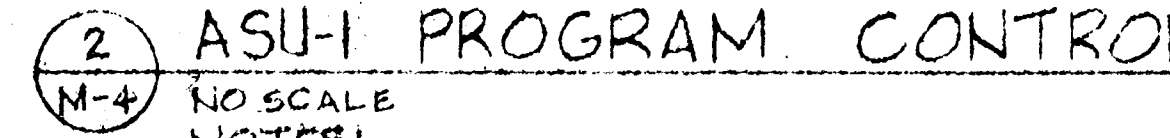

SYMBOL	MAX. CFM	DUCT SIZE	KW	STEPS
EDH-1	6000	42 x 20	17.5	2
EDH-2	6000	42 x 20	17.5	2

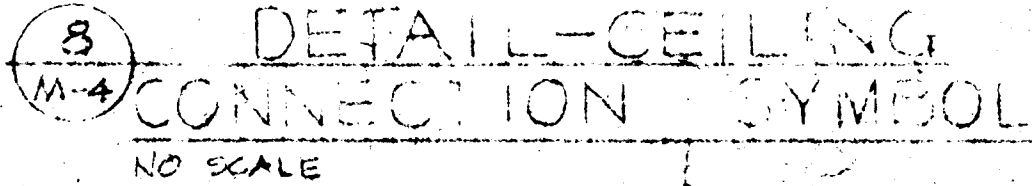


PLUMBING FIXTURE SCHEDULE						
MARK	FIXTURE	CONNECTION SIZES IN INCHES				REMARKS
		W	V	CW	HW	
WC-1	WATER CLOSET	3	2	3/4	-	
S-1	CLASSROOM SINK	2	2	1/2	1/2	FAUCET LEDGE ON RIGHT SIDE
S-2	SINK	2	2	1/2	1/2	DOUBLE COMPARTMENT
SS-1	SERVICE SUMP	3	2	1/2	1/2	
HB-1	HOSE BIBB	-	-	3/4	-	NON-FREEZE


GENERAL NOTES

- PIPE SIZES SHOWN ON CONNECTION SCHEDULES ARE INDIVIDUAL FIXTURE REQUIREMENTS. SIZE BRANCH WASTE & VENT PIPING ON ACCUMULATED FIXTURE WEIGHTS PER APPLICABLE PLUMBING CODE.
- PLUMBING DRAWINGS ARE GENERALLY DIAGRAMMATIC. VERIFY FIXTURE LOCATIONS & MOUNTING HEIGHTS W/ARCHITECTURAL DRAWINGS. VERIFY ROUGH-IN REQUIREMENTS PRIOR TO INSTALLING ANY FIXTURE OR EQUIPMENT FURNISHED BY OWNER.
- EXISTING UNDERGROUND PIPING LOCATIONS & FLOW LINES, GRADES, & DATUM ELEVATIONS ARE TAKEN FROM AVAILABLE RECORDS. CONTRACTOR TO VERIFY ALL CONDITIONS FOR CONNECTING TO EXISTING PIPING PRIOR TO CONSTRUCTION.


PLUMBING LEGEND

---	(E)W	EXISTING WASTE
---	(E)CW	EXISTING COLD WATER
---	(E)HW	EXISTING HOT WATER
---	(E)HWR	EXISTING HOT WATER RETURN
---	W	WASTE
---	V	VENT
---	CW	COLD WATER
---	HW	HOT WATER
---	HWR	HOT WATER RETURN
---		POINT OF CONNECTION, NEW TO EXISTING
---		BALL VALVE
(E)	EXISTING	
I.E.	INVERT ELEVATION	
SD	STORM DRAIN	
VTR	VENT THROUGH ROOF	
WCO	WALL CLEAN OUT	

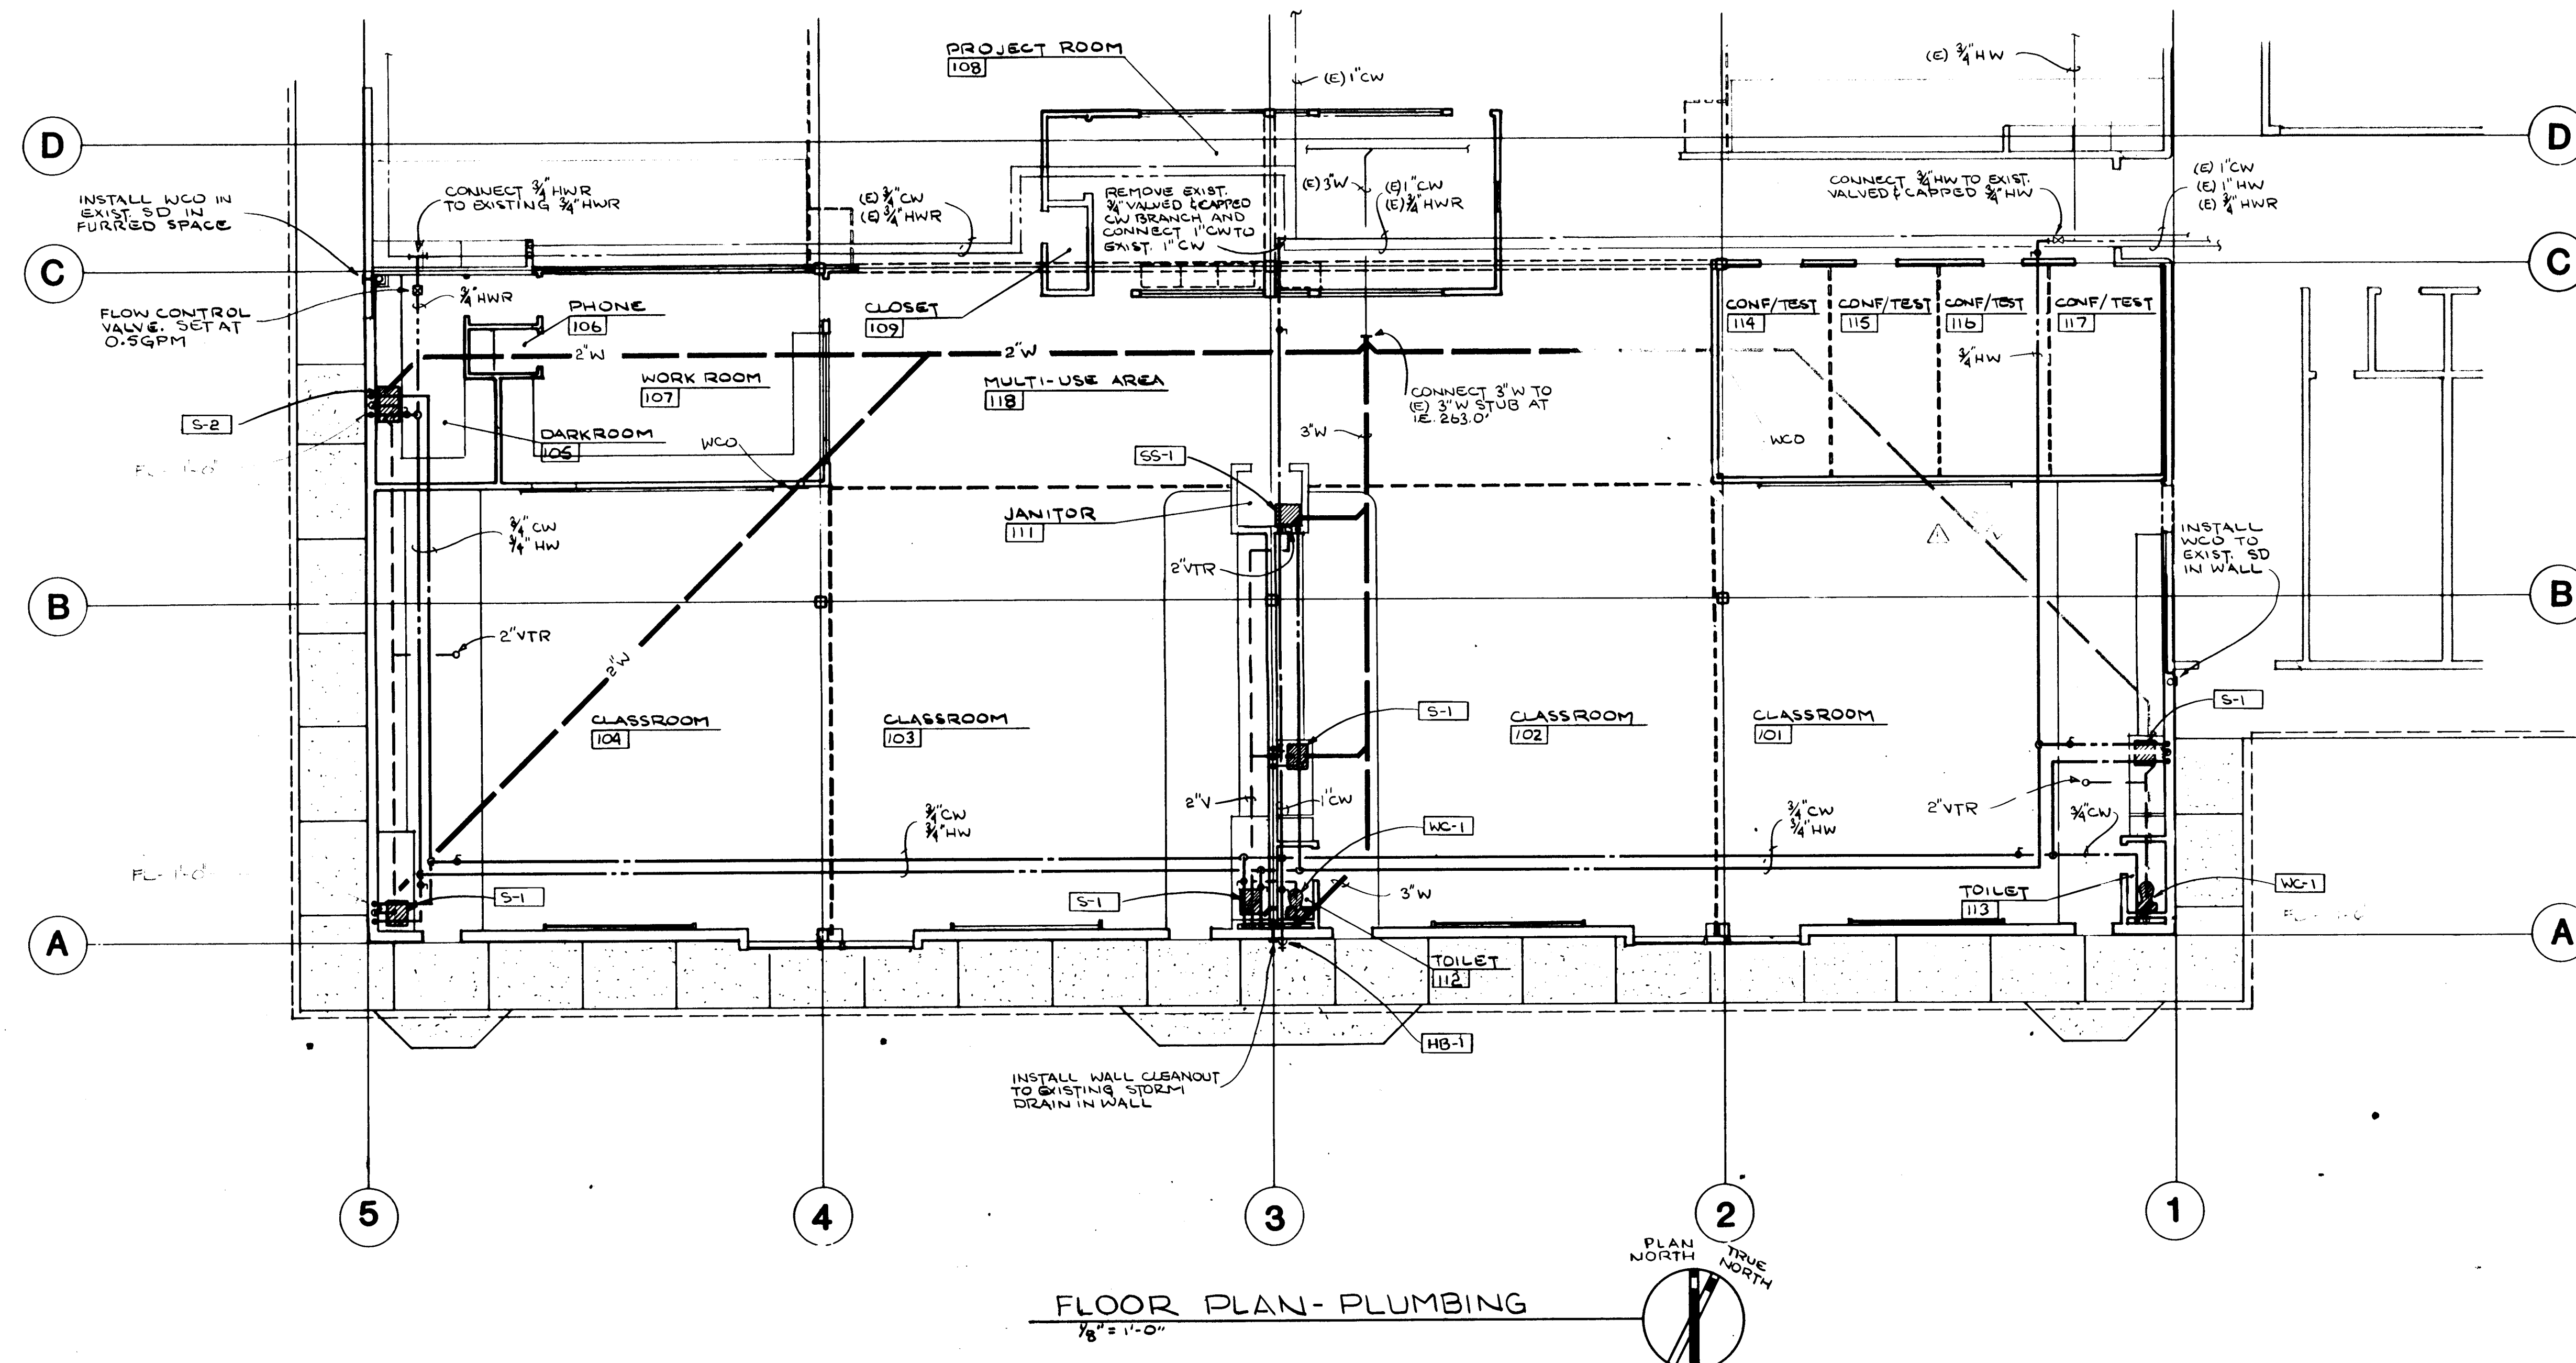


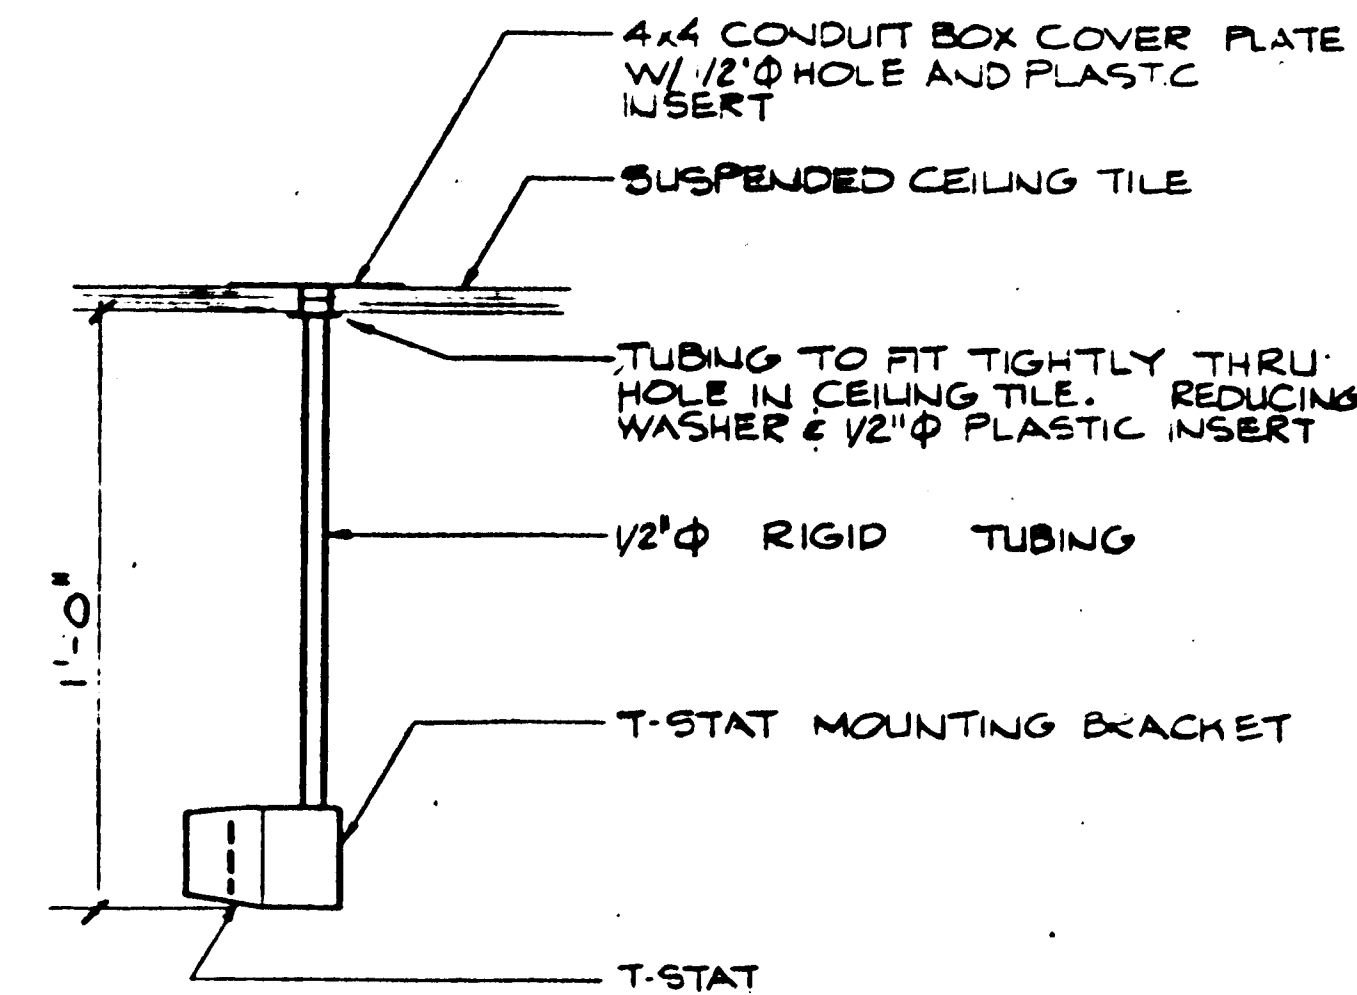

1 SUSPENDED THERMOSTAT
M2 SCALE: NONE

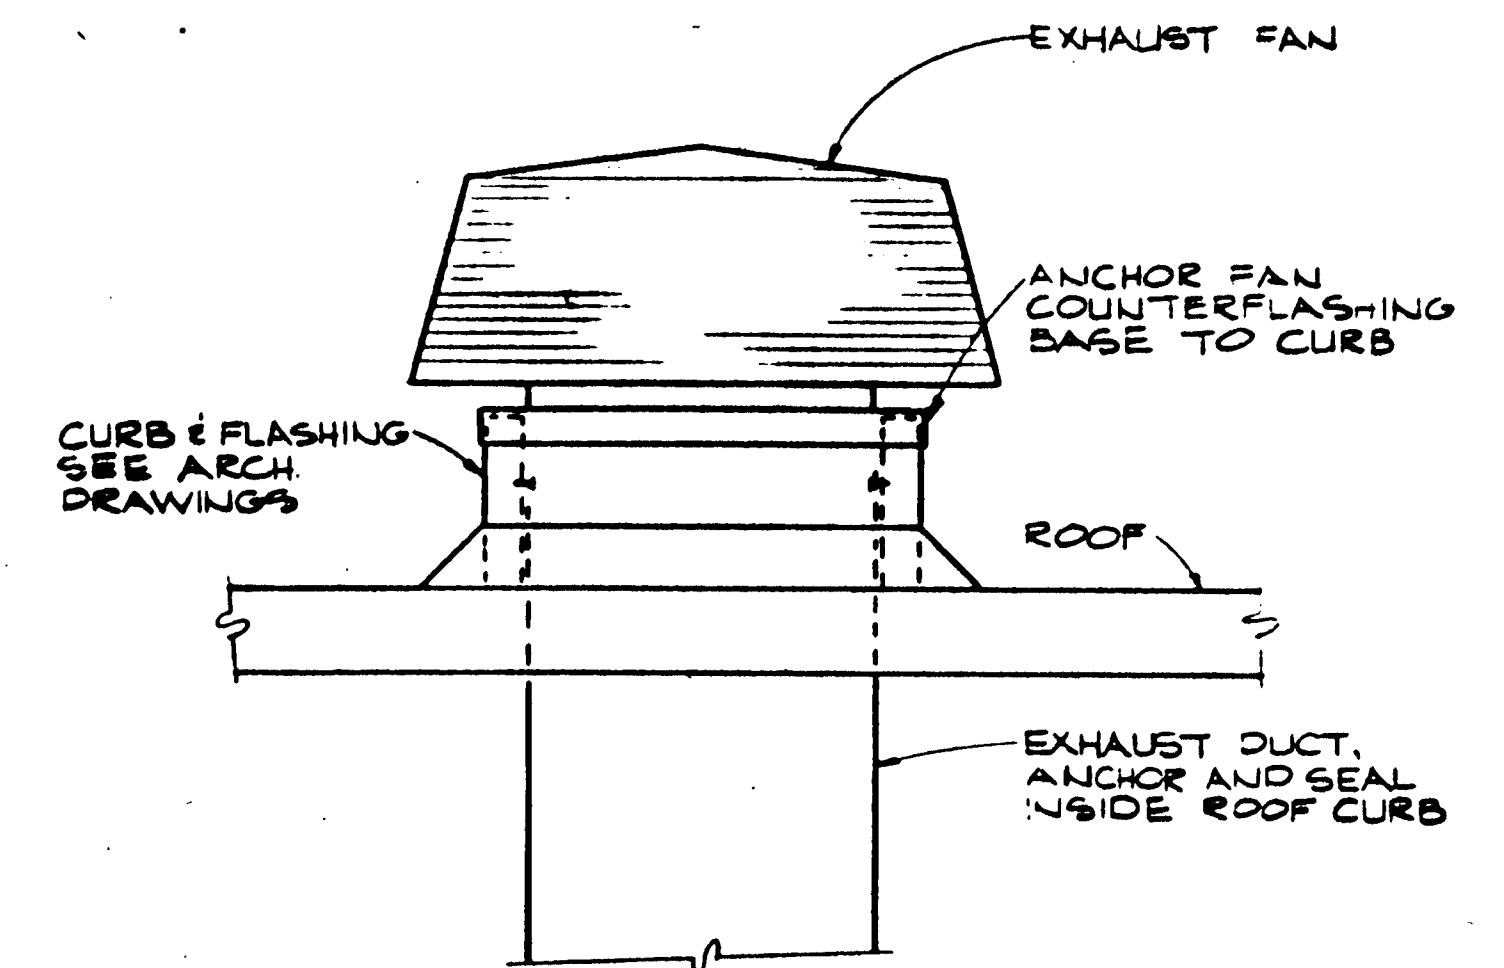

2 ROOF EXHAUST FAN
M2 SCALE: NONE

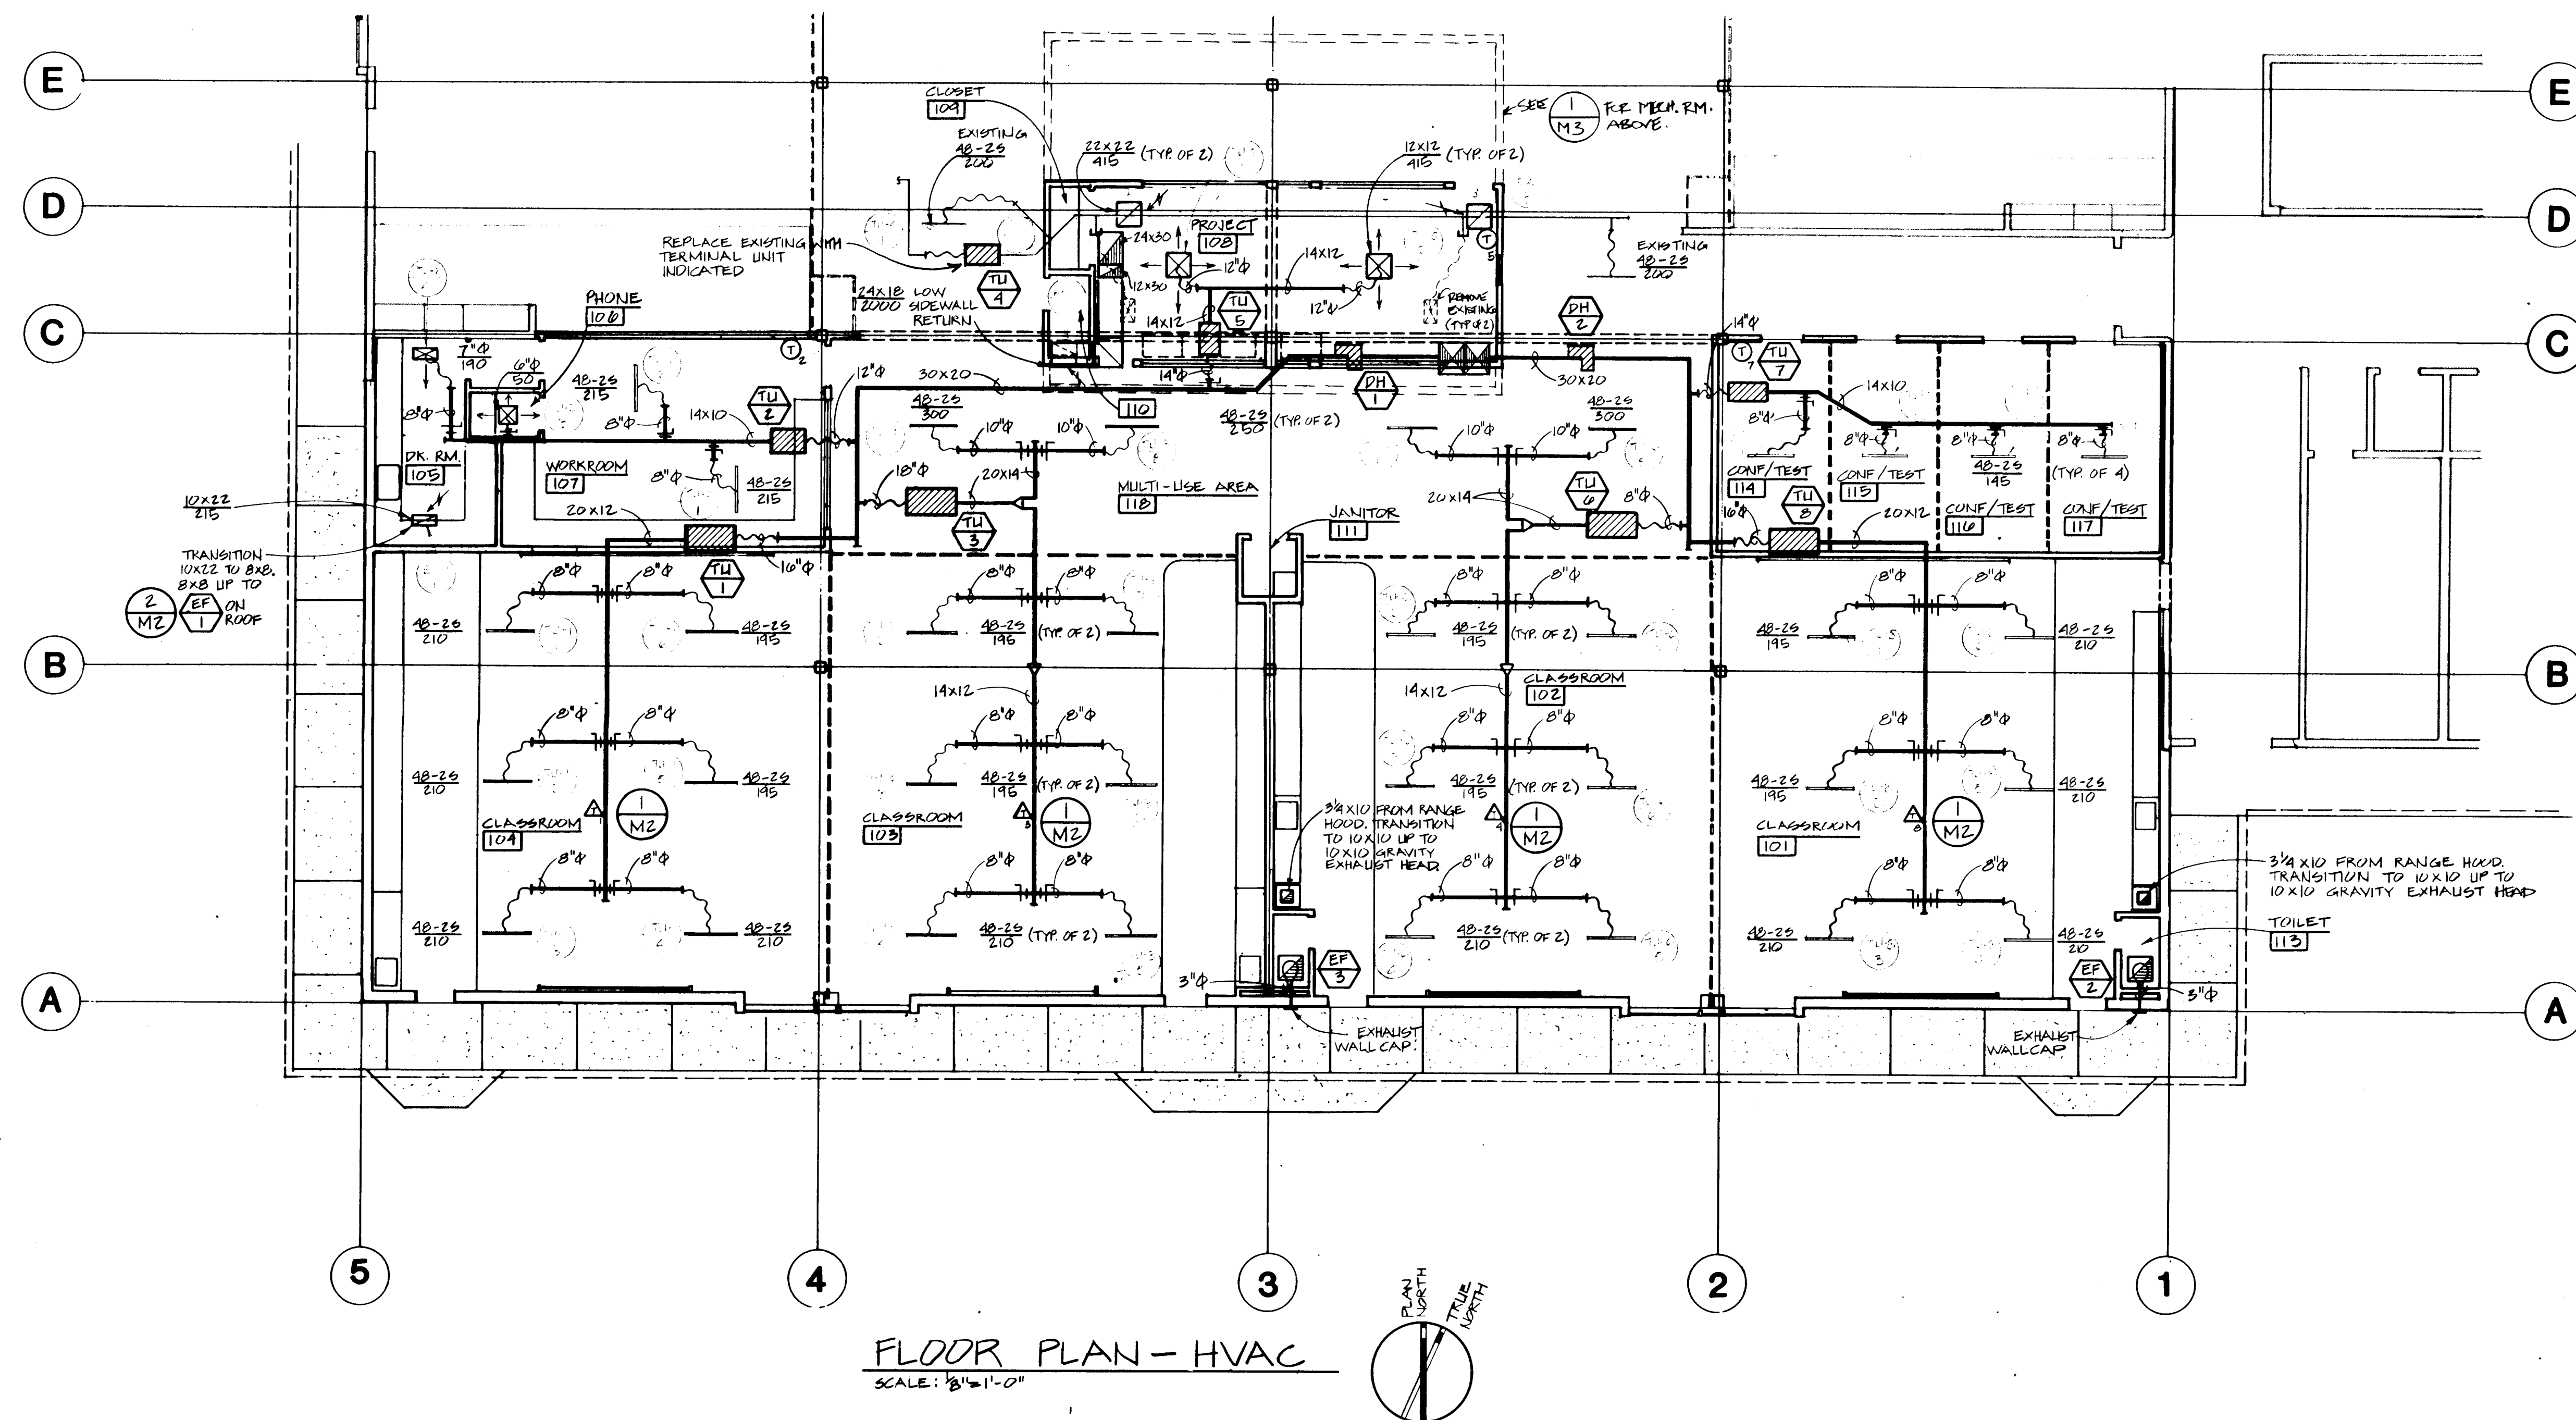


FLOOR PLAN - HVAC
SCALE: 1/8" = 1'-0"




12 MAY 1996
date
20-4-12
revised
JES

NOTES:
1. EXHAUST FAN CURB & FLASHING TO BE INSTALLED BY ROOFER.
2. EXHAUST FAN CURB & FLASHING TO BE INSTALLED BY ROOFER.
3. EXHAUST FAN CURB & FLASHING TO BE INSTALLED BY ROOFER.

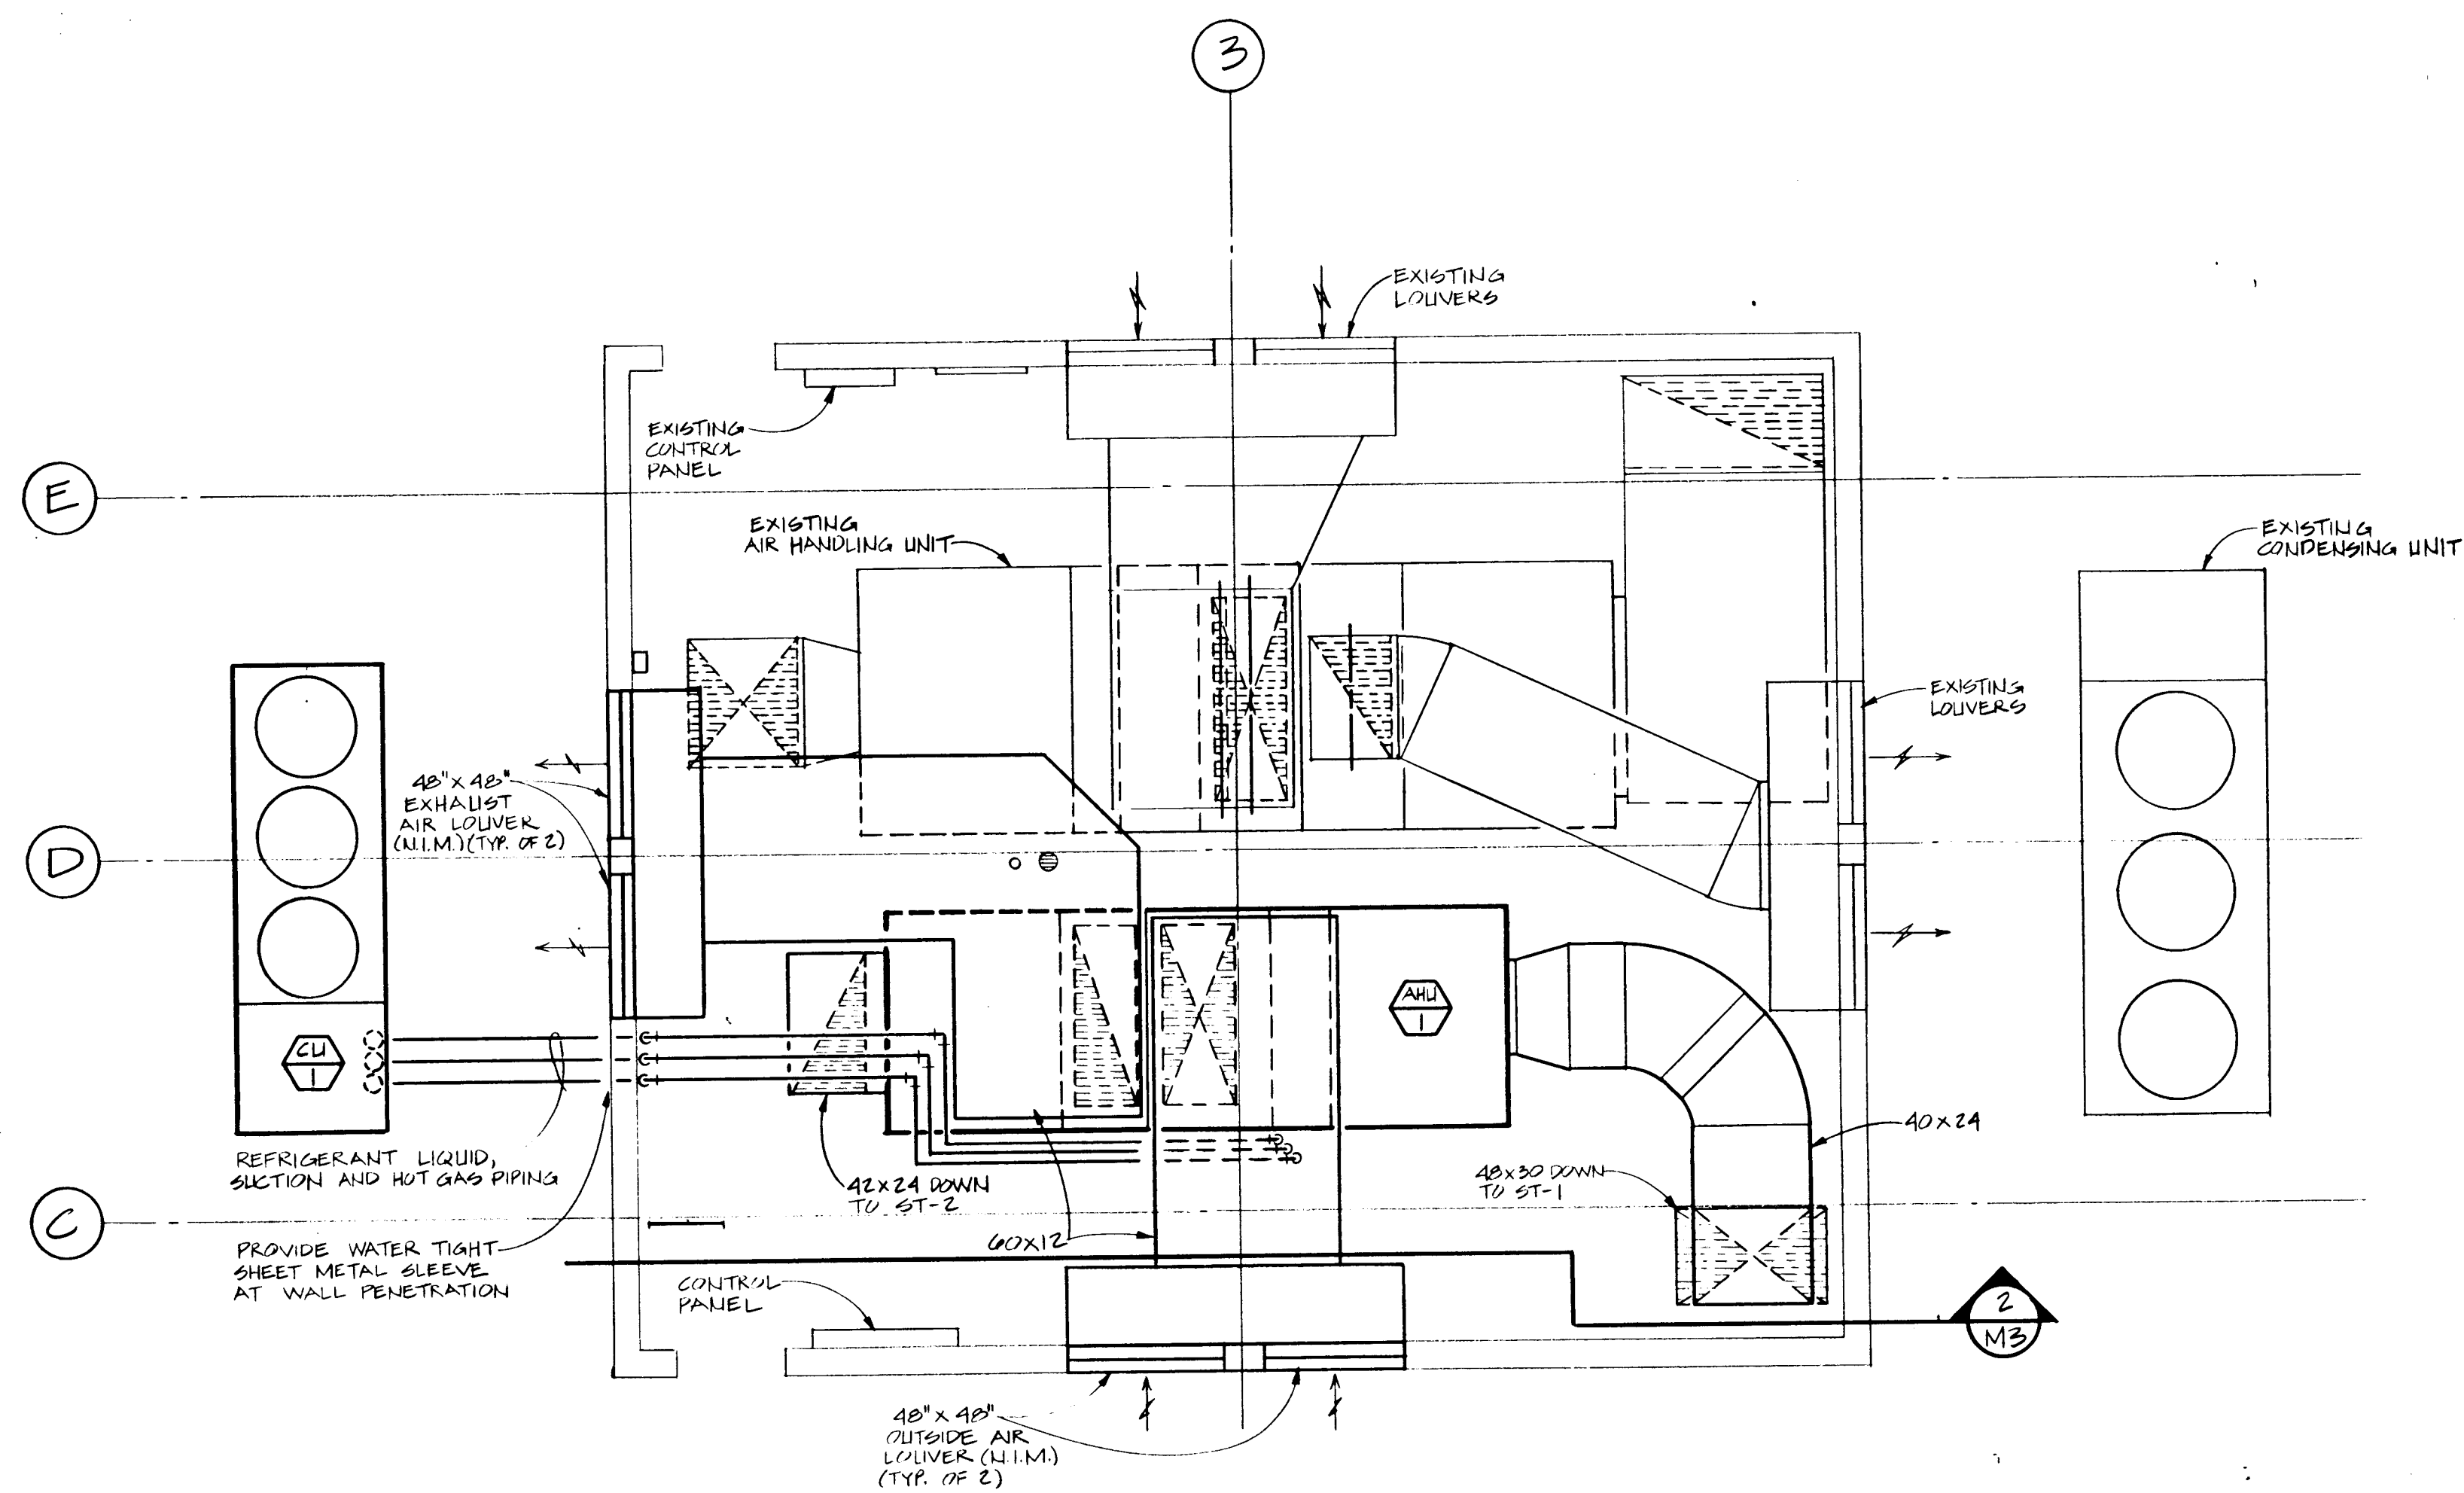

1 FLOOR PLAN - MECHANICAL ROOM
SCALE: 1/4" = 1'-0"

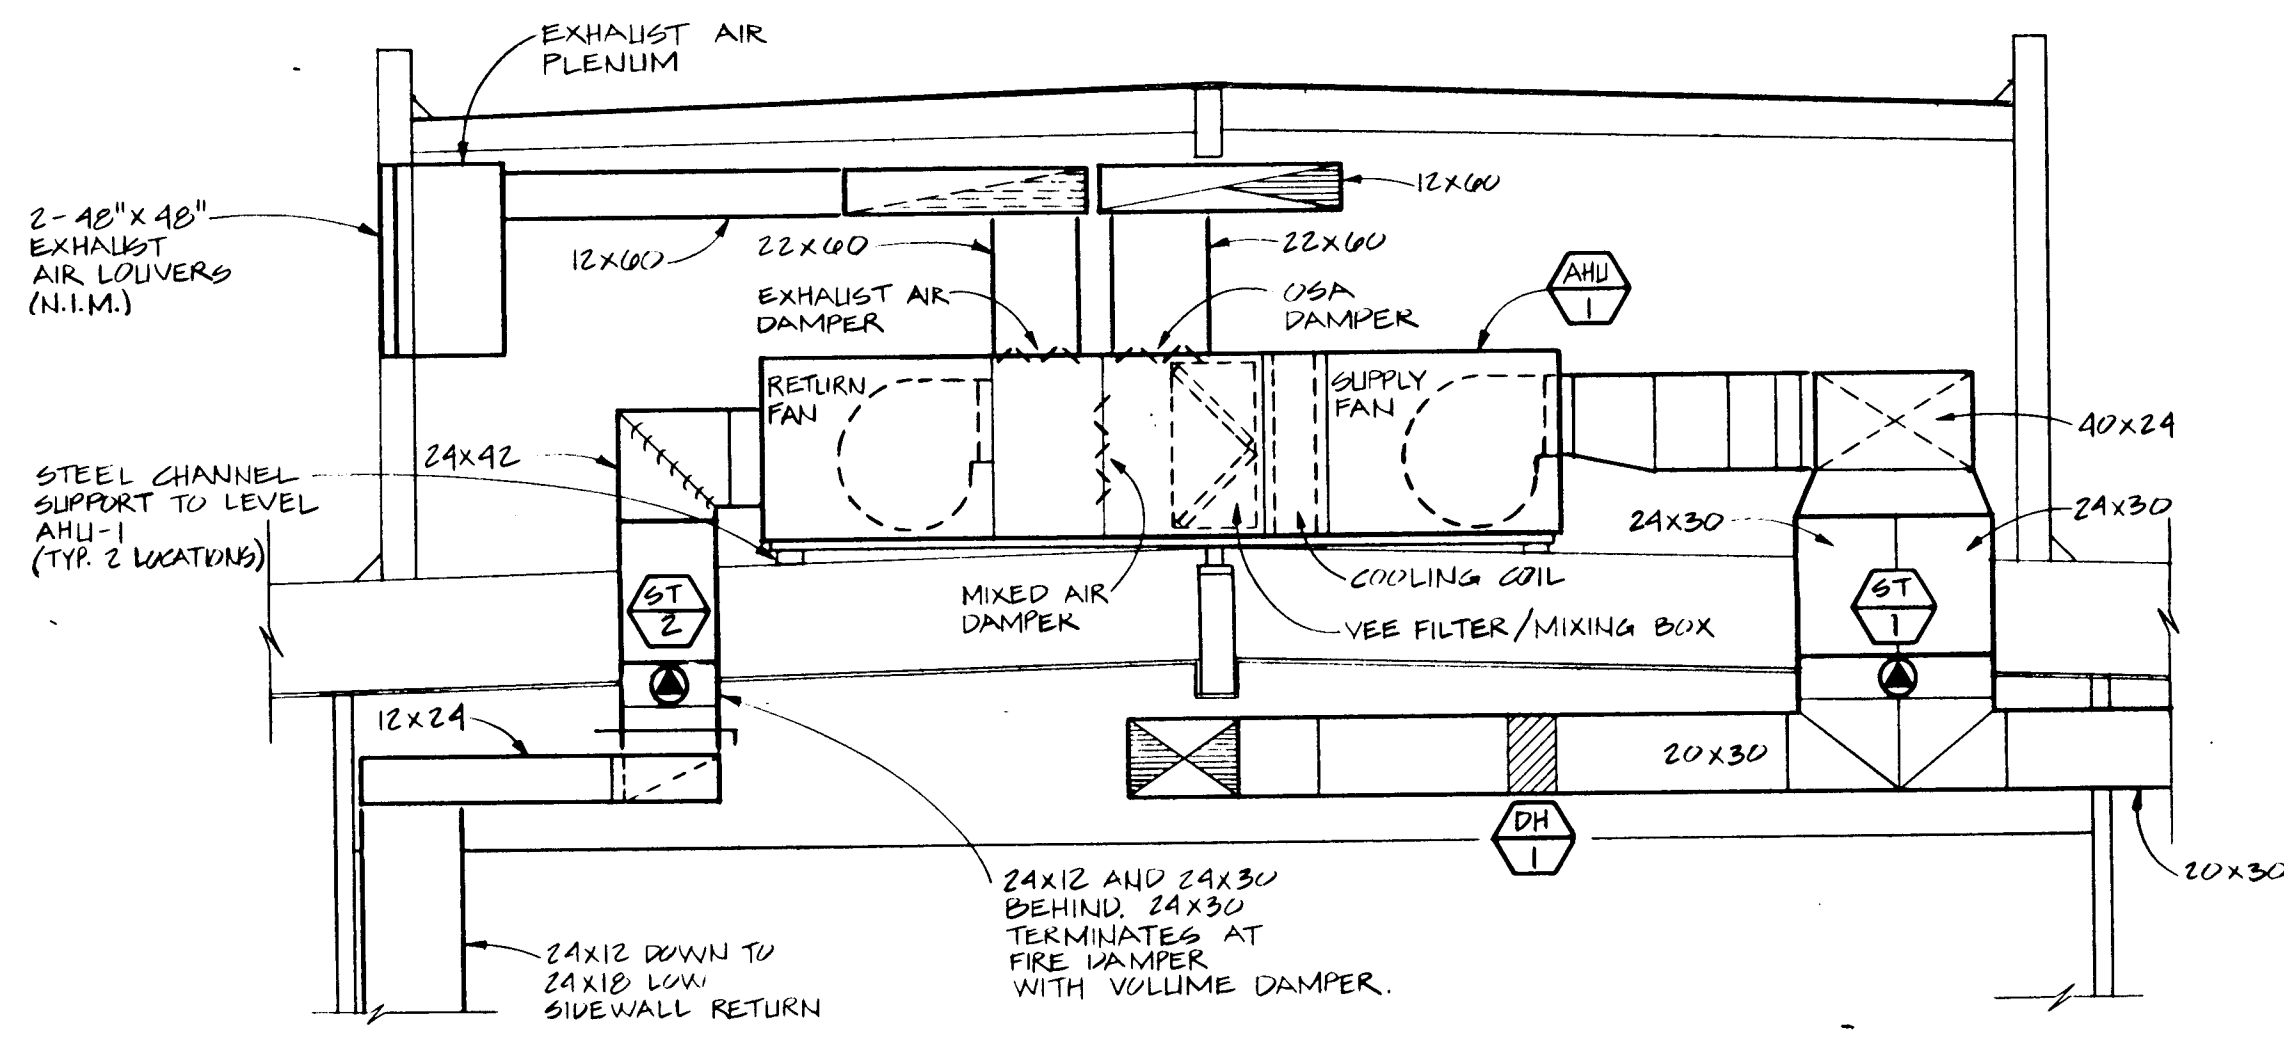

2 SECTION - MECHANICAL ROOM
SCALE: 1/4" = 1'-0"

MARK	DESCRIPTION
AHU-1	SUPPLY FAN: 8,030 CFM @ 2.25" STATIC PRESSURE, 1440 RPM, 20" DIAM. BACKWARD INCLINED AIR FOIL FAN WHEEL, 5 MOTOR H.P. RETURN FAN: 7,830 CFM @ .75" STATIC PRESSURE, 494 RPM, 20" DIAM. FORWARD CURVED FAN WHEEL, 3 MOTOR H.P. COOLING COIL: 8,030 CFM, 222 MBH TOTAL COOLING CAPACITY, 187 MBH SENSIBLE COOLING CAPACITY @ 76.2 DEGREE F. DB, 61.5 DEGREE F. WB EAT. 55 DEGREE F. DB, 52 DEGREE F. WB LAT. 40 DEGREE F. SAT SUC. TEMP. 4 ROW, 8 FPI. AIR PRESS. DROP = .55" S.P. COOLING COIL TO OPERATE IN CONJUNCTION WITH CU-1. FILTERS: 4 - 20" x 25", 8 - 20" x 20" FILTERS. TOTAL 36.1 SQ. FT. FACE AREA. (PRE-PURCHASED BY OWNER)
CU-1	AIR-COOLED-CONDENSING UNIT: MINIMUM 222 MBH COOLING CAPACITY @ 40 DEGREE F. SATURATED SUCTION TEMPERATURE AND 100 DEGREE F. CONDENSER ENTERING AIR TEMPERATURE. CU-1 TO OPERATE IN CONJUNCTION WITH AHU-1 COOLING COIL WITH TWO STAGE COOLING OPERATION.
EF-1	ROOF MOUNTED EXHAUST FAN: 210 CFM @ .375" ESP. 6 3/4" FORWARD CURVED FAN WHEEL, 1111 RPM, 1/4 MOTOR H.P.
EF-2	CEILING MOUNTED EXHAUST FAN: 70 CFM. BROAN 671. PROVIDE BROAN 640 WALL CAP.
DH-1	ELECTRIC DUCT HEATER: 15.0 KW, 30" x 20", FOUR STAGE.
DH-2	ELECTRIC DUCT HEATER: 12.5 KW, 30" x 20", FOUR STAGE.
ST-1	SOUND TRAP: 2 - 24" x 30" MODULES, 8030 CFM, 803 FPM, .15" STATIC PRESSURE DROP. IAC 3ES.
ST-2	SOUND TRAP: 1 - 42" x 24" MODULE, 1 - 42" x 12" MODULE, 7820 CFM, 745 FPM, .125" STATIC PRESSURE DROP. IAC 3ES.
TU-1	TERMINAL UNIT, VAV RELIEF TYPE: 1230 CFM, 1200 CFM MIN - 1800 CFM MAX, 14"0 INLET.
TU-2	TERMINAL UNIT, VAV RELIEF TYPE: 620 CFM, 600 CFM MIN - 900 CFM MAX, 10"0 INLET.
TU-3	TERMINAL UNIT, VAV RELIEF TYPE: 1750 CFM, 1600 CFM MIN - 2400 CFM MAX, 16"0 INLET.
TU-4	TERMINAL UNIT, VAV RELIEF TYPE: 580 CFM, 400 CFM MIN - 600 CFM MAX, 9"0 INLET.
TU-5	TERMINAL UNIT, VAV RELIEF TYPE: 830 CFM, 800 CFM MIN - 1200 CFM MAX, 12"0 INLET.

HVAC LEGEND

SA SUPPLY AIR

RA/EA RETURN AIR OR EXHAUST AIR

OSA OUTSIDE AIR

MITERED ELBOW

MITERED TEE

MITERED OFFSET

REDUCER

ELECTRIC DUCT HEATER

TERMINAL UNIT

VOLUME DAMPER

FIRE DAMPER

CEILING MOUNTED SUPPLY DIFFUSER

CEILING MOUNTED RETURN OR EXHAUST GRILLE OR REGISTER

LINEAR SLOT DIFFUSER & BOOT

WALL MOUNTED THERMOSTAT

SUSPENDED THERMOSTAT

N.I.M. NOT IN MECHANICAL

SPIN-IN FITTING TAKE OFF WITH VOLUME DAMPER

FLEXIBLE DUCT CONNECTION

(LENGTH, INCHES - NUMBER OF SLOTS) (CFM)

42-22 210



1/2 MAY 1992
date
revised 8-14-92
job no.